


Appendix H
Preliminary Foundation Report



**PRELIMINARY FOUNDATION REPORT
SAN FRANCISCO OAKLAND BAY BRIDGE
BICYCLE/PEDESTRIAN CONNECTION
OAKLAND, CALIFORNIA**

Prepared for:
TY Lin International

November 2014
Fugro Project No. 04.72130012

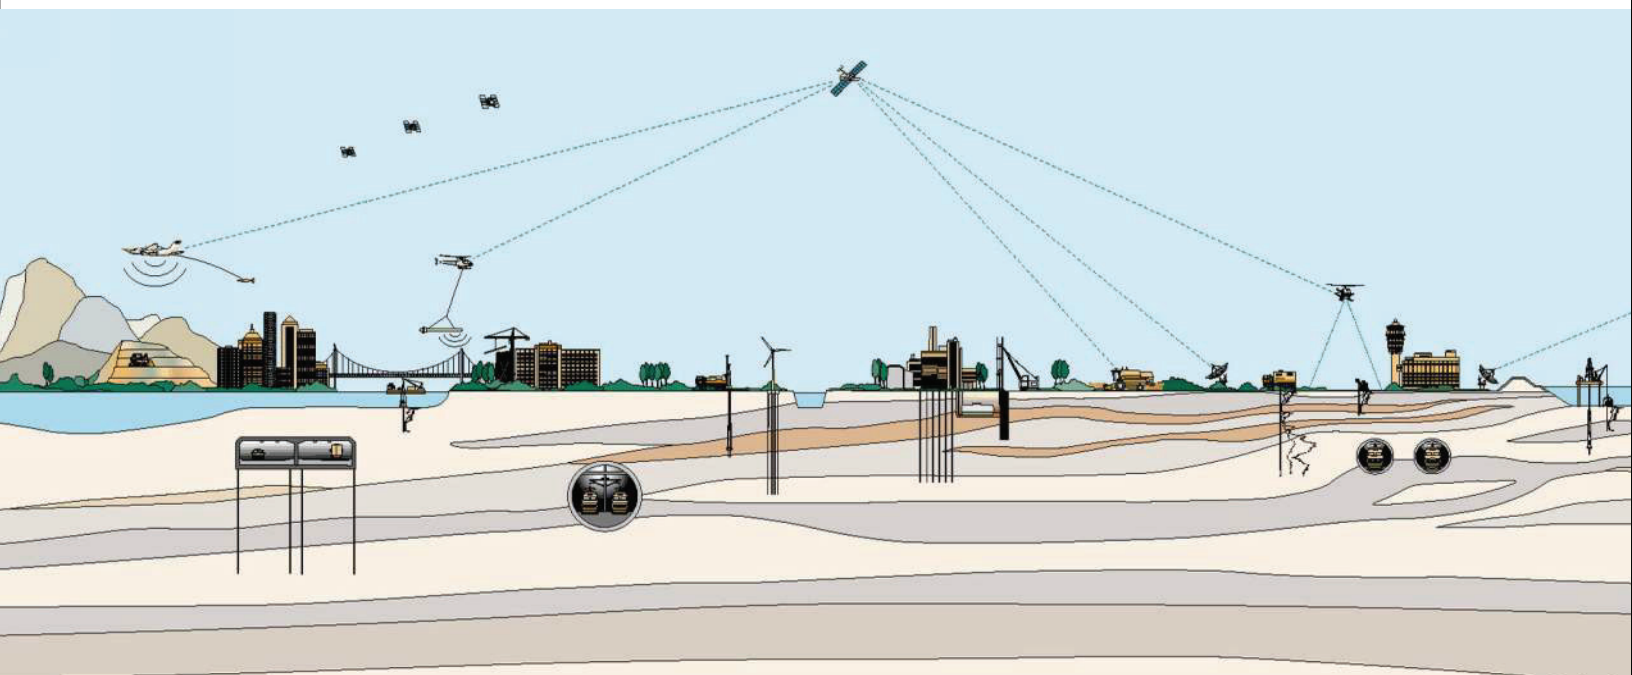



1000 Broadway, Suite 440
Oakland, California 94607
Tel: (510) 268-0461
Fax: (510) 268-0545

November 14, 2014
Project No. 04.72130012

TY Lin International
1111 Broadway, Suite 2150
Oakland, California 94607

Attention: Ms. Eva Lillie

Subject: Preliminary Foundation Report, San Francisco Oakland Bay Bridge
Bicycle /Pedestrian Connection
Oakland, California

Dear Ms. Lillie:

Fugro Consultants, Inc. is pleased to present this revised Preliminary Foundation Report (PFR) for the proposed San Francisco Oakland Bay Bridge Bicycle / Pedestrian Connection (Path) Project in Oakland, California. We have updated our report in accordance with the Caltrans reviewer's comments dated October 8, 2014. Our findings, opinions, conclusions and recommendations are based on applicable standards of our profession at the time this report was prepared.

We thank you for the opportunity to be of service to TY Lin International. If you should have any questions or require additional information on this PFR, please call the undersigned at (510) 267-4422.

Sincerely,

FUGRO CONSULTANTS, INC.

A handwritten signature in blue ink, appearing to read "Timothy Wong".

Timothy Chi-To Wong, P.E., G.E.
Associate Engineer

A handwritten signature in blue ink, appearing to read "W. Andrew Herlache".

W. Andrew Herlache, P.E., G.E.
Senior Principal Engineer

CTW/WAH:afp

Copies Submitted: (3) Addressee and pdf file on CD

CONTENTS

	Page
1.0 INTRODUCTION.....	3
2.0 PURPOSE AND SCOPE OF USE	3
3.0 PROPOSED STRUCTURE.....	3
3.1 Segment 1 - At-Grade Connection to Mandela Parkway	4
3.2 Segment 2 - Separate Elevated Structure East	4
3.3 Segment 3 - West Grand Avenue Overcrossing	4
3.4 Segment 4 - Separate Elevated Structure West	4
3.5 Segment 5 - At-Grade Connection to Bay Bridge Trail	5
3.6 Class II Bike Lanes.....	5
4.0 PERTINENT REPORTS	5
5.0 GEOLOGIC AND SEISMOTECTONIC SETTING	6
5.1 Regional Geology.....	6
5.2 Local Geology	6
5.3 Seismotectonic Setting.....	7
6.0 SITE AND SUBSURFACE CONDITION.....	8
6.1 Site Conditions	8
6.2 Subsurface Conditions	9
6.2.1 Fill (Elevations 10 to -10 feet).....	9
6.2.2 Young Bay Mud (Elevations +5 to -60 feet).....	9
6.2.3 San Antonio Formation (Elevation -10 to -40 feet)	10
6.2.4 Old Bay Clay (Elevations -25' to maximum depth explored)	10
6.2.5 Groundwater Conditions:.....	10
7.0 GEOLOGIC AND SEISMIC HAZARDS	11
7.1 Fault Rupture.....	11
7.2 Strong Ground Shaking.....	11
7.3 Liquefaction.....	11
7.4 Landslide and Slope Failure.....	12
7.5 Flood 12	
7.6 Scour 12	
7.7 Corrosion.....	13
8.0 SEISMIC DESIGN CRITERIA.....	13
8.1 Seismic Design Methodology	13
8.2 Site Soil Profile.....	14
8.3 Fault Type and Near-Field Spectral Accelerations.....	14
8.4 Design Acceleration Response Spectrum.....	15



9.0	GEOTECHNICAL RECOMMENDATIONS	16
9.1	Foundation Alternatives.....	16
9.2	Design Soil Parameters.....	17
9.3	Cast-In-Drilled Hole Piles	18
9.4	Construction Considerations	20
10.0	ADDITIONAL FIELD INVESTIGATION AND LABORATORY TESTING	20
11.0	LIMITATIONS.....	21
12.0	REFERENCES.....	22

TABLES

Table 1.	Major Active Faults in the Project Vicinity	8
Table 2.	Spectral Acceleration Values	15
Table 3.	Generalized Soil Design Parameters.....	17
Table 4.	Proposed CIDH Pile Data Tables	19

PLATES

	Plate
Site and Boring Location Plans (Overall)	1a
Site and Boring Location Plans (Path)	1b
Idealized Subsurface Profile F-F'	2a
Idealized Subsurface Profile G-G'	2b

FIGURES

	Figure
Vicinity Map.....	1
Quaternary Geologic Map.....	2
Major Active Fault Map	3
Alquist-Priolo Earthquake Fault Zone	4
Liquefaction Susceptibility in the Project Vicinity	5
Recommended Acceleration Response Spectrum	6
Variation of CIDH Pile Capacity with Pile Length.....	7

APPENDICES

APPENDIX A	PROJECT LAYOUT PLANS
APPENDIX B	BORING LOGS FROM PREVIOUS INVESTIGATIONS
APPENDIX C	LIQUEFACTION SETTLEMENT
APPENDIX D	CORROSION TEST RESULTS BY OTHERS

1.0 INTRODUCTION

This report presents the results of a preliminary geotechnical study prepared by Fugro for the San Francisco Oakland Bay Bridge Bicycle /Pedestrian Connection (Path) Project in Oakland, California (Vicinity Map, Figure 1). Fugro completed this Preliminary Foundation Report (PFR) on behalf of TY Lin International (TY Lin) and the Gateway Park Working Group, which is composed of nine local, regional, and state agencies including Bay Area Transit Authority (BATA), Caltrans, San Francisco Bay Conservation and Development Commission (BCDC), Alameda County Transportation Commission (CTC), East Bay Regional Park District (EBRPD), City of Oakland, Port of Oakland, East Bay Municipal District (EBMUD) and Association of Bay Area Governments' (ABAG) Bay Trail Project.

The Connection is part of the larger Gateway Park Project (Site Plan, Plate 1a) which encompasses five development areas located near the Oakland-touchdown of the new eastern span of the Bay Bridge. The five development areas are known as Key Point, Port Playground, Windbreak, Bridgeyard, and Radio Beach. These areas along with a sixth area known as Landscaping are presented in a separate report. The Connection project includes of a bicycle /pedestrian path (Class I¹) divided into five segments. The five segments include an at-grade connection to Mandela Parkway, a separate elevated structure to the east, a West Grand Avenue overcrossing (including a Class III³ section), a separate elevated structure to the west, and an at-grade connection to the Bay Bridge Trail. Future improvements could include: 1) a gravel parking lot (about 100 parking spaces) west of Wood Street (between 24th Street and West Grand Avenue), 2) landscaping areas, 3) an art statue by Mandela Parkway, and 4) a bike path (Class II²) at-grade near the eastern end of the project. These other improvements (including the at-grade connection to Mandela Parkway) will be discussed in the preliminary Geotechnical Design Report (GDR).

2.0 PURPOSE AND SCOPE OF USE

The purpose of this PFR is to summarize previous field investigations and subsurface conditions in the project vicinity, evaluate the seismic hazard conditions, make preliminary foundation recommendations, and identify the need for additional geotechnical investigations or studies for the proposed project.

3.0 PROPOSED STRUCTURE

Based on the layout plan dated June 5, 2014 (Appendix A), the proposed multi-span bicycle/pedestrian path structures are about 1.14 mile long in total length including the at grade segment which is about 450 feet long. According to TY Lin, the elevated structures (except part of Segment 3) are planned to be supported by Cast-In-Drilled Hole (CIDH) piles that are approximately 6 to 7 feet in diameter. The bicycle/pedestrian path has been divided into the five segments described below from east to west.

¹ Class I bikeways (bike paths) are separate paths with exclusive right of way for bicycles and pedestrians, with minimal vehicular crossings.

² Class II bikeways (bike lanes) are striped lanes on streets, separating bicycles from vehicles, within the road right-of-way.

³ Class III bikeways (bike routes) are lanes shared with motor vehicles

3.1 SEGMENT 1 - AT-GRADE CONNECTION TO MANDELA PARKWAY

Between Mandela Parkway and Campbell Street at West Grand Avenue, the new bicycle/pedestrian path would be a 15-foot wide Class I at-grade path along the south side of West Grand Avenue for approximately 450 feet. A landscape medium will be on the north side of the path to separate the path from vehicular traffic. A Cul-de-sac will be created at Willow Street to prevent vehicular traffic from crossing the new Class I bike path. An emergency vehicle access will be located at the intersection of Campbell Street and West Grand Avenue.

From Mandela Parkway at 20th Street (one block south of West Grand Avenue), there would be Class II bicycle lanes along 20th Street to Wood Street and along Wood Street to 24th Street and the proposed 100-space parking lot on the west side of Wood Street.

3.2 SEGMENT 2 - SEPARATE ELEVATED STRUCTURE EAST

From Campbell Street, the Class I path would be continue for approximately 1050 feet as a separate structure along the south side of West Grand Avenue and would begin an elevated ascent similar to West Grand Avenue, crossing at Wood Street. After the Wood Street crossing, the new path would continue on the West Grand Avenue bridge structure (refer to Segment 3 below).

The existing Grand Avenue Alley would be required to be permanently closed to traffic. A pedestrian sidewalk would remain along with the landscaping under the structure. The Grand Avenue Alley is the narrow, one-way street on the south side of Grand Avenue between Mandela Parkway and Wood Street.

3.3 SEGMENT 3 - WEST GRAND AVENUE OVERCROSSING

After the Wood Street overcrossing, the Class I path would continue for approximately 780 feet on the West Grand Avenue overcrossing over the frontage road and spur line railroad tracks, under the I-880 freeway structures, and over the Burlington Northern & Santa Fe Railroad (BNSF) and Union Pacific Railroad (UPRR) tracks. The width of the travel lanes and striped medium would be reduced to provide enough width for the bike path, now Class III, using the existing West Grand Avenue roadway structure. After the railroad crossing, the new path continues as a separate structure on the south side of West Grand Avenue (refer to Segment 4).

3.4 SEGMENT 4 - SEPARATE ELEVATED STRUCTURE WEST

After the railroad crossing, the Class I path would continue for approximately 3,400 feet as a separate structure on the south side of West Grand Avenue. The bike path would cross over Maritime Street and continue to the touchdown near the Caltrans maintenance facility. The path would descend with a switchback curve to the east of the Caltrans maintenance facility.

Two ramps could also be included with this section after the Class I path is construction, if funding is available. On the east side of Maritime Street, there could be an approximately 700-foot-long ramp extending to Burma Road. On the west side of Maritime Street, there would be an approximately 250-foot-long ramp extending to a roof-top landing and rest stop on the planned Oakland Maritime Support Services building.

3.5 SEGMENT 5 - AT-GRADE CONNECTION TO BAY BRIDGE TRAIL

From Segment 4, the Class I path would continue another 350 feet at grade level below the I-880/80 connection lanes and connect to the existing Bay Bridge Trail.

3.6 CLASS II BIKE LANES

The project could also include Class II bike paths along surface streets near the east touchdown of the Class I bike path, providing connections to Mandela Parkway and the proposed Wood Street parking lot. The Class II bike lanes would have a width of approximately 5 feet extending along each side of the street and cover approximately 4650 linear feet. The Class II bike paths would be constructed after the Class I bike path if funding is available.

4.0 PERTINENT REPORTS

The following reports and drawings prepared by Fugro and other consulting firms are pertinent to this study. No new investigation was performed for this PFR:

- Fugro – Earth Mechanics, 2013, Foundation Report for IERBY Temporary Improvements on Oakland Mole Touchdown, San Francisco-Oakland Bay Bridge East Span Seismic Safety Project, Oakland, California, March 19.
- Berlogar Stevens & Associates, 2012, Updated Master Plan Level Geotechnical Investigation Report, Oakland Army Base, Oakland, California, March 7.
- Fugro – Earth Mechanics, 2003, Final Geotechnical Foundation Report, Oakland Shore Approach Structures, SFOBB East Span Seismic Safety Project, Oakland, California, May 19.
- Earth Tech, 2001, Final Report: Oakland Army Base Utility Study Geotechnical Review, Oakland, California, April.
- Subsurface Consultants, Inc., 1999, Geotechnical Investigation Oakland Harbor Navigation Improvement (-50 Foot) Project, Port of Oakland, Oakland and Alameda, California, February 12.
- Caltrans, 1994, Project Plans for Construction of State Highway in Alameda County in Oakland on Route 880 at West Grand Avenue and on Route 80 from 0.7 Mile West to 1.0 Mile East of San Francisco-Oakland Bay Bridge Toll Plaza (Parts 1 and 2), Contract No. 04-192231.
- Sloan, Doris, 1992, The Yerba Buena Mud: Record of the Last Interglacial Predecessor of San Francisco Bay, California, Geological Society of America Bulletin, vol. 104.
- Rogers/Pacific, Inc., 1991, Final Report to National Science Foundation, Engineering Geologic Site Characterization of the Greater Oakland – Alameda Area, Alameda and San Francisco Counties, California, December 30.

The borings as shown on Plates 1a and 1b are based on the above reference reports and project plans. Plate 1a and 1b present the existing boring and/or Cone Penetration Tests (CPTs) approximate locations for the Gateway Park project and the Connection project, respectively. The boring logs used for the Connection Project are included in Appendix B.

5.0 GEOLOGIC AND SEISMOTECTONIC SETTING

5.1 REGIONAL GEOLOGY

The site is located in the Coast Ranges geomorphic province, which is characterized by northwest-southeast trending valleys and ridges. These are controlled by folds and faults that resulted from the collision of the Pacific and North American plates and subsequent strike-slip faulting along the San Andreas fault zone. The Bay Area also experienced uplift and faulting in several episodes during late Tertiary time (about 25 to 2 million years ago). This produced a series of northwest-trending valleys and mountain ranges, including the Berkeley Hills, the San Francisco Peninsula, and the intervening San Francisco Bay.

5.2 LOCAL GEOLOGY

The Coast Ranges consist of northwest-trending mountain ranges, basins, and narrow valleys generally paralleling major geologic structures and the coastline of California. The San Andreas fault system and the Hayward fault zone, contain active, northwest-trending, strike-slip faults, and to a lesser degree thrust faults which bound the study area.

Bedrock in the project vicinity consists of the late Jurassic and Cretaceous age Franciscan Complex and it is time contemporaneous Great Valley Sequence. The Franciscan Complex is a tectonic mixture of intensely deformed sedimentary, volcanic, and metamorphic rocks including serpentinite, which generally are in faulted contact with the overlying Great Valley Sequence. The San Francisco Bay sits within a broad depression in the Franciscan bedrock resulting from an east-west extension between the San Andreas and the Hayward fault systems. The bedrock surface is estimated to lie at Elevations -400 to -600 feet³ in the study area. The bedrock surface becomes deeper towards the south-southeast and shallower in other directions.

The unconsolidated geologic formations central to this study were deposited on top of the dissected Franciscan bedrock surface during several episodes of significant sea level rise and fall associated with past glaciations. These formations were grouped by Rogers and Figures, (1991), into the following major geologic units (from deepest to shallowest): the Alameda Formation, Old Bay Clay, the San Antonio Formation, Young Bay Mud, and Fill.

The lower Alameda Formation, consisting of continental sediments, was deposited on top of the bedrock surface between 500,000 and 1,000,000 years ago. Depositional environments likely included alluvial fans, lakes, flood plains, streams, and swamps (Rogers and Figures, 1991). Boring logs indicate a mixture of clay, silt, sand, and gravel, with predominantly fine-grained sediments and discontinuous layers of sand and gravel. These sediments are typically oxidized and therefore brown to yellow in color.

Between 400,000 to 500,000 years ago the sea entered the bay and deposition of the upper Alameda Formation began. These sediments were deposited in alluvial, estuarine, and marine environments (Rogers and Figures, 1991). Alameda Formation consists of a mixture of clay, silt, sand, and gravel, with a greater proportion of fine-grained sediments. Sand and gravel units are relatively thin and discontinuous. Sediments include both oxidized alluvial (brown/yellow) and unoxidized (blue/gray/green) marine layers, resulting from a depositional

³ Elevations referenced to North American Vertical Datum 1988 (NAVD88)

environment that changed with the rise and fall of the sea level and basin subsidence. Deposition and subsequent erosion of the upper Alameda Formation ceased approximately 125,000 years ago when Old Bay Clay deposition began (Sloan, 1992).

The Old Bay Clay is an unoxidized marine/estuarine unit consisting primarily of gray silty clay with occasional thin, discontinuous sand lenses. It was deposited beginning 115,000 to 125,000 years ago and ending 40,000 to 100,000 years ago during a time when sea level was as high as 20 feet higher than today (Rogers/Pacific, Inc., 1991; Sloan, 1992). The Old Bay Clay forms a relatively continuous layer extending a considerable distance inland from the present shoreline. Erosion of the top of this unit occurred during the Wisconsin glacial period between 90,000 and 11,000 years ago when sea level was considerably lower than at present (Rogers and Figures, 1991).

The San Antonio Formation consists of continental deposits, including the Aeolian Merritt sands and alluvial Posey sands. Deposition of these units occurred in late Wisconsin time when sea level was lower than at present. The top of the San Antonio Formation was subsequently eroded in very late Wisconsin time.

Deposition of the Young Bay Mud has been occurring over the last 10,000 years and continues today. The Young Bay Mud consists of estuarine/marine gray silty clay with minor discontinuous sand lenses.

The Young Bay Mud is overlain by undifferentiated fill that was placed in the late 1800s and throughout the 1900s.

A local geology map is shown on Figure 2.

5.3 SEISMOTECTONIC SETTING

The project site is located in the San Francisco Bay Area, which is considered one of the most seismically active regions in the United States. Significant earthquakes have occurred in the Bay Area and are associated with crustal movements along a system of subparallel fault zones that generally trend in a northwesterly direction.

The Coast Ranges tectonic province is bounded on the west by the northwest-trending San Andreas fault system, the primary boundary between the Pacific and North American Plates. The system boundary is represented as a broad region, 100 to 200 km wide, centered on the plate boundary, including much of the Coast Ranges, and is tectonically dominated at present by the dextral horizontal shear caused by the relative motion of the two plates. In the San Francisco Bay region, the plate boundary is a 100-km-wide zone of deformation consisting of several major strike-slip fault zones as shown in Figure 3 including the San Gregorio, San Andreas, Hayward-Rodgers Creek, Calaveras, and Concord-Green Valley faults (USGS, 2006). Table 1 outlines the distance from the site to nearby major faults, their segment length, slip rate, and magnitude.

The last major earthquake on the Hayward fault occurred in 1868 and caused widespread damage throughout much of the East Bay region. This earthquake caused surface rupture from Fremont to as far north as Berkeley. Although the fault rupture was poorly documented, modeling of survey data suggest that the fault moved as far north as Berkeley, and from these data the average amount of horizontal movement along the fault is inferred to be

about 1.9 meters (Stover and Coffman, 1993). Small vertical displacements (0.1–0.2 m) have also been estimated (Lienkemper and others, 2002). Based on empirical relationships among earthquake magnitude, fault rupture length, and displacement (Wells and Coppersmith, 1994), a large event on the Hayward fault is capable of generating displacements of at least 10 feet. In addition to coseismic rupture, the Hayward fault is undergoing creep, i.e., it is undergoing continuous aseismic slip. This amounts to about 4 to 6 mm/yr on the Hayward fault in Fremont (Lienkaemper and others, 1997).

Table 1. Major Active Faults in the Project Vicinity

Fault	Distance to Project Site (km)	Slip Rate (mm/yr)	M _{max}	Fault Type
North Hayward	6	9	7.3	bi-lateral
South Hayward	17	9	7.3	bi-lateral
San Andreas - Peninsula	24	17	8	bi-lateral

In 2008, the Working Group on California Earthquake Probabilities (WGCEP 2007), in conjunction with the United States Geological Survey (USGS), the California Geological Survey (CGS), and the Southern California Earthquake Center (SCEC) published an updated report evaluating the probabilities of significant earthquakes occurring in the Bay Area over the next three decades. The report finds that there is a 63 percent probability that at least one magnitude 6.7 or greater earthquake will occur in the San Francisco Bay region over a 30-year period. This probability is an aggregate value that considers principal Bay Area fault systems and unknown faults (background values).

6.0 SITE AND SUBSURFACE CONDITION

6.1 SITE CONDITIONS

This linear project area is bound by retail/commercial and industrial properties along Wood Street and West Grand Avenue in its eastern portion and current and former industrial properties of the Oakland Army Base (OAB) and EBMUD wastewater treatment system in its western portion. The site is located in a mixed commercial/industrial and residential areas.

The far eastern limit of the Connection is Mandela Parkway, southwest of the MacArthur Maze. Mandela Parkway is the former location of the Cypress Freeway Structure which collapsed during the 1989 Loma Prieta Earthquake.

West Grand Avenue connects surface streets, such as Mandela Parkway, in Oakland to on and off ramps from the Nimitz Freeway and Interstate-80. West of Campbell Street, West Grand Avenue consists of an elevated roadway that crosses over industrial land occupied by existing Union Pacific Railroad (UPRR) and Burlington Northern Santa Fe (BNSF) Right-of-Ways (ROWs), the former OAB, and Port of Oakland property.

6.2 SUBSURFACE CONDITIONS

As previously discussed, the six main geologic units underlying the proposed project area are Fill, Young Bay Mud, the San Antonio Formation, Old Bay Clay, the Alameda Formation, and Franciscan Complex (bedrock). Old borings and wells explored previously encountered the upper five units except the Franciscan bedrock. At some locations, not all of the geologic units are present. The reasons certain units are missing include natural geologic depositional processes, past dredging, and the absence of fill placed offshore.

Based on the review of the available borings from previous investigation, we generated Idealized Soil Profiles F-F' and G-G' which are presented on Plates 2a and 2b respectively. It depicts our understanding of the ground surface conditions and the underlying soil types along the Connection alignment. The idealized soil profile represents our interpretation of how the soil (lithological) contacts vary between boring and well locations. Because of the wide spacing of the data points and the natural variations during soil deposition, the actual contact locations may vary. The approximate locations of the borings and wells from previous investigations are shown on the Site and Boring Location Plans (Plates 1a and 1b) and the boring logs are included in Appendix B.

6.2.1 Fill (Elevations 10 to -10 feet)

Beginning in the mid-1800s, progressive filling of the natural bay margins occurred in the Port area. The fill was placed at various times and using various filling techniques, including hydraulic filling and end-dumping techniques. The materials used as fill also vary significantly across the project area. The fill materials encountered by the recent borings and wells included various combinations of clay, silt, sand, gravel, and cobbles. The borings indicated the fill ranges from loose to dense. In several areas, loose to medium dense and some occasional dense, fine- to medium-grained sands were encountered below the water table. These loose to medium dense sands are likely hydraulically placed fill with relatively high potential to liquefy in a major earthquake event. The thickness of the fill varies from 5 to 20 feet across the project area.

6.2.2 Young Bay Mud (Elevations +5 to -60 feet)

The formation referred to as Young Bay Mud (YBM) consists predominantly of a soft to medium stiff fat clay. The material typically has a high moisture content and a low dry density, and is soft, highly plasticity, and highly compressible. The thickness of the YBM encountered in the boring logs varies from 10 to 60 feet across the project site. There are occasional sand lenses embedded within the Bay Mud but they are discontinuous across the proposed structure alignment.

6.2.3 San Antonio Formation (Elevation -10 to -40 feet)

The San Antonio Formation includes fine- to medium-grained estuarine, alluvial, and aeolian sands that contain a varying amount of silt and clay. The Merritt sand is an aeolian deposit that is generally brown or yellow in color, dense to very dense, and ranges from being clean to containing silt and clay. The Posey sand is reworked Merritt sand that tends to be gray/green in color, medium dense, and clayey. The majority of the San Antonio Formation is relatively dense to very dense sand with Standard Penetration Test (SPT) blow counts ranging from 30 to 70. There are a few layers encountered described as medium dense but it is mixed with varying amount of clay. The thickness of the San Antonio Formation encountered in the borings varies from 0 to 20 feet across the project site.

6.2.4 Old Bay Clay (Elevations -25' to maximum depth explored)

The Old Bay Clay typically consists of a stiff to hard fat clay that occasionally contains thin lenses of fine-grained sand. The material typically has a lower moisture content, higher density, higher strength, and lower compressibility than the Young Bay Mud. Several historical borings encountered sandy layers within the Old Bay Clay, referred to as Old Bay Deposits. These sandy layers are typically 10 to 15 feet thick and dense to very dense. The bottom of the Old Bay Clay was not encountered in the borings reviewed for this study; however, we estimated the bottom of the Old Bay Clay is at approximate Elevations -75 feet to -100 feet based on the contour map generated from previous investigation by others⁴.

The Alameda Formation and the bedrock were not encountered in previous borings in the project vicinity.

6.2.5 Groundwater Conditions:

Existing data indicate that shallow groundwater in the project area typically varies from Elevation 0 to 3 feet. Based on information provided in the report "Matrix Environmental Services, LLC, Final, Upland Areas of Concern, Feasibility Study, BRAC Parcel 1, Oakland Army Base, dated March 2006", the tidal influence on the groundwater gradient extends approximately 600 feet inland from the Oakland Harbor; in this area, groundwater flow is expected to be highly variable due to tidal forces. However, the distance of the proposed structure to the Bay is at least 1,000 feet so the tidal force should not significantly impact the groundwater level of the site.

⁴ Information based on report titled "Geotechnical Investigation -50 foot Navigational Improvement Project Port of Oakland, Oakland and Alameda, California", February 1999.

7.0 GEOLOGIC AND SEISMIC HAZARDS

The followings discuss the potential geologic and seismic hazards at the project site:

7.1 FAULT RUPTURE

The majority of earthquakes in the Bay Area are associated with the San Andreas Fault and Hayward Fault system. The San Andreas Fault system is a 100-km-wide zone of deformation, which includes multiple northwest-southeast trending strike-slip faults that control the formation of the mountains and valleys of the Coast Ranges Geomorphic Province. As discussed previously, the nearest active fault is the Hayward fault located approximately 6.2 km to the northeast of the site. The structure does not fall within a CGS Fault-Rupture Hazard Zone (Alquist-Priolo Earthquake Fault Zone), as shown on Figure 4. Caltrans (2009) considers a distance of 50 horizontal feet on either side of a field evaluated active fault trace to have a potential for surface fault rupture displacement hazard (SFRDH). Therefore the potential for ground surface rupture is not a design consideration for the proposed structure.

7.2 STRONG GROUND SHAKING

Due to the close proximity of the Hayward fault, the project site will be subject to strong ground shaking during future large earthquakes originating on this fault, as well as from other regional faults.

The WGCEP (USGS, 2007) considers the Hayward-Rodgers Creek fault system the most likely source of the next M 6.7 or larger earthquake in the Bay Area, with a 31 percent probability of occurring in the time period 2007 to 2037. Their model also incorporates a scenario where the Hayward fault ruptures along with the Rodgers Creek fault. Rupture of the entire length of both faults would generate a mean maximum earthquake of M 7.3 (USGS, 2007). Rupture of the Rodgers Creek fault and the northern segment of the Hayward fault would generate a maximum event of M 7.1.

7.3 LIQUEFACTION

Strong ground shaking caused by large earthquakes can induce ground displacement and/or failure, such as liquefaction, compaction settlement, and slope movement. A site's susceptibility to these hazards relates to the site topography, soil conditions, and depth to groundwater.

Liquefaction is a soil behavior phenomenon whereby sediments temporarily lose shear strength and collapse. This condition is caused by cyclic loading during earthquake shaking that generates high pore-water pressures within the sediments. The soil most susceptible to liquefaction is loose, cohesionless, granular soil below the water table and within about 50 feet of the ground surface. Liquefaction can result in loss of foundation support and settlement of overlying structures, ground subsidence and translation due to lateral spreading, and differential settlement of affected deposits.

The liquefaction susceptibility of the sediments at the project site and its vicinity is mapped by the USGS as "very high" in the vicinity of project site, as shown in Figure 5. Based on our review of the field investigation and laboratory test data, the site is generally underlain by fill consisting of loose to medium dense cohesionless sand (with occasional dense sand) of

approximately 5 to 15 feet thick and the depth to groundwater is approximately 2 to 6 feet. Where these deposits are below the water table, there is a high potential for them to liquefy during a major seismic event. There are also some deeper sand layers; there are some thin layers of 1 to 2 feet of medium dense sand layer but the majority of this sand layers tend to be dense and/or cohesive and we judge that they have a relatively low potential to liquefy during a major seismic event.

We used the available information from previous investigations obtained to evaluate the potential for seismically-induced ground surface settlement in the area of the proposed improvements. In accordance with the procedures developed by Tokimatsu and Seed (1987) for estimating volumetric strain of saturated clean sand based on the energy corrected SPT blow count $(N_1)_{60}$ and the cyclic stress ratio (CSR), the settlement at each boring location was estimated. The calculation indicated that the accumulative settlement is on the order of 6 to 10.2 inches based on a moment magnitude M_w of 7.3 and a PGA of 0.62g. The medium dense to dense lower sand layer may be subject to less than 1-inch of settlement. These calculations are provided in the table in Appendix C.

The liquefaction-induced settlements within the surficial fill may induce downdrag loads on deep foundations. Downdrag load on piles should be re-evaluated after completion of future investigations and final design of the Path structure is completed.

Lateral spreading occurs when a layer liquefies at depth and causes horizontal movement or displacement of the overburden mass on sloping ground or toward a free face, such as a stream bank or excavation, or towards an open body of water. Given that the site is generally flat and it is about 1,000 feet from the shoreline of the Bay, we conclude that the potential for lateral spreading is low; however, due to the large lateral extent and depth of liquefiable fill, limited permanent lateral soil displacements may occur. The impact of soil displacements on structures should be evaluated as part of detailed design at a later phase.

7.4 LANDSLIDE AND SLOPE FAILURE

Due to the relatively flat topography at the site, landsliding is not considered a hazard.

7.5 FLOOD

FEMA flood zone maps (<http://www.fema.com>) indicate that the project area is located outside the 100-year flood plain. Tsunami, or seismically induced large waves, may be generated by rapid movements on earthquake faults. Studies⁵ have been conducted on wave attenuation within San Francisco Bay in the event of a large tsunami, and the project site is within the tsunami inundation line.

Sea level rise issues are addressed in a separate technical memorandum titled "Sea Level Rise Adaptation Revision 3" prepared by CH2M Hill dated February 17, 2014.

7.6 SCOUR

Because the existing and proposed structure supports are located outside waterways, scour is not an issue for the proposed structure.

⁵ Information is based on Tsunami Inundation Map for Emergency Planning, Oakland West Quadrangle by California Geological Survey, dated July 31, 2009.

7.7 CORROSION

The 2012 Berlogar Stevens & Associates report tested 17 soil samples around the Oakland Army Base for corrosivity testing (Appendix C), and 6 soil samples (H-9, H-16, H-28, H-30, H-56, and T-5) are located near this project location (approximately 260 to 1000 feet away). The classification of these samples, as documented in the report, ranged from “moderately corrosive” to “severely corrosive”. The pH of the soils ranged from 7.4 to 8.2, which does not present corrosion problems for buried iron, steel, mortar-coated steel and reinforced concrete structures. The sulfide ion concentrations reflect none detected with a detected limit of 50 mg/kg. One sample (T-5) was tested to contain chloride ion concentrations more than 300mg/kg, which is sufficient to attack steel embedded in a concrete mortar coating. In addition, an elevated level of sulfate ion concentrations was detected and was determined to be sufficient to damage reinforced concrete structures and cement mortar-coated steel. Therefore, concrete that comes into contact with this soil should use sulfate resistant cement such as Type II, with a maximum water-to-cement ratio of 0.55.

We recommend the corrosion potential of subsurface soils in the vicinity of the proposed improvements be evaluated in accordance with the requirements of Caltrans Memo to Designers 3-1 (July 2008) and ASTM standards during preparation of the future Foundation Report. Specifically, the redox potential, pH, resistivity, chloride, and sulfate will be tested for corrosivity potential to evaluate the effect of corrosion on the proposed improvements.

8.0 SEISMIC DESIGN CRITERIA

8.1 SEISMIC DESIGN METHODOLOGY

The seismic design methodology adopted for this project is based on the following current Caltrans standards:

1. Seismic Design Criteria (SDC), v 1.7, April 2013;
2. Guidelines for Structures Foundation Reports, v 2.0, updated March 2009;
3. California Seismic Hazard Map (2007); and
4. Caltrans ARS online (v2.3.06).

The new Caltrans procedures for developing the design acceleration response spectrum (ARS) use the envelope of the deterministic and probabilistic spectra, in contrast to the old procedure that used only the deterministic spectrum. The new deterministic spectrum is now adopting two next generation attenuation (NGA) models: an average of Campbell and Bozorgnia (CB) and Chiou and Youngs (CY) attenuation models. The deterministic spectrum is based on the envelope of median spectra corresponding to characteristic earthquakes occurring on all seismic sources in the vicinity of the site. The probabilistic spectrum is defined as the uniform hazard spectrum corresponding to a probability of exceedance of 5% in 50 years (975-year return period) per 2008 USGS hazard maps. In addition, the new procedure also updated the site factor, updated the near fault factor, and includes deep basin effect.

8.2 SITE SOIL PROFILE

Boring logs from the field explorations at the project site were reviewed. Shear wave velocity measurements were not made for the previous projects. The representative blow counts and undrained shear strength were used to estimate shear wave velocity based on empirical correlation recommended in Geotechnical Services Design Manual (Caltrans, 2009). The weighted average of the shear wave velocity over the depth of 100 feet was used to determine $V_{s,30}$, which were found in a range of 139 to 248 m/s (Caltrans 2012). However, the site is underlain by more than 10 feet of soft soil (Bay Mud) and is therefore classified as Soil Profile Type E⁶ based on the guidelines given in SDC Table B.1.

While some of the surficial fill is potentially liquefiable (Soil Type F), at this preliminary design phase the seismic design spectrum was developed under the simplifying assumption of non-liquefiable material. Additional geotechnical investigations and engineering analyses (e.g. site-specific ground response analyses) should be performed during the preparation for the Foundation Report. However, if the final design of the bridge foundation is relatively deep and the surficial liquefiable fill is confined to be within shallow depth (confirmed by new explorations) such that the site response would not be affected by this liquefiable material, then a code based spectrum may be used instead.

8.3 FAULT TYPE AND NEAR-FIELD SPECTRAL ACCELERATIONS

The technical report that accompanies the California Seismic Hazard Map (2007) indicates that the controlling fault is the Hayward fault, which is 6.2 km away from the site. Since the project site is less than 15 km from the nearest active fault, design spectral accelerations should be modified to account for near-fault effects as follows:

Period (sec)	Increase in Spectral Acceleration (%)
<0.5	0
0.5 to 1.0	0-20 (determined by linear interpolation)
>1.0	20

This does not include adjustments for bridges with fundamental periods of vibration greater than 1.5 seconds. As the design proceeds, the fundamental period of vibration of the planned structures for this project should be verified with the structural engineer.

6 A soil profile with shear wave velocity $v_s < 600$ ft/s (180 m/s) or any profile with more than 10 ft (3 m) of soft clay, defined as soil with plasticity index $PI > 20$, water content $w \geq 40$ percent, and undrained shear strength $s_u < 500$ psf (25 kPa)

8.4 DESIGN ACCELERATION RESPONSE SPECTRUM

The Design Acceleration Response Spectrum (ARS) corresponding to $V_{s,30} = 180$ m/s, magnitude of controlling event 7.3, was obtained from ARS online and modified to account for near field effects, as described above. The Design Acceleration Response Spectra is attached as Figure 6, and the spectral values are provided in Table 2. The design ARS curve is the envelope of the deterministic spectrum ($M_w = 7.3$, $R = 6.2$ km) and probabilistic spectrum (975-year return period). For the project location, the design spectrum is controlled by the probabilistic spectrum at all structural periods.

Table 2. Spectral Acceleration Values

T (s)	Sa (g)
0.01	0.621
0.05	0.866
0.10	1.000
0.15	1.166
0.20	1.300
0.25	1.332
0.30	1.359
0.40	1.328
0.50	1.305
0.60	1.287
0.70	1.278
0.85	1.257
1.00	1.238
1.20	1.120
1.50	0.991
2.00	0.847
3.00	0.544
4.00	0.390
5.00	0.314

9.0 GEOTECHNICAL RECOMMENDATIONS

On the basis of the results of our preliminary geotechnical study, we conclude that the proposed project is feasible from a geotechnical standpoint. The following sections provide preliminary foundation recommendations for the proposed elevated bike/pedestrian structure.

9.1 FOUNDATION ALTERNATIVES

Various foundation alternatives, including isolated shallow foundations as well as deep foundations such as drilled piers and driven piles, were considered to support the proposed structure. The foundation type should be chosen based on structure loading, allowable settlement and economics.

Spread footing foundations are not generally viable unless ground improvement is conducted because of the presence of Bay Mud and potentially liquefiable fill which would lead to total and differential settlements that would exceed the design tolerance. In addition, uplift requirements would likely require very large footings and/or permanent ground anchors. If ground improvement (jet grouting, compaction grouting or cement deep soil mixing) were implemented, shallow foundations could be designed; however, the overall costs would likely be excessive. Therefore, spread footing foundations are not recommended.

Driven precast prestressed concrete piles (PCPS) were also considered for foundation support of the structure. The use of driven piles is sometimes limited due to constructability disadvantages, such as noise and vibration impacts to adjacent structures during installation, as well as difficult driving conditions in dense sands or gravels. Based on the results of the existing subsurface data, the soil layers encountered at the site consists primarily of stiff to very stiff cohesive soils which are not likely to cause any drivability problem for driven piles. Driven piles can be battered at an angle to increase the lateral capacity. In addition, PCPS offer advantages in shallow groundwater and caving soil conditions and also do not produce drill spoils. Based on discussions with TY Lin, PCPS was not selected for this preliminary study; however, this option should be included as a possibility in the environmental documents and should be re-evaluated during final design.

Cast-in-drilled-hole (CIDH) piles have the advantages of easy penetration into dense/hard soil zones, the availability of larger diameters for increased lateral capacity, and adaptability of length to variable subsurface conditions. The presence of shallow groundwater or caving soils can complicate the use of CIDH piles. From the constructability standpoint, CIDH piling rigs are more economical to mobilize than pile driving rigs, can work in limited access conditions, and have significantly lower noise and vibration impacts during pile installation than driving operations. Based on discussions with TY Lin, 6 and 7 foot diameter CIDH piles are currently proposed for support of the Connection structure.

9.2 DESIGN SOIL PARAMETERS

Idealized soil profiles with soil stratigraphy and generalized soil engineering parameters are presented in Table 3. This idealized soil profile forms the basis for developing preliminary foundation recommendations for the proposed elevated structure. The proposed CIDH piles will gain primary vertical support through skin friction in the Old Bay Clay. For evaluating axial pile capacity, the skin friction developed within the undocumented fill and Bay Mud was ignored because of the potential for liquefaction of the sands and settlement in the Young Bay Mud. However, these units can be included to resist in short-term lateral loads. While thicker fill exists at some locations along the Connection alignment, thinner fills were used in the idealized profiles because they represent a majority of the alignment and this is considered conservative assuming the piles gain support through the Old Bay Clay. Due to the variability of the location and thickness of the sand, the sand lenses below the Bay Mud and interbedded within Old Bay Clay were conservatively considered assigned Old Bay Clay properties for computing vertical support. The lower sand layer can be included in the detailed design phase when new borings are performed at each foundation location to obtain site-specific information.

Furthermore, to account for the variation of the Bay Mud thickness, two idealized soil profiles were used to bracket the range of subsurface conditions. For other thickness of Bay Mud, the pile capacity can be interpolated linearly. In determining lateral capacity in the event of liquefaction, the fill layer properties were ignored to account for the loss of strength.

Table 3. Generalized Soil Design Parameters

Profile No.	Soil Type	Depth (feet)	Unit Weight (pcf)	Friction Angle (deg)	Shear Strength (psf)
1	Fill	0-8	120	28	350 (residual, liquefied)
	Young Bay Mud	8-28	98	-	*100 + 10z
	Old Bay Clay	28-110 ¹	115	-	1,500
2	Fill	0-6	120	28	-
	Young Bay Mud	6-60	98	-	*100 + 10z
	Old Bay Clay	60 -110 ¹	115	-	1,500

Note 1: The thickness of Old Bay Clay is estimated based on the deepest boring explored. The actual depth could be deeper.

9.3 CAST-IN-DRILLED HOLE PILES

As discussed above for this preliminary study, 6 to 7 feet diameter CIDH piles have been selected as the Connector foundation support type. At the time this report was prepared, the design loads were not yet available. Therefore, the proposed pile lengths verses capacities are provided in Figure 7. The final pile data table including design loads and design tip elevations will need to be updated for the Foundation Report once the loading conditions are available and additional geotechnical investigations and analyses are performed. The axial (compression) pile capacities shown in Figure 7 are ultimate values. For preliminary design, the residual strength of the liquefied material is estimated using $N_{160,cs}$ correlations (Seed and Harder 1990). The skin friction due to the non-liquefiable crust using static strength and the liquefied layer using residual strength are used to estimate the downdrag load. The downdrag load is estimated to be about 60 to 70 kips applied to the pile length above the Bay Mud. The downdrag load should disappear once the seismic settlement of this sand layer is complete. This should be re-evaluated when additional boring information is obtained in future design phase to confirm the thickness of the fill and liquefaction potential.

We recommend using a resistance factor of 0.7 and 1.0 for the strength limit state and the extreme limit state, respectively, to calculate the factored nominal resistance in accordance with the Load and Resistance Factor Design (LRFD) methods.

Resistance to lateral loads can be developed by bending of the pile and by soil-pile interaction. The magnitude of the lateral load resistance that can develop depends upon several factors such as the pile size, the physical properties of the surrounding soils, and the structural design of the pile. We used the computer program LPILE plus 5.0 to analyze the individual pile response to the lateral and axial loads with a series of nonlinear springs that are internally generated by the program as a function of user-specified soil properties. In addition, the piles were modeled as free head condition with respect to the two soil profiles including both liquefaction and non-liquefaction conditions. The required depth to provide sufficient lateral capacities is determined by the location of the second zero moment. The lateral loads required producing 1/4 -inch and 1-inch movement at the top of pile are summarized in Table 4. The design tip elevations shown below were estimated only based on the lateral load requirement as information regarding nominal resistance (both compression and tension) are not available at this time.

Table 4. Proposed CIDH Pile Data Tables

For Non-Liquefaction Case:

Pile Type	Soil Profile	Nominal Resistance	1 Inch Deflection		¼ Inch Deflection	
			Minimum Design Tip Elevation (feet)	Lateral Capacity (kips)	Minimum Design Tip Elevation (feet)	Lateral Capacity (kips)
6-ft CIDH	1	N/A	-79	178	-75	69
7-ft CIDH	1	N/A	-90	225	-83	91
6-ft CIDH	2	N/A	-98	172	-93	54
7-ft CIDH	2	N/A	-99	220	-96	75

For Liquefaction Case:

Pile Type	Soil Profile	Nominal Resistance	1 Inch Deflection		¼ Inch Deflection	
			Minimum Design Tip Elevation (feet)	Lateral Capacity (kips)	Minimum Design Tip Elevation (feet)	Lateral Capacity (kips)
6-ft CIDH	1	N/A	-92	69	-78	37
7-ft CIDH	1	N/A	-97	108	-88	55
6-ft CIDH	2	N/A	-96	61	-83	27
7-ft CIDH	2	N/A	-99	93	-93	38

Notes: 1) Assume pile cut off elevation at 0 feet (NAVD 88).

9.4 CONSTRUCTION CONSIDERATIONS

Potential construction considerations include:

- The loose cohesionless fill may cave in during installation of the CIDH piles, drilling slurry and/or casing will likely be required.
- Based on the previous investigations, we expect the CIDH piles will encounter groundwater between approximately the Elevations 3 and 0 feet.
- Limited access: the project site is located within urban area and local streets that may require lane closure during construction for the operation of the crane, removing spoil, delivering and installing reinforcing cages, and tremie concrete placement.
- Physical conflicts: potential conflicts with locations of new bridge supports and all existing facilities, such as utilities and adjacent overcrossing foundations.
- Disposal of soil cuttings/excavated materials: in-situ fill material may be contaminated and the handling and disposal should be performed with a Site Mitigation Plan (SMP) that includes health and safety criteria.

10.0 ADDITIONAL FIELD INVESTIGATION AND LABORATORY TESTING

As the project advances, we recommend additional geotechnical investigations be performed to characterize the subsurface conditions at the proposed locations of the foundations and verify our preliminary foundation recommendations for the proposed elevated structure. The following additional field investigations are recommended:

- Perform a boring and/or Cone Penetration Test (CPT) advancing 100 feet below the design pile cut-off elevation at each structure support location.
- Perform laboratory tests on recovered soil samples to determine engineering properties, including strength tests, Atterberg limits, sieve analysis, R-value test and corrosivity tests.

At new boring locations, samples should be taken at least at 5-foot depth intervals or at changes in strata. The final sample interval should be based on the materials encountered during drilling and sampling. Drive samples in the alluvium should be taken with either a SPT or Modified California (MC) sampler. Shelby Tubes and Pitcher Barrel samples should be used to collect Bay Mud and Old Bay Clay, respectively. In addition, suspension logging should be performed in selected borings to measure shear wave velocity for seismic design analysis.

At new CPT locations, the CPT probe was advanced using a hydraulic push system mounted in a mobile truck to collect information electronically such as tip resistance, sleeve friction, pore pressure and inclination data at 0.05 m intervals as the sounding was advanced. In addition, the CPT soundings can also include 1) Seismic Cone Penetration Tests (SCPTs) which collect compression and shear wave velocity for evaluation of the V_{s30} and 2) Pore Pressure Dissipation Tests (PPDTs) which measure hydrostatic pressure for evaluation of the static groundwater table. The SCPT uses a modified CPT cone that contains a built-in seismometer.

These additional investigations will also allow a confirmation of liquefaction susceptibility and triggering potential, analyses of potential ground deformations and effects on foundation capacity, and design recommendations to accommodate any anticipated consequences of liquefaction.

11.0 LIMITATIONS

The opinions, conclusions and recommendations presented herein are based on subsurface information developed by others. The recommendations presented in this report are based on the assumption that the soil and geologic conditions do not deviate substantially from those anticipated by the information contained in the existing logs of test borings. If any variations are encountered during construction, the Geotechnical Professional should be contacted so that supplemental recommendations can be made.

If existing facilities, utilities, soils/bedrock conditions, road/structure distress, slope distress or groundwater/seepage conditions other than those noted in this report are present on the site, then their presence was not known, or was not considered in the preparation of this report. Locating utilities and evaluating potential utility interference is outside the scope of this report. Individuals utilizing this report shall inform Fugro if they are aware of any additional facilities or site conditions so that their presence and impact upon the project (or vice-versa) can be properly evaluated and recommendations modified to address geotechnical issues as necessary.

Specific review and investigation for environmental issues and subsurface environmental contamination will be investigated by Fugro and presented in a separate report if requested.

The opinions and recommendations presented in this report were developed with the standard of care commonly used by other geotechnical professionals practicing at the same time, within the same locality and under the same limitations. No other warranties are included, either expressed or implied, as to the professional advice included in this report.


This report has been prepared for the benefit of TY Lin International and the Gateway Park Working Group. The information contained in this report, including all exhibits and attachments, may not be used by any party other than TY Lin International and the Gateway Park Working Group, without the express written consent of Fugro Consultants Inc.

12.0 REFERENCES


- California Department of Transportation (Caltrans), 2003 Bridge Design Specification
- California Department of Transportation (Caltrans), 2007 Caltrans Deterministic PGA Map
- California Department of Transportation (Caltrans), 2011 "California Amendments to AASHTO LRFD Bridge Design Specifications – fifth edition", November.
- California Department of Transportation (Caltrans), 2013a, Caltrans Memo to Designers 3-1 dated August.
- California Department of Transportation (Caltrans), 2009, Guidelines for Structures Foundation Reports, Version 2.0, dated March.
- California Department of Transportation (Caltrans), 2013, Seismic Design Criteria, Version 1.7, dated April.
- California Department of Transportation (Caltrans), 2012, Highway Design Manual dated May.
- California Geological Survey, 2009, Tsunami Inundation Map for Emergency Planning, Oakland West Quadrangle by California Geological Survey, dated July.
- FEMA, 2009. Digital Flood Insurance Rate Maps (DFIRMS).
- Graymer, R.W., 2000, Geologic Map and Map Database of the Oakland Metropolitan Area, Alameda, Contra Costa and San Francisco Counties, California, U.S. Geological Survey, MF-2342, Scale 1:50,000.
- Lienkaemper, J.J. and Galehouse, J.S., 1997, Revised long-term creep rates on the Hayward fault, Alameda and Contra Costa Counties: California, U.S. Geological Survey Open-File Report 97-690, 18 p.
- Lienkaemper, J.J. Dawson, T.E., Personius, S.F., Seitz, G.G., Reidy, L.M., and Schwartz, D.P. 2002. A Record of Large Earthquakes on the Southern Hayward Fault for the Past 500 Years. Bulletin of the Seismological Society of America, Vol. 92, No. 7, pp. 2637–2658, October 2002
- Moss, R.E.S., Seed, R.B., Kayen, R.E., Stewart, J.P., Der Kiureghian, A. and Cetin, K.O., 2006, O'Neill, M.W. and Reese, L.C., 1999. Drilled Shafts: Construction Procedures and Design Methods, FHWA Report No. IF-99-025, Federal Highway Administration, Washington, D.C
- J. David Rogers and Sands H. Figuers, 1991 Engineering Geologic Site Characterization of the Greater Oakland-Alameda Area, Alameda and San Francisco Counties, California. Final Report to the National Science Foundation, Rogers Pacific, Inc., 106 pages
- Seed, R.B., K.O., Cetin, R.E.S., Moss, A., Kammerer, J., Wu, J.M., Pestana, M.F., Riemer, R.B., Sancio, J.D., Bray, R.E., Kayen, R.E., Faris, A. (2003), "Recent advances in soil liquefaction engineering: a unified and consistent framework", Keynote Address, 26th Annual Geotechnical Spring Seminar, Los Angeles Section of the Geo-Institute, American Society of Civil Engineers, H.M.S. Queen Mary, Long Beach, CA.

- Sloan, Doris 1992, The Yerba Buena mud record of the last interglacial predecessor of San Francisco Bay California Geological Society of America Bulletin v 104 no 6 p 716 727.
- Stover, C.W., and Coffman, J.L., 1993. Seismicity of the United States, 1568-1989 (Revised) U.S. Geological Survey Professional Paper 1527, 1993.
- Tokimatsu, K. and H.B. Seed, 1987. Evaluation of settlements in sands due to earthquake shaking, J. Geot. Engrg., 113 (8), 861-878.
- Tomlinson, M. J., 1970. The adhesion of piles driven in stiff clay, Construction Industry Research and Information association, Research Report No. 26, London.
- USGS, 2007, Earthquake Probabilities in the San Francisco Bay Region: 2007-2037, By Working Group on California Earthquake Probabilities, Open File Report 07-1437.
- USGS Probabilistic Seismic Hazard Analysis <http://earthquake.usgs.gov/research/hazmaps/>
- Wells, D. L. and Coppersmith, K.J., 1994 New empirical relationships among magnitude, rupture length, rupture width, rupture area, and surface displacement. Bulletin of the Seismological Society of America August 1994 vol. 84 no. 4 974-1002.

PLATES

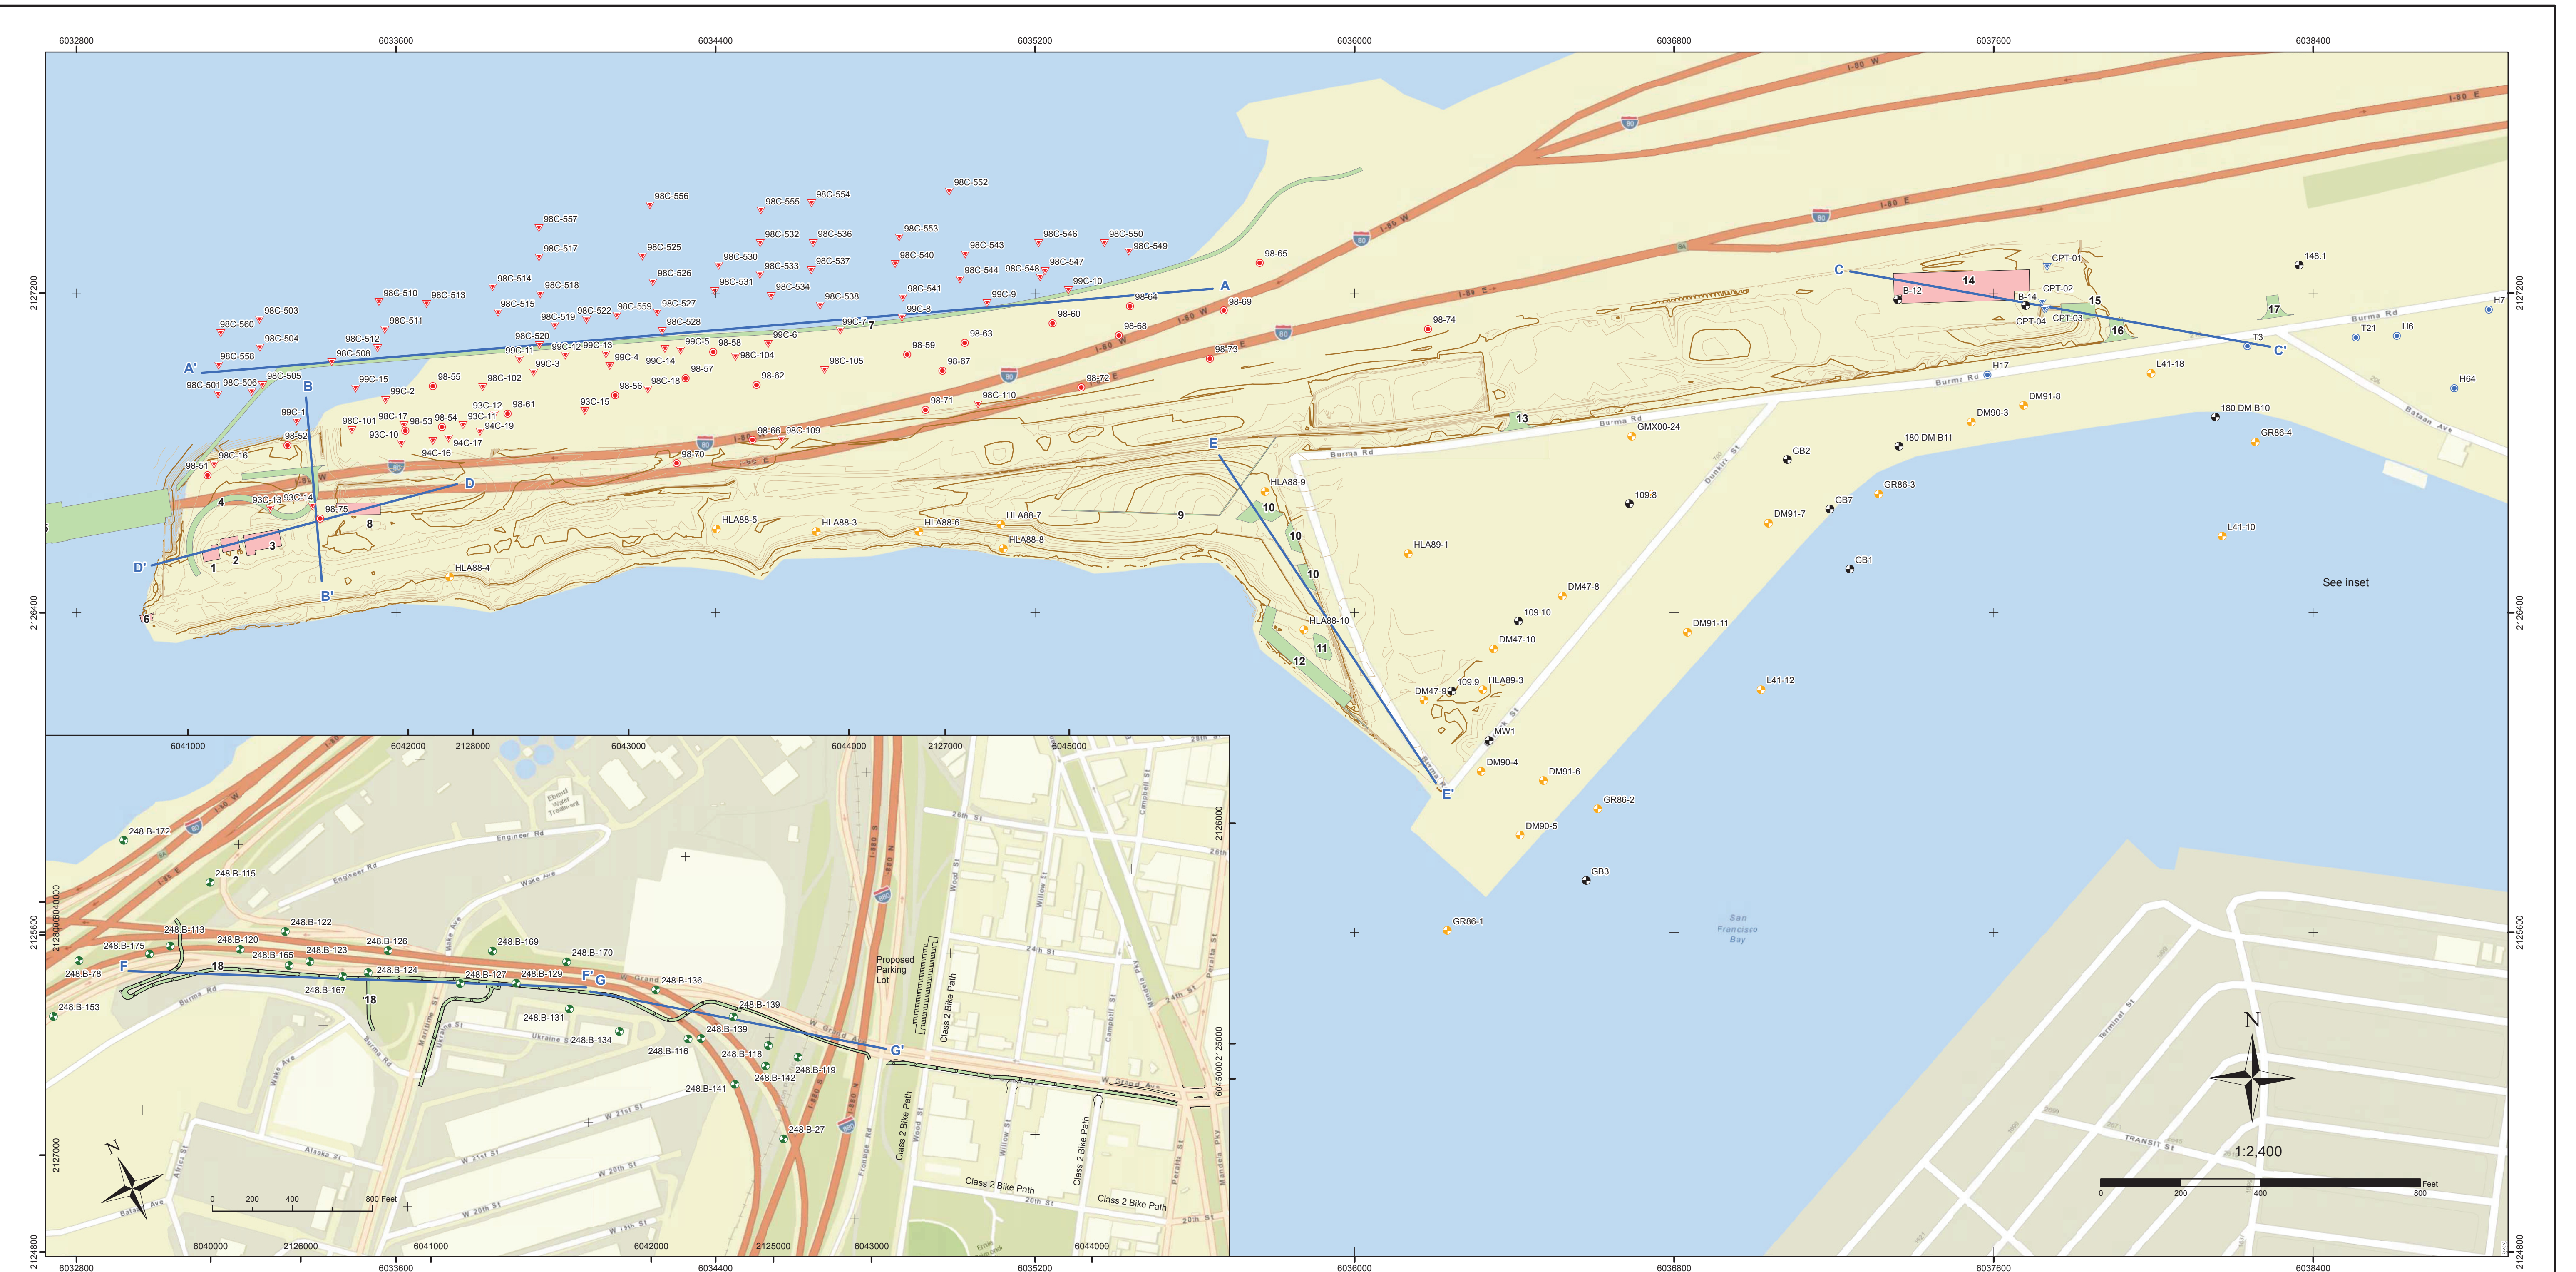

1:2,400

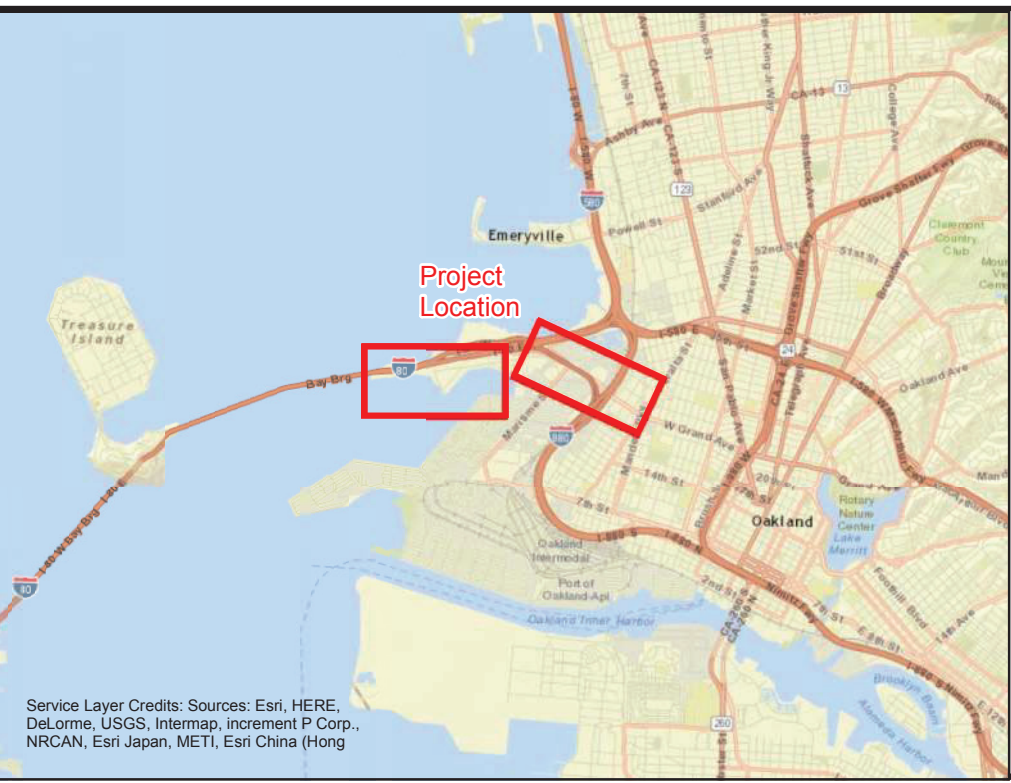

- Legend**
- Fugro 2014 CPT
 - Fugro 2011 Boring
 - SFOBB CPT
 - SFOBB Boring
 - Historical Borings (1946 - 2007)
 - Army Base Borings
 - Caltrans Borings
 - Cross Section Line
- Structures**
- Existing
 - Proposed

Building Index

Building No.	Name	Building No.	Name
1	PG&E Substation	10	Visitor Center
2	Historical Key Building	11	Climbing Wall
3	Historical Mole Substation	12	Shoreline Protection
4	Bay Bridge Elevated Bike Path Structure Connection to Park	13	EBMUD Crossing Location 1
5	2-288 Span Structure	14	IERBYS/ Historical Warehouse
6	EBMUD Building @ "The Point"	15	Auditorium
7	North Shore Elevated Bike Path on Structure	16	EBMUD Crossing Location 2
8	Mole Substation (PG&E)	17	EBMUD Crossing Location 3
9	Retaining Wall	18	Burma Road Elevated Bike Path Structure



FUGRO CONSULTANTS, INC.
 1000 Broadway, Suite 440
 Oakland, CA 94607
 Tel: (510) 268-0461
 Fax: (510) 268-0137
 www.fugroconsultants.com

**SITE AND BORING LOCATION PLANS
 GATEWAY PARK
 San Francisco Oakland Bay Bridge Bicycle / Pedestrian
 Connection, Oakland, California**

NO.	DATE:	DESCRIPTION:	DRAWN:	CHKD:	APPR:
1	Jun 2014	Exploration and Cross section Location Map	CBD	HS	TW

JOB NUMBER: 04.72130012 PLATE: 1a

N:\Project\04_2013\04_2112_012_GatewayPark\Output\04_2112_012_SitePlan_Bike_Report\Map\Plate1a_ExplorationLocationMap.dwg 7/29/2014 cdbm



Sources: Esri, HERE, DeLorme, USGS, Intermap, increment P Corp., NRCAN, Esri Japan, METI, Esri China (Hong Ko


Legend

- Caltrans Borings
- Burma Road Elevated Bike Path Structure
- Cross Section Line

**SITE AND BORING LOCATION PLAN
THE CONNECTION**
San Francisco Oakland Bay Bridge
Bicycle / Pedestrian Connection
Oakland, California

N:\Projects\04_2013\04_7213_0012_GatewayPark\Outputs\2014_06_02_SBOBB_Bike_Report\mxd\Plate1b_Expland\sectLoc_BikePath.mxd, 11/14/2014, VENCAD



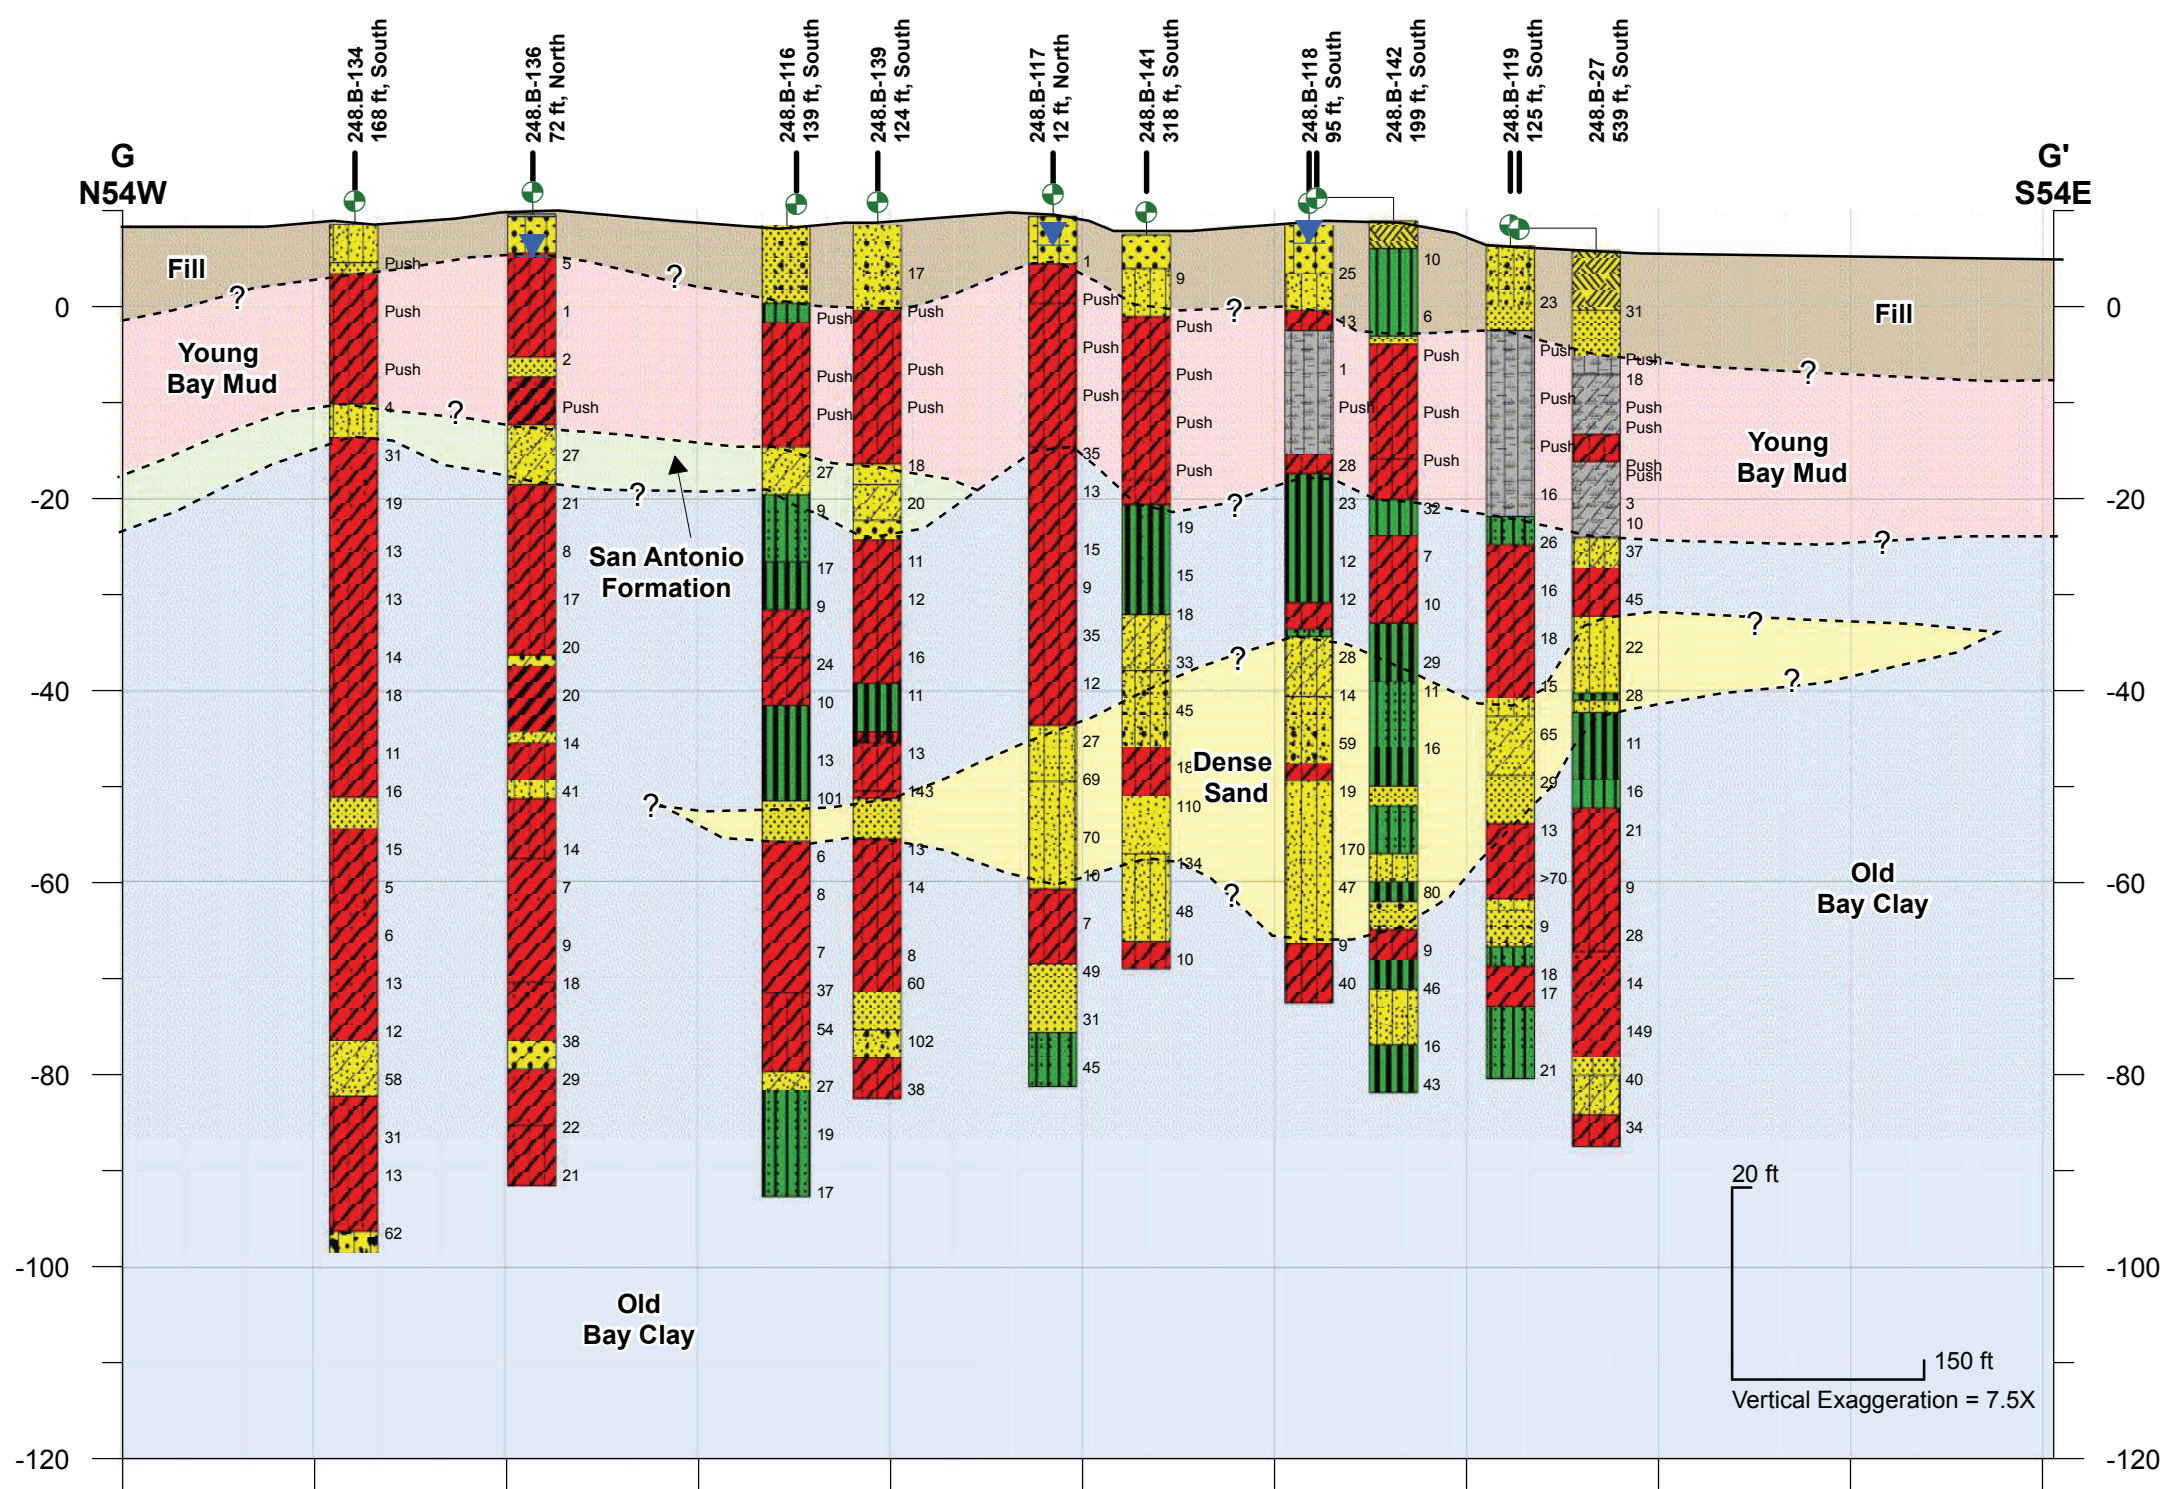


- Legend**
- Lean CLAY (CL)
 - Silty CLAY (CL-ML)
 - Lean CLAY with Sand (CL)
 - Sandy Lean Clay (CL)
 - Fat CLAY (CH)
 - Fat CLAY with SAND (CH)
 - Silt (ML)
 - Sandy SILT (ML)
 - Elastic Silt (MH)
 - Poorly-Graded SAND (SP)
 - Poorly-Graded SAND with Clay (SP-SC)
 - Poorly-Graded SAND with Silt (SP-SM)
 - Gravelly Poorly-Graded SAND (SP)
 - Well-Graded SAND (SW)
 - Gravelly Well-Graded SAND (SW)
 - Clayey SAND (SC)
 - Clayey to Silty SAND (SC-SM)
 - Silty SAND (SM)
 - Gravelly Silty SAND (SM)
 - Fill
 - Poorly-Graded GRAVEL (GP)
 - Poorly-Graded GRAVEL with Clay (GP-GC)
 - Poorly-Graded GRAVEL with Silt (GP-GM)
 - Well-Graded GRAVEL (GW)
 - Silty Gravel (GM)
 - Low-Plasticity Organic (OL)
 - High-Plasticity Organic (OH)
 - Asphaltic Concrete
 - SPT Blow Count

IDEALIZED SUBSURFACE PROFILE
San Francisco Oakland Bay Bridge
Bicycle / Pedestrian Connection
Oakland, California

N:\Projects\04_2013\04_7213_0012_GatewayPark\Outputs\2014_06_02_SBOBB_Bike_Report\mxd\Plate3b_ProfG.mxd, 11/14/2014, VENCAD


FIGURES

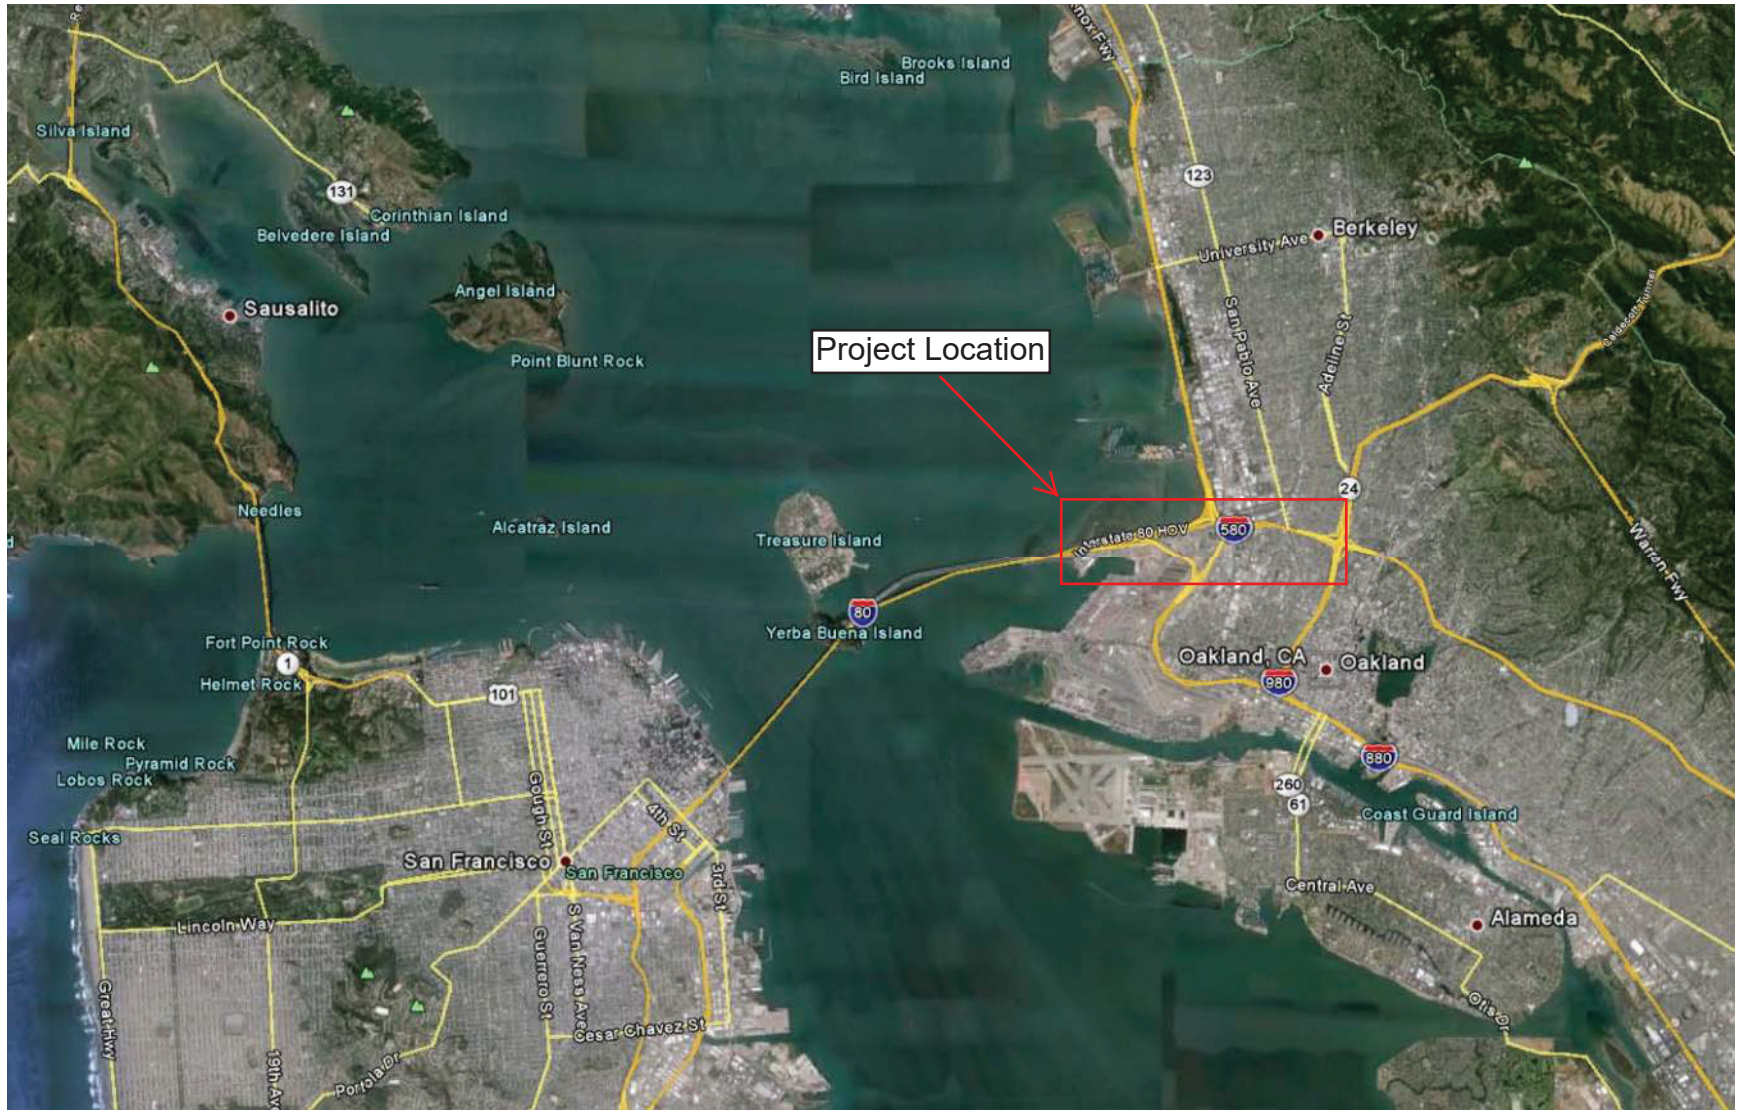

Vicinity Map

FIGURE 1



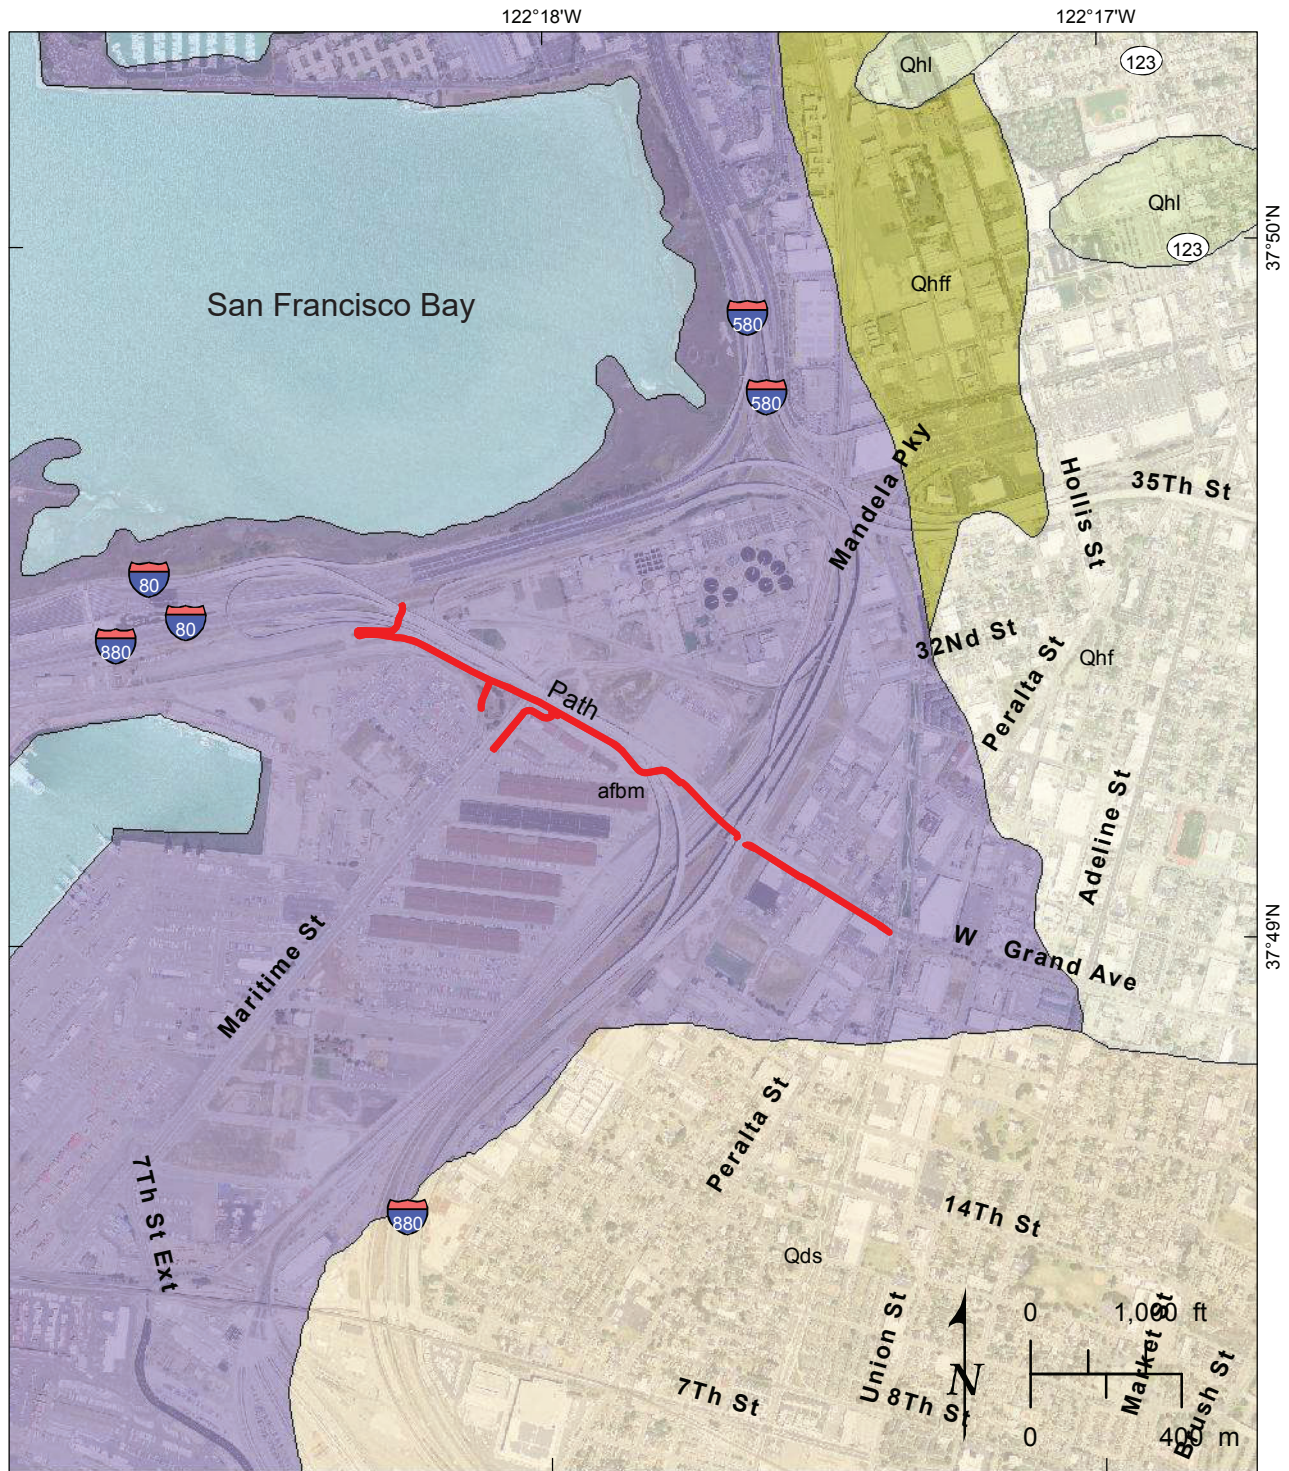

Imagery from NAIP, 2012


Quaternary Deposits
 (Knudsen et al., 2000; USGS OFR 00-444)

- afbm Artificial fill over San Francisco Bay mud
- Qhff Fine-grained Holocene alluvial fan deposits
- Qhf Holocene alluvial fan deposits
- Qhl Holocene alluvial fan levee deposits
- Qds Latest Pleistocene to Holocene dune sand

Quaternary Geologic Map

San Francisco Oakland Bay Bridge
 Bicycle / Pedestrian Connection

FIGURE 2

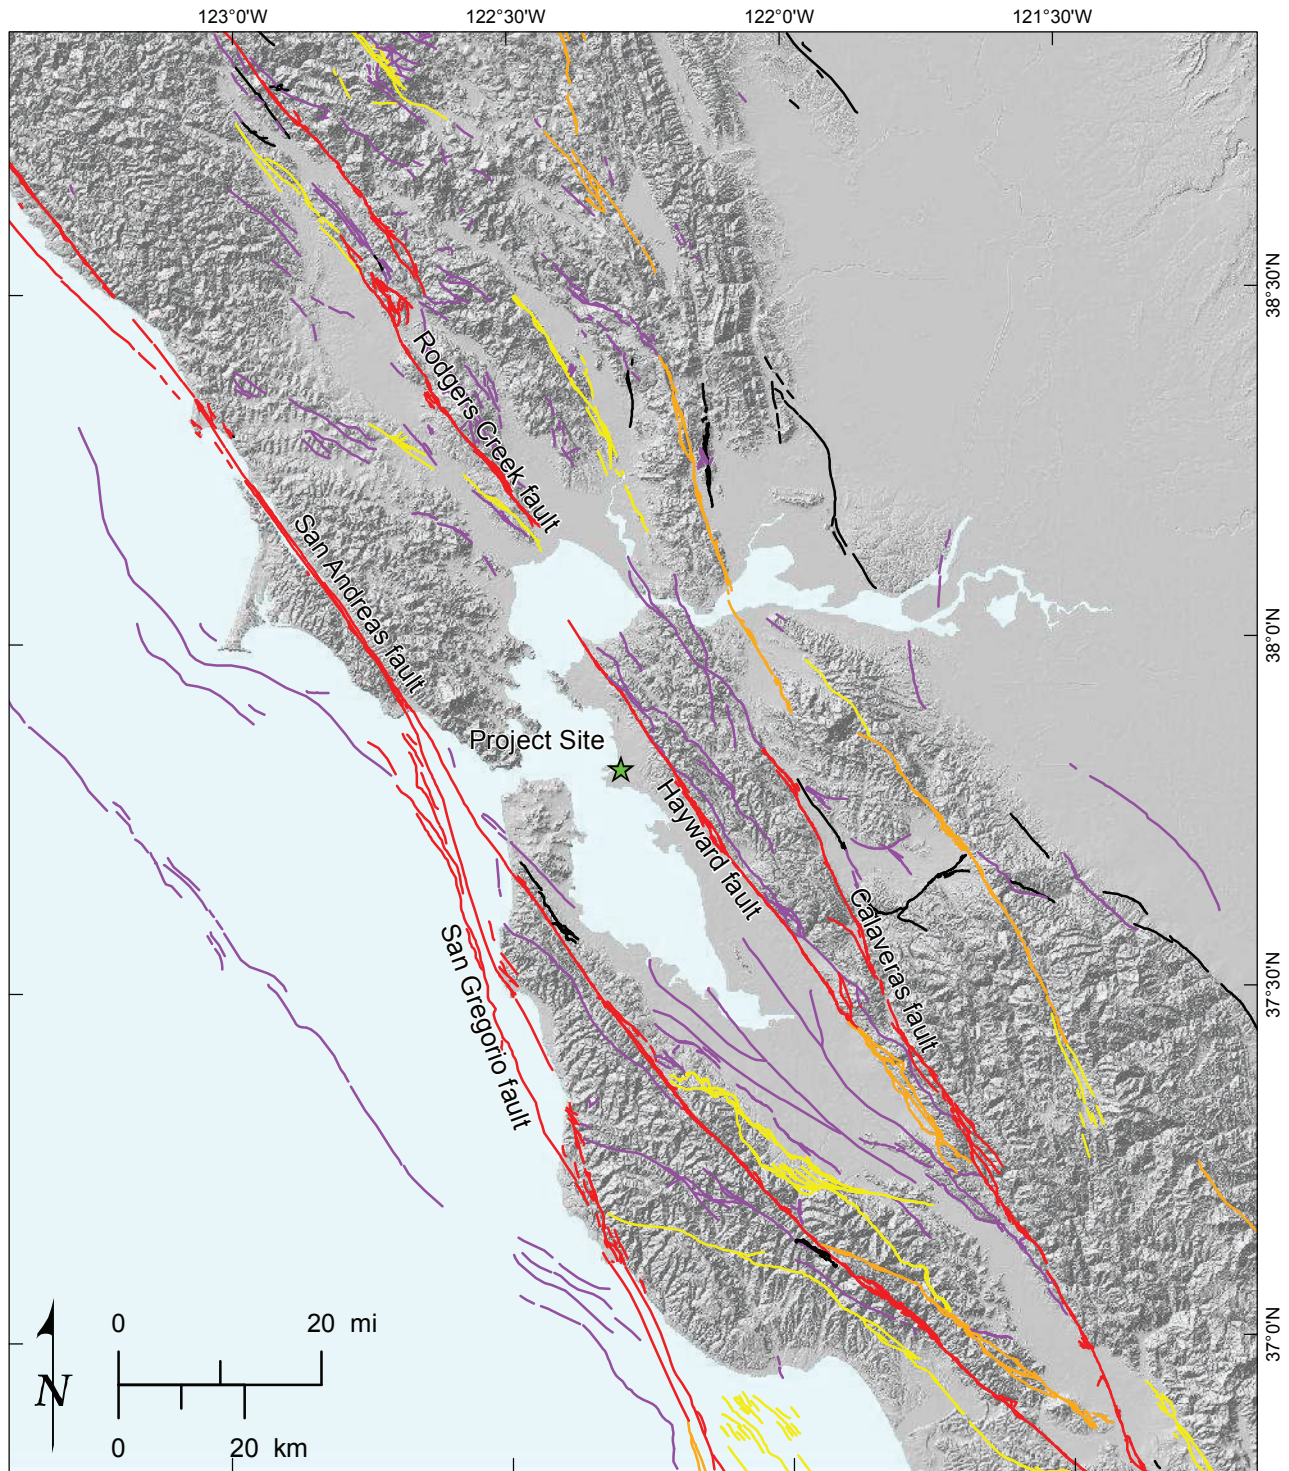

Reference: U.S. Geological Survey, 2006, Quaternary fault and fold database, from USGS web site: <http://earthquakes.usgs.gov/regional/qfaults/>.

Quaternary Faults (slip rate mm/year)

- >5
- 1-5
- 0.2-1
- <0.2
- Unknown

Major Active Fault Map

San Francisco Oakland Bay Bridge
 Bicycle / Pedestrian Connection

FIGURE 3




Imagery from NAIP, 2012

AP fault zone

Alquist-Priolo Earthquake Fault Zone

San Francisco Oakland Bay Bridge
 Bicycle / Pedestrian Connection

FIGURE 4

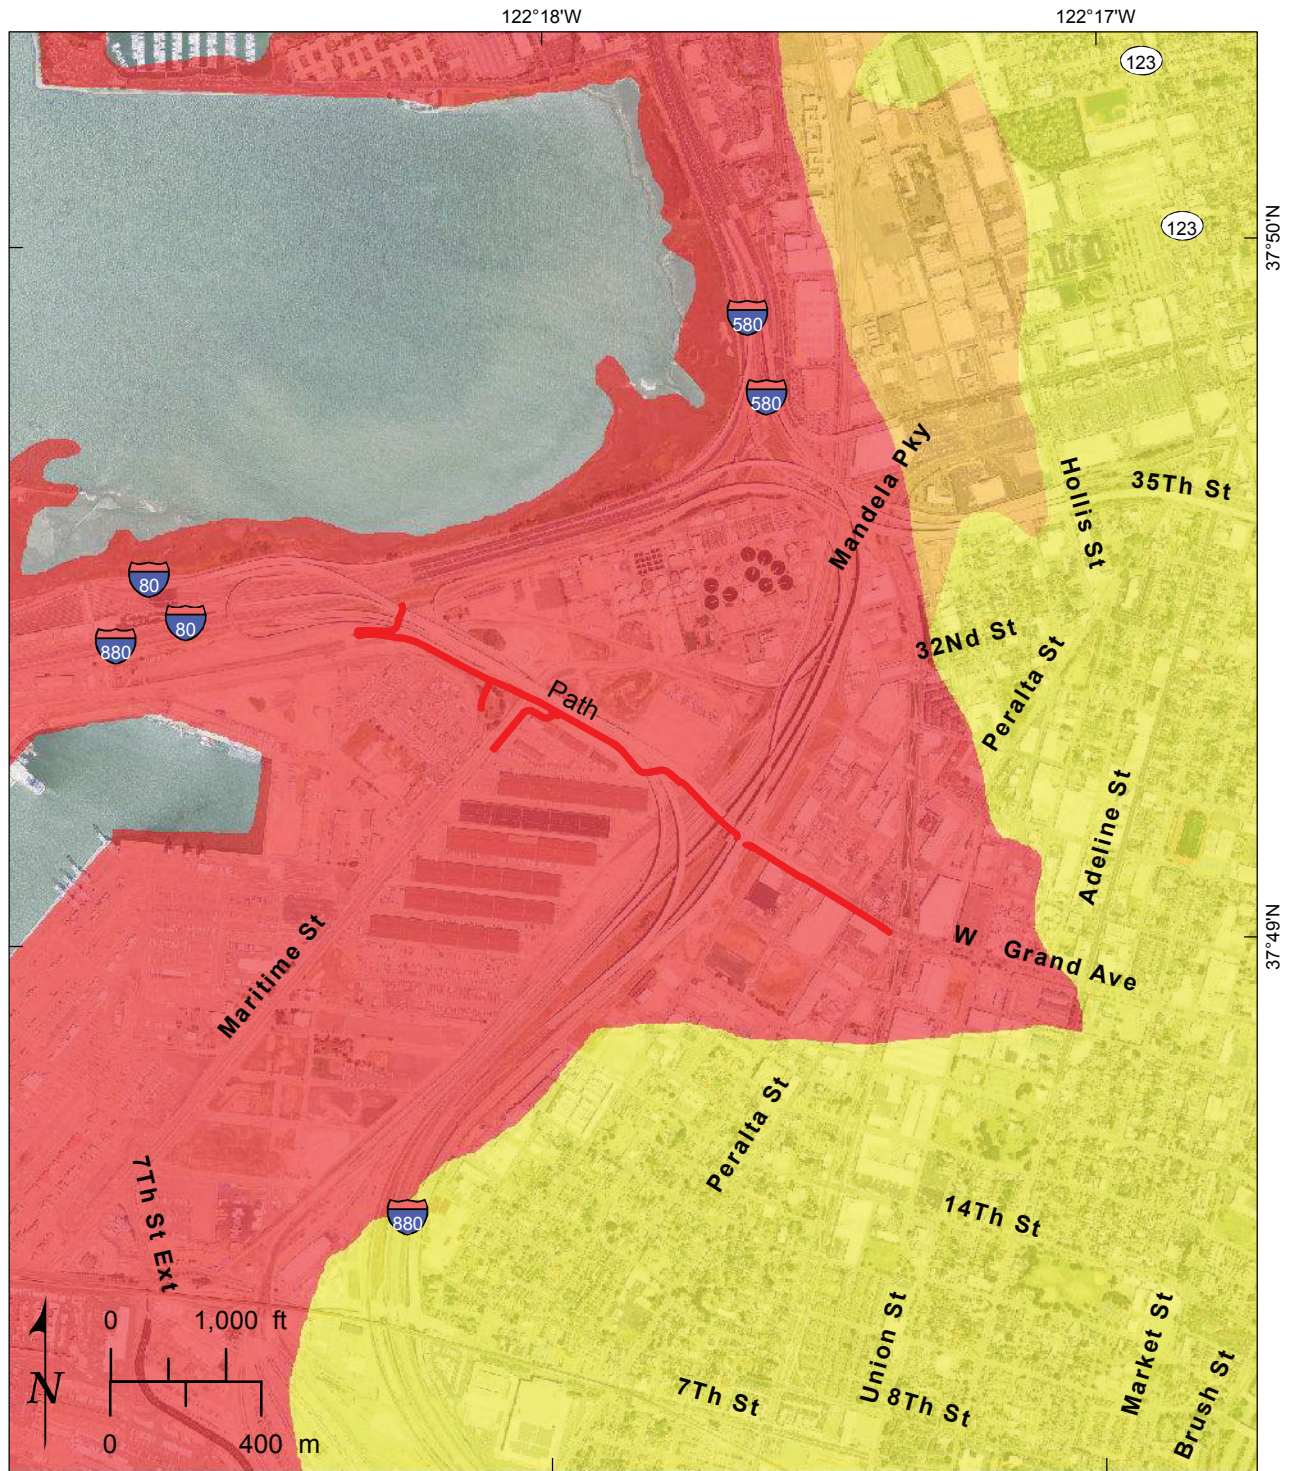



Liquefaction Susceptibility
 (Knudsen et al., 2000; USGS OFR 00-444)

- Very High
- High
- Moderate
- Low (not within map extent)
- Very Low (not within map extent)

Liquefaction Susceptibility in the Project Vicinity


San Francisco Oakland Bay Bridge
 Bicycle / Pedestrian Connection

FIGURE 5

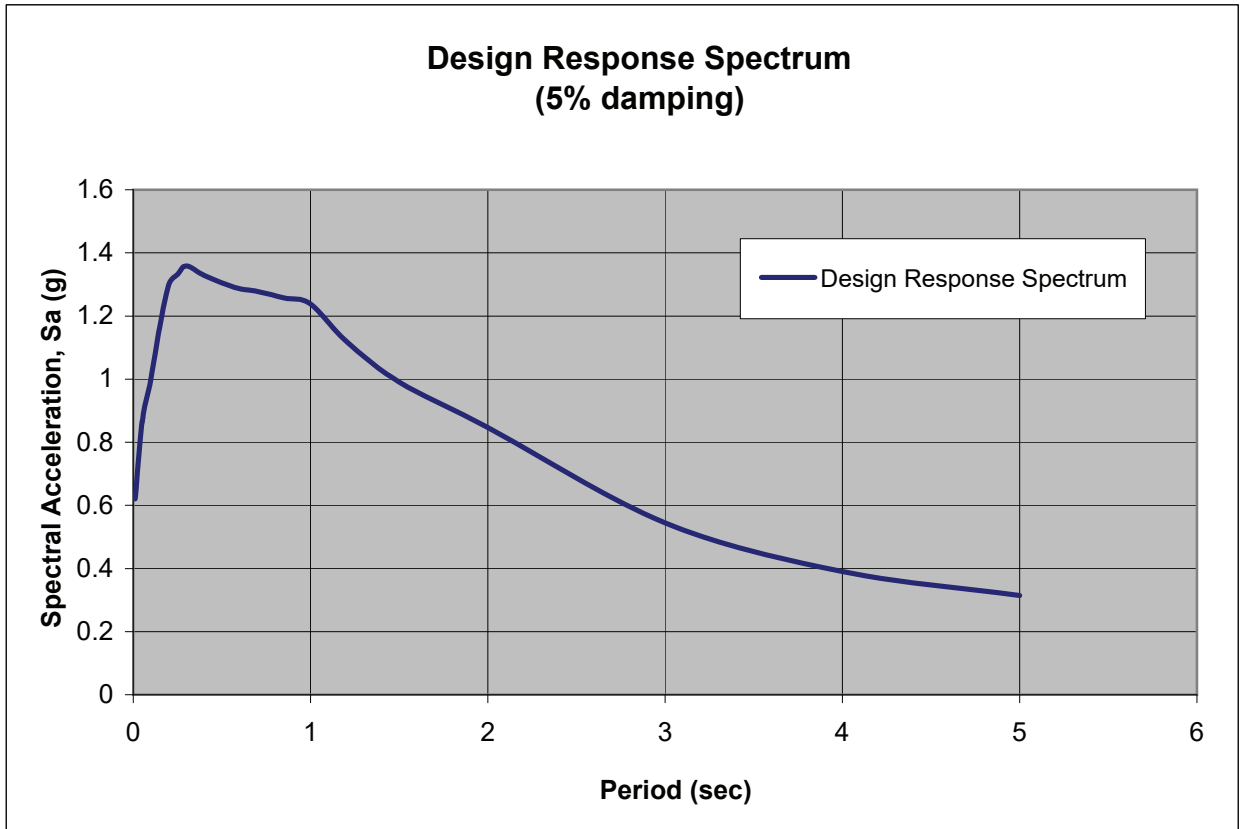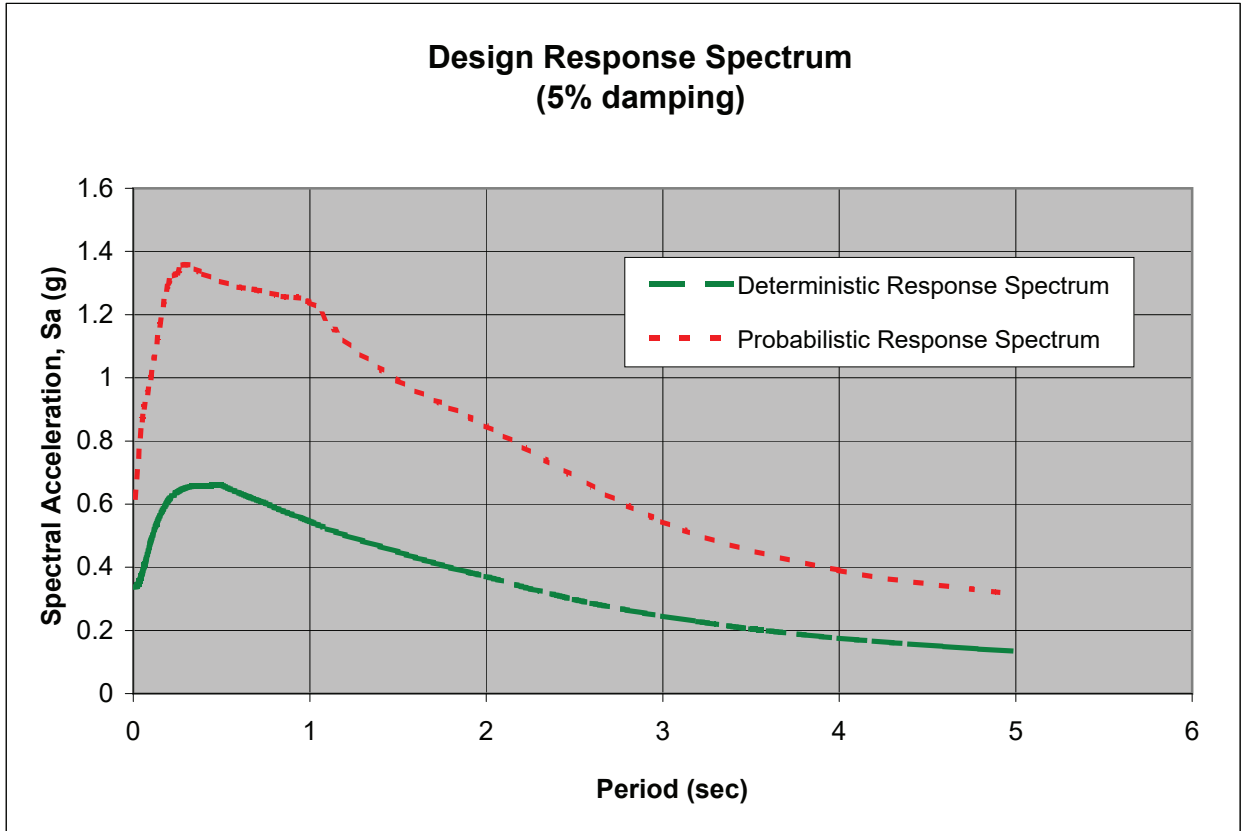

Recommended Acceleration Response Spectrum

Figure 6

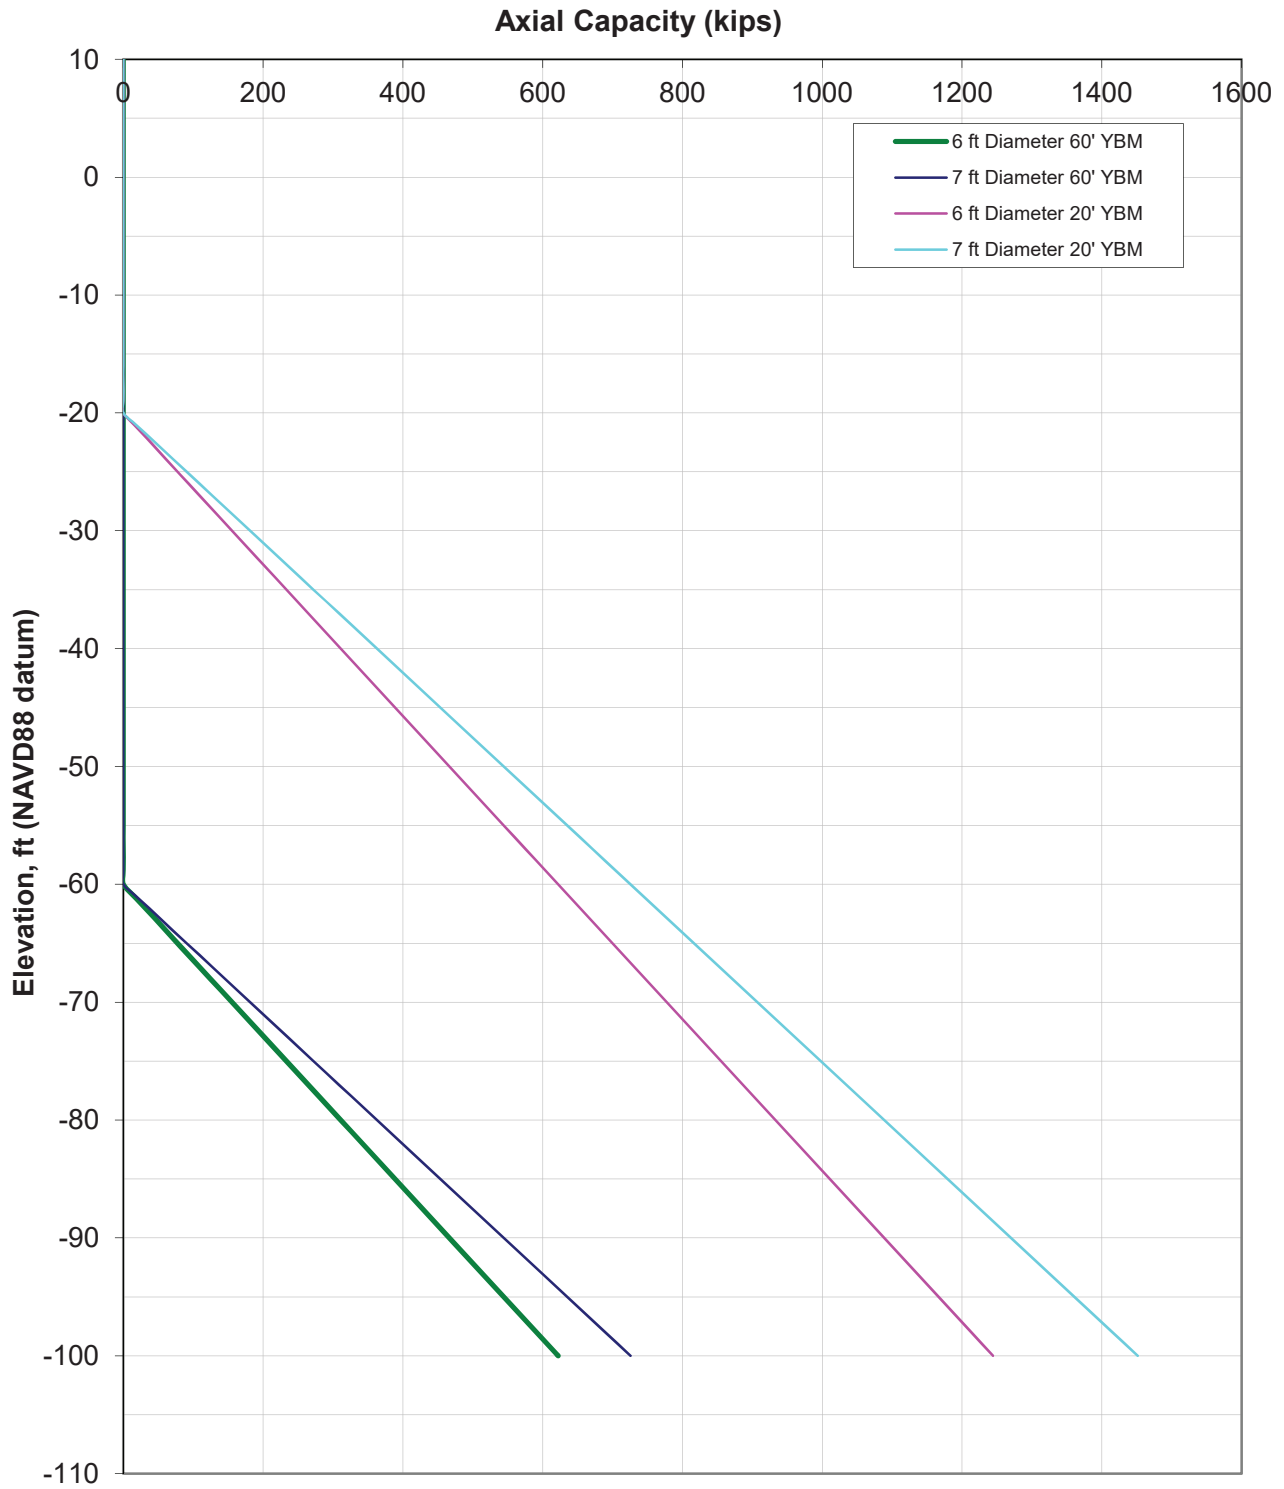

Gateway Park - The Connection
Cast-In-Drilled Holes (CIDH) Piles Ultimate Capacity

APPENDIX A
PROJECT LAYOUT PLANS

Drawing: P:\320142.00 Gateway Park\CADD\00 Shts\S-LINK-XXX-C-L001-50sc.dwg

STATE OF CALIFORNIA - DEPARTMENT OF TRANSPORTATION CONSULTANT FUNCTIONAL SUPERVISOR



CALCULATED-DESIGNED BY

CHECKED BY

REVISED BY


X

X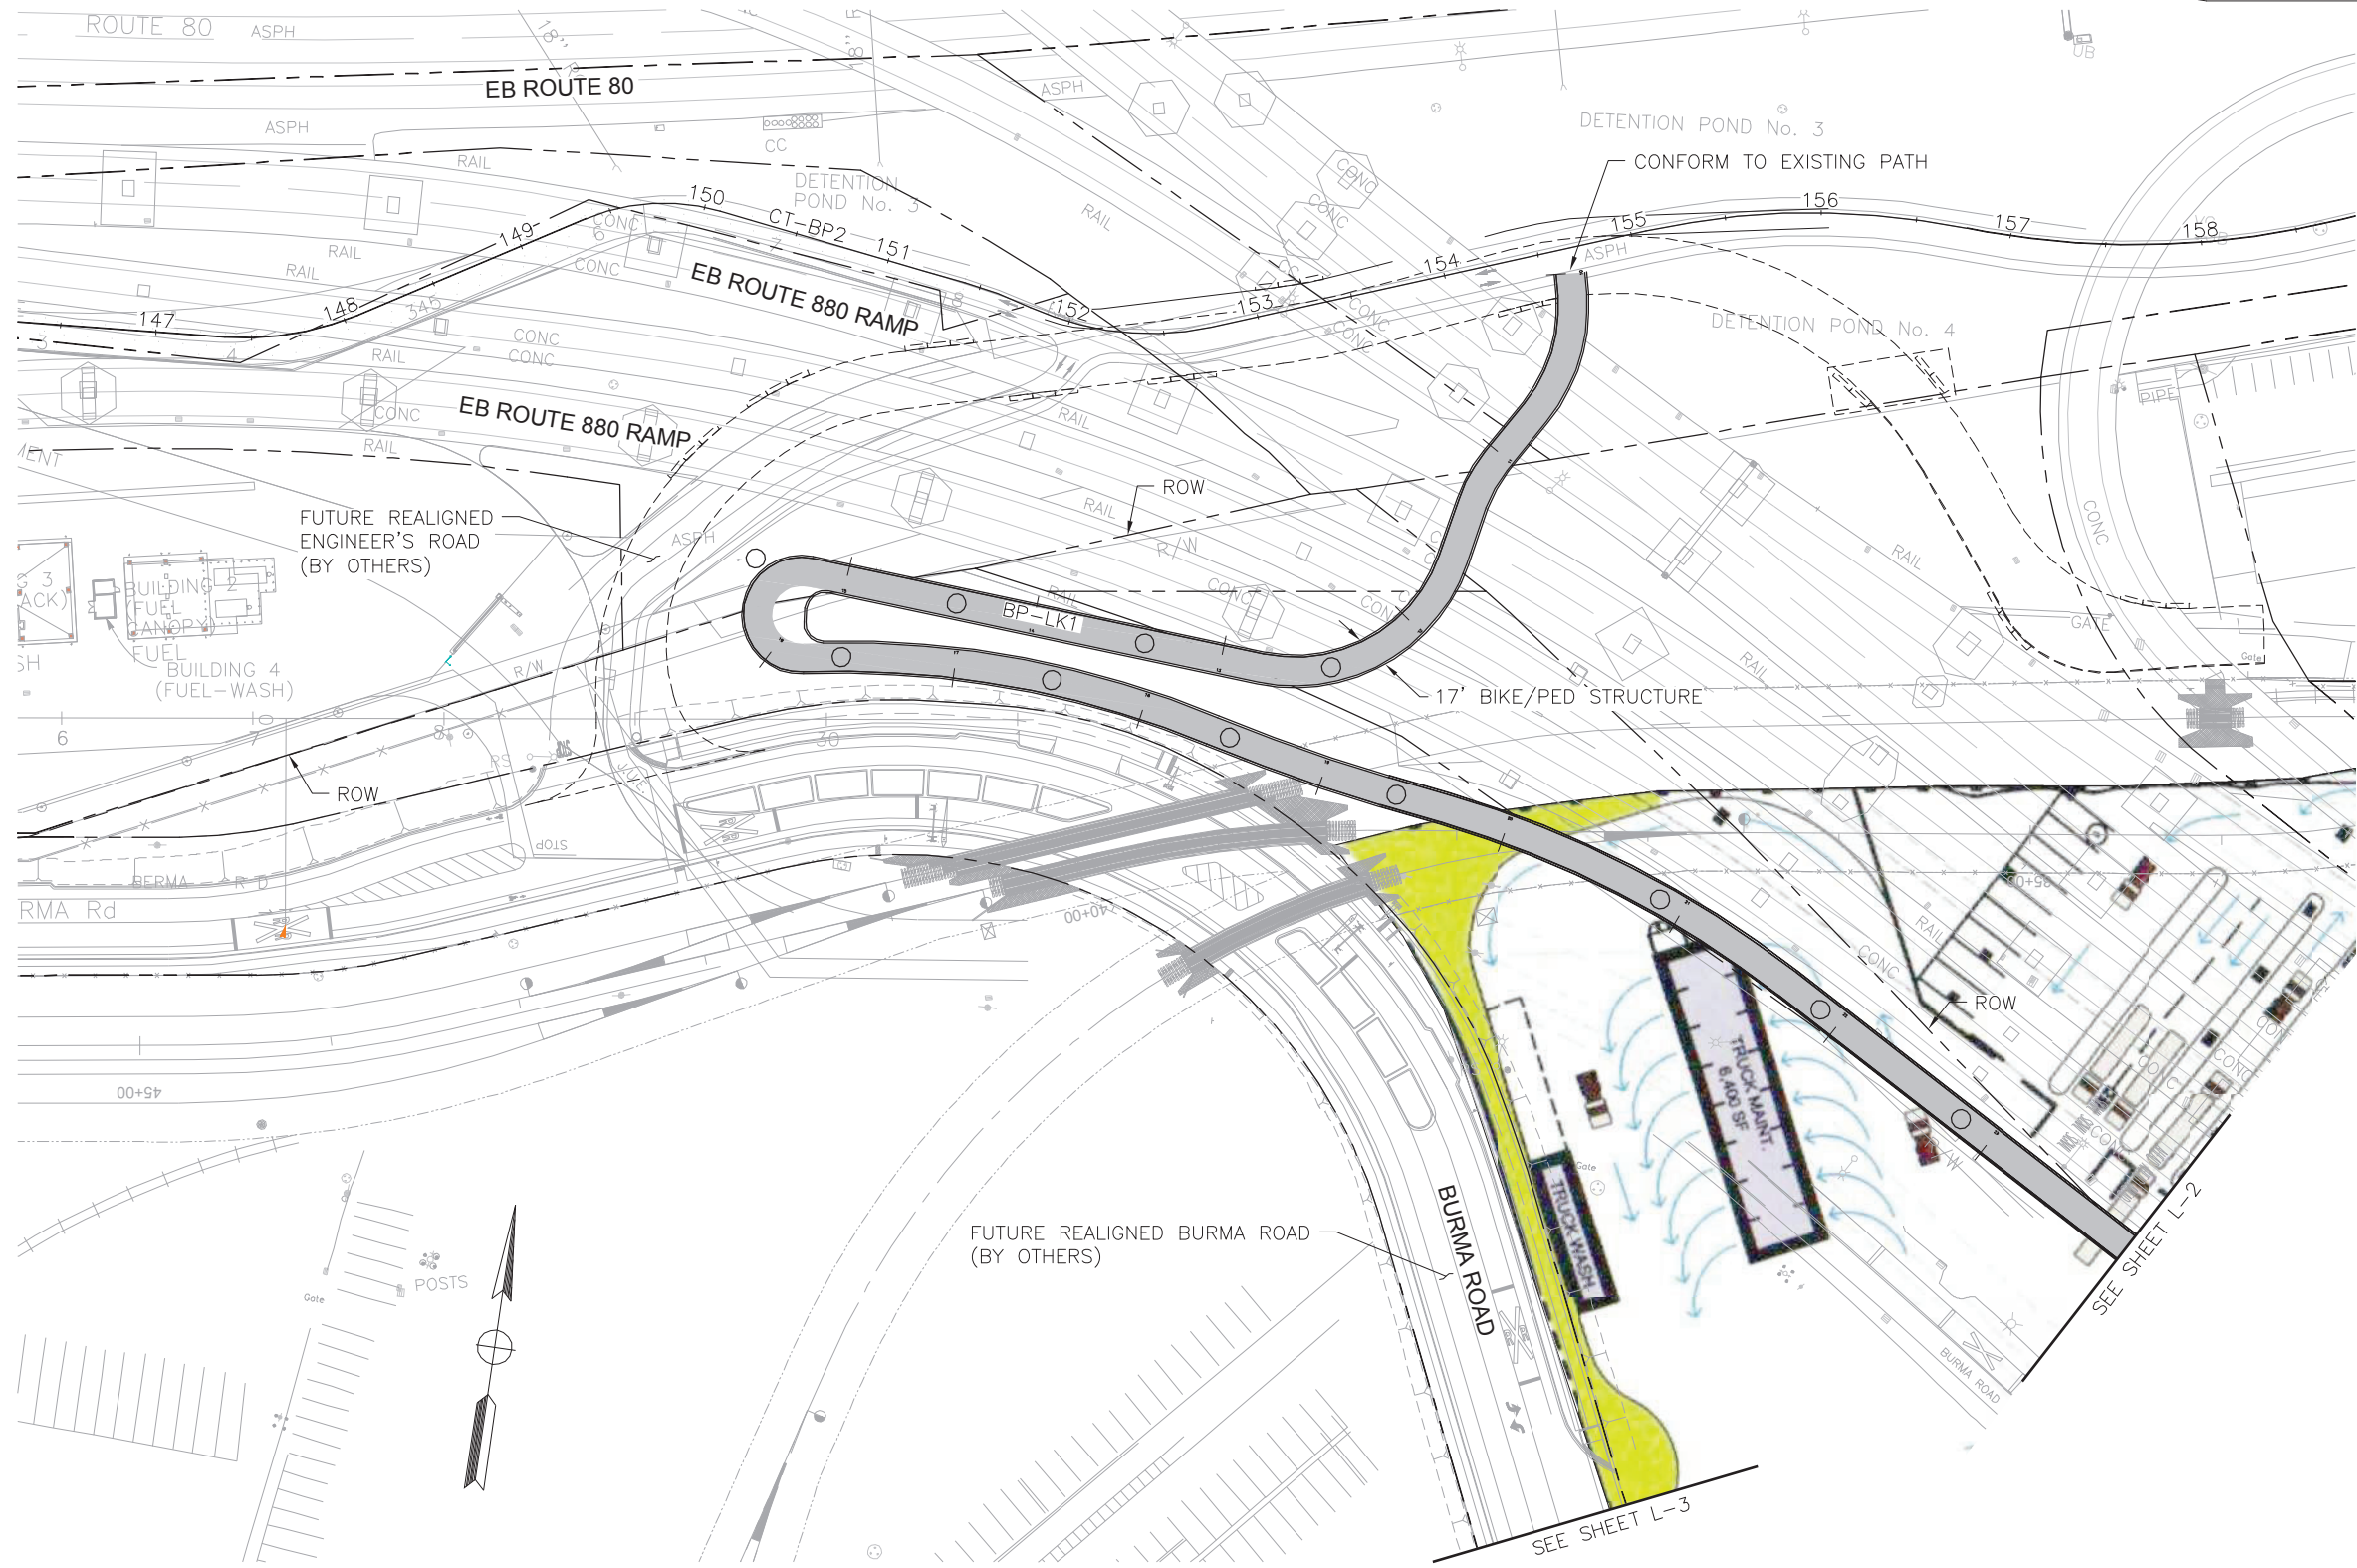

Dist	COUNTY	ROUTE	POST MILES TOTAL PROJECT	SHEET No.	TOTAL SHEETS

REGISTERED CIVIL ENGINEER DATE _____

PLANS APPROVAL DATE _____


THE STATE OF CALIFORNIA OR ITS OFFICERS OR AGENTS SHALL NOT BE RESPONSIBLE FOR THE ACCURACY OR COMPLETENESS OF SCANNED COPIES OF THIS PLAN SHEET.

BAY AREA TOLL AUTHORITY
101 EIGHT STREET
OAKLAND, CALIFORNIA 94607

T.Y. LIN INTERNATIONAL
1111 BROADWAY, SUITE 2150
OAKLAND, CALIFORNIA 94607




- NOTES:**
- XXXXXXXXXXXXXXXX
 - XXXXXXXXXXXXXXXX

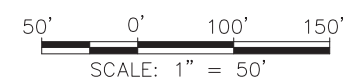

LAYOUT
Scale: 1"=50'

PRELIMINARY PLAN

L-1

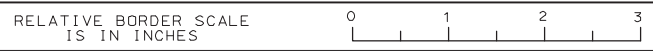

EA XX-XXXX



LAST REVISION
06-05-14




DIST	COUNTY	ROUTE	POST MILES TOTAL PROJECT	SHEET No.	TOTAL SHEETS
REGISTERED CIVIL ENGINEER DATE _____					
PLANS APPROVAL DATE _____					
<small>THE STATE OF CALIFORNIA OR ITS OFFICERS OR AGENTS SHALL NOT BE RESPONSIBLE FOR THE ACCURACY OR COMPLETENESS OF SCANNED COPIES OF THIS PLAN SHEET.</small>					
BAY AREA TOLL AUTHORITY 101 EIGHT STREET OAKLAND, CALIFORNIA 94607					
T.Y. LIN INTERNATIONAL 1111 BROADWAY, SUITE 2150 OAKLAND, CALIFORNIA 94607					



- NOTES:**
- XXXXXXXXXXXXXXXX
 - XXXXXXXXXXXXXXXX

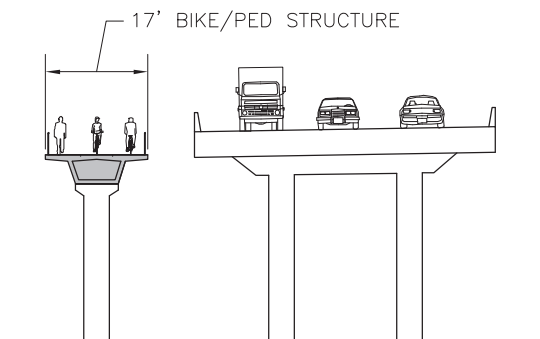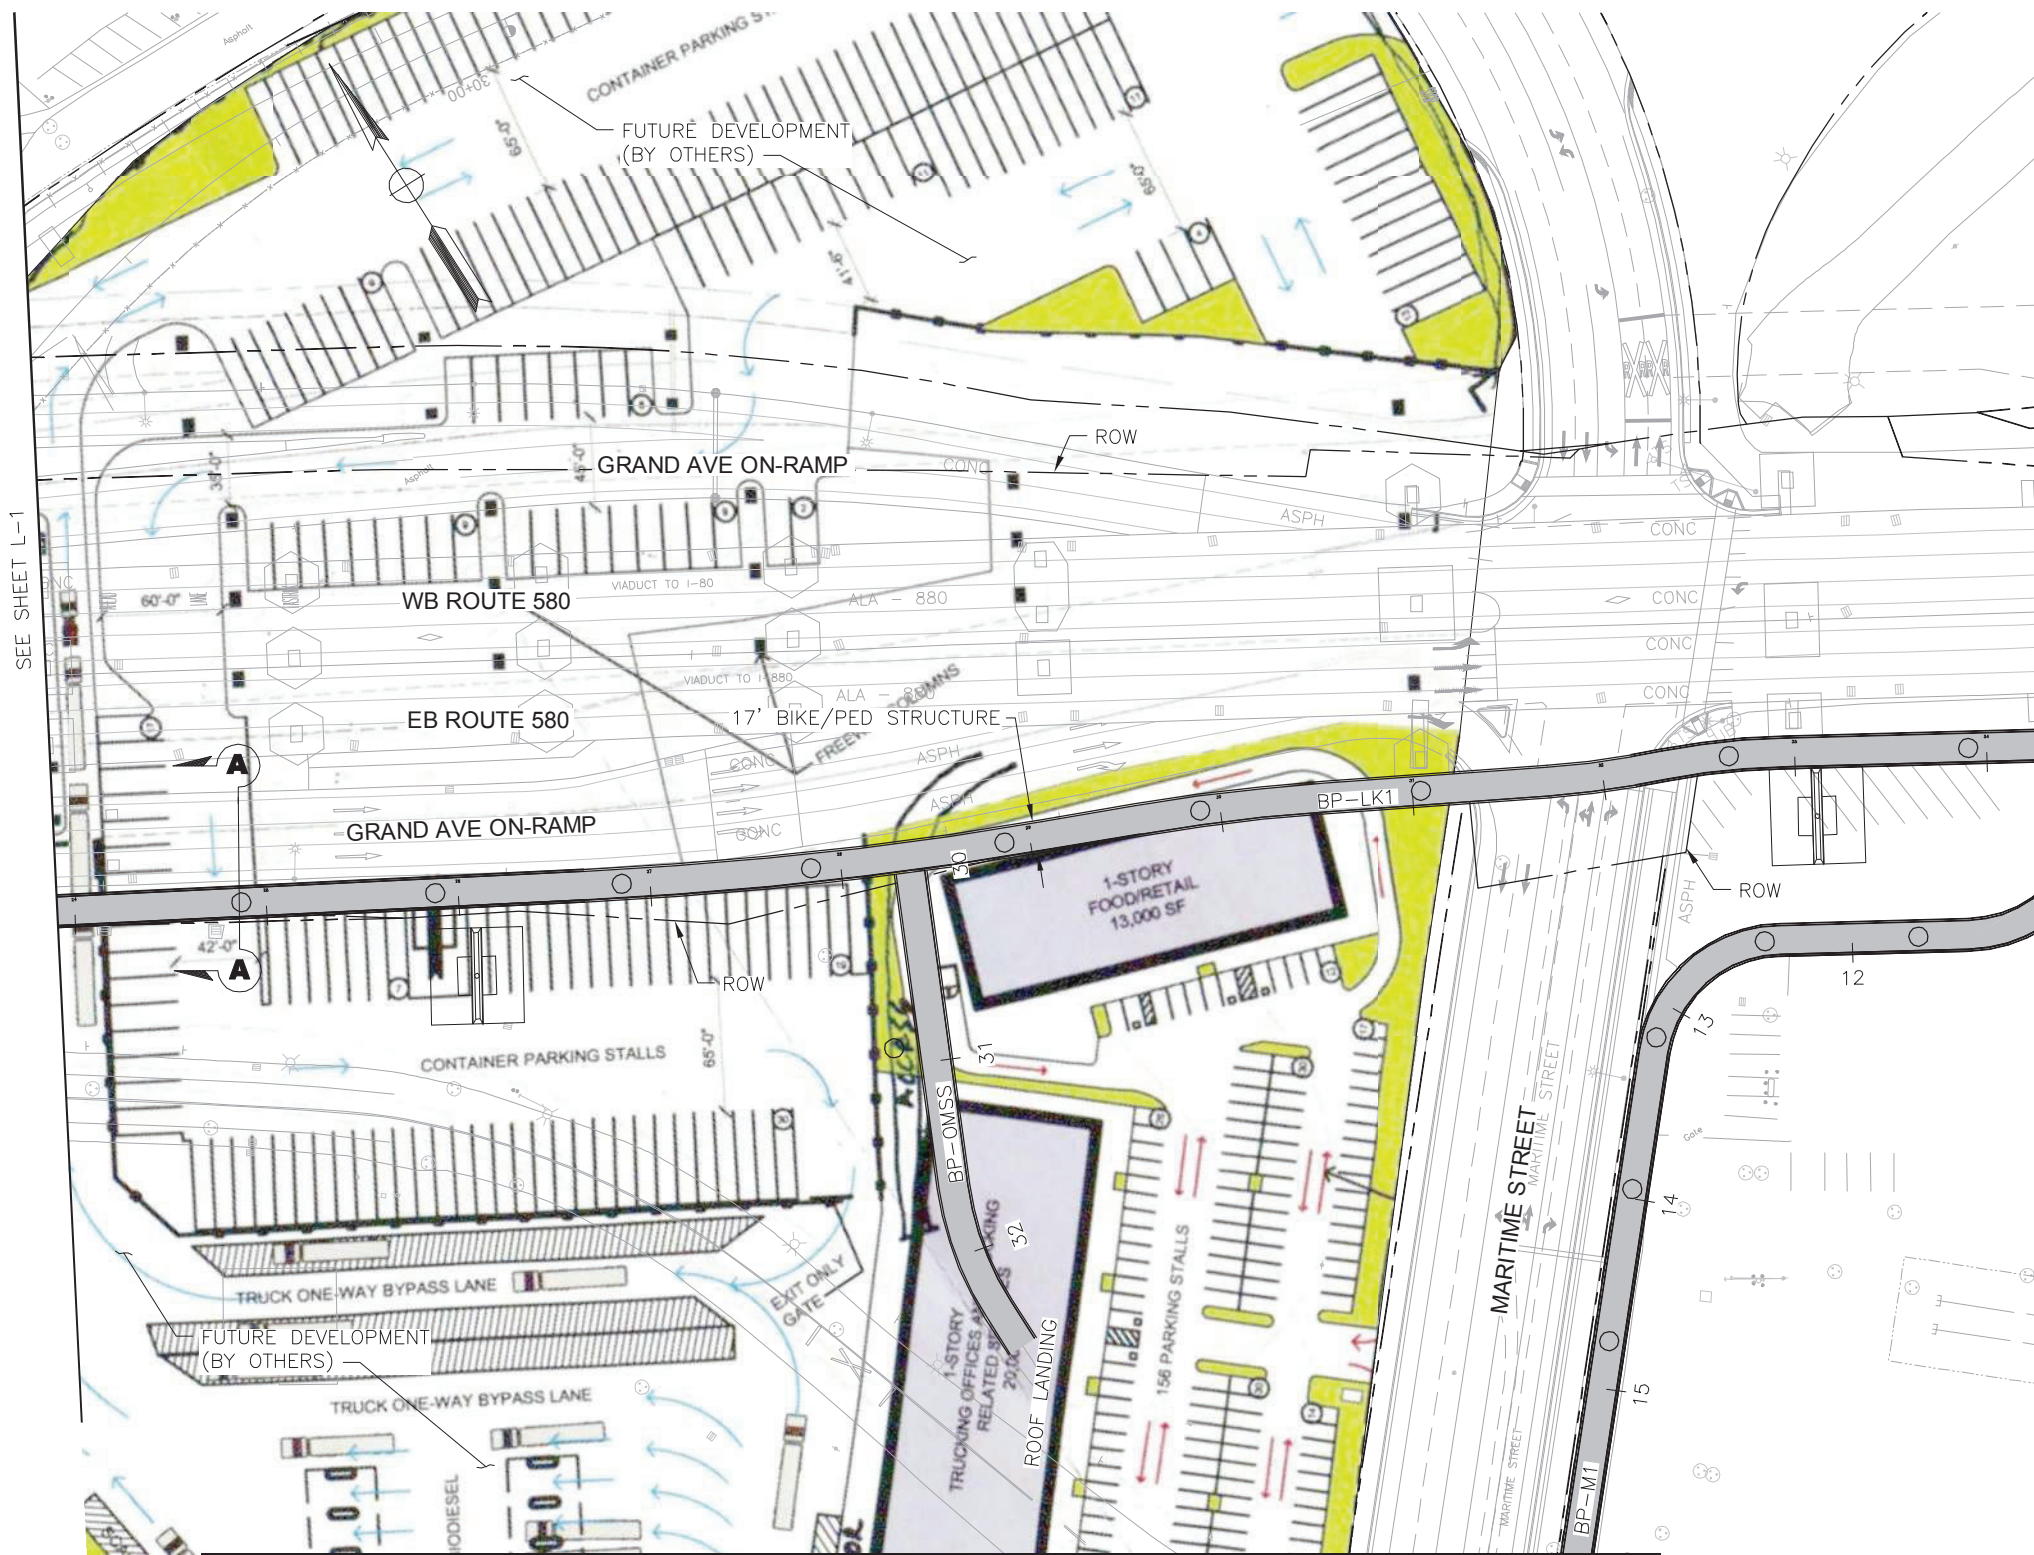

PROPOSED SECTION A-A
NTS

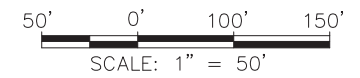

LAYOUT
Scale: 1"=50'

PRELIMINARY PLAN

L-2

SEE SHEET L-3

SEE SHEET L-1

SEE SHEET L-4





Drawing: P:\320142.00 Gateway Park\CADD\00 Shits\S-LINK-XXX-C-L003-50sc.dwg

STATE OF CALIFORNIA - DEPARTMENT OF TRANSPORTATION

CONSULTANT FUNCTIONAL SUPERVISOR

CALCULATED BY DESIGNED BY

REVISOR BY

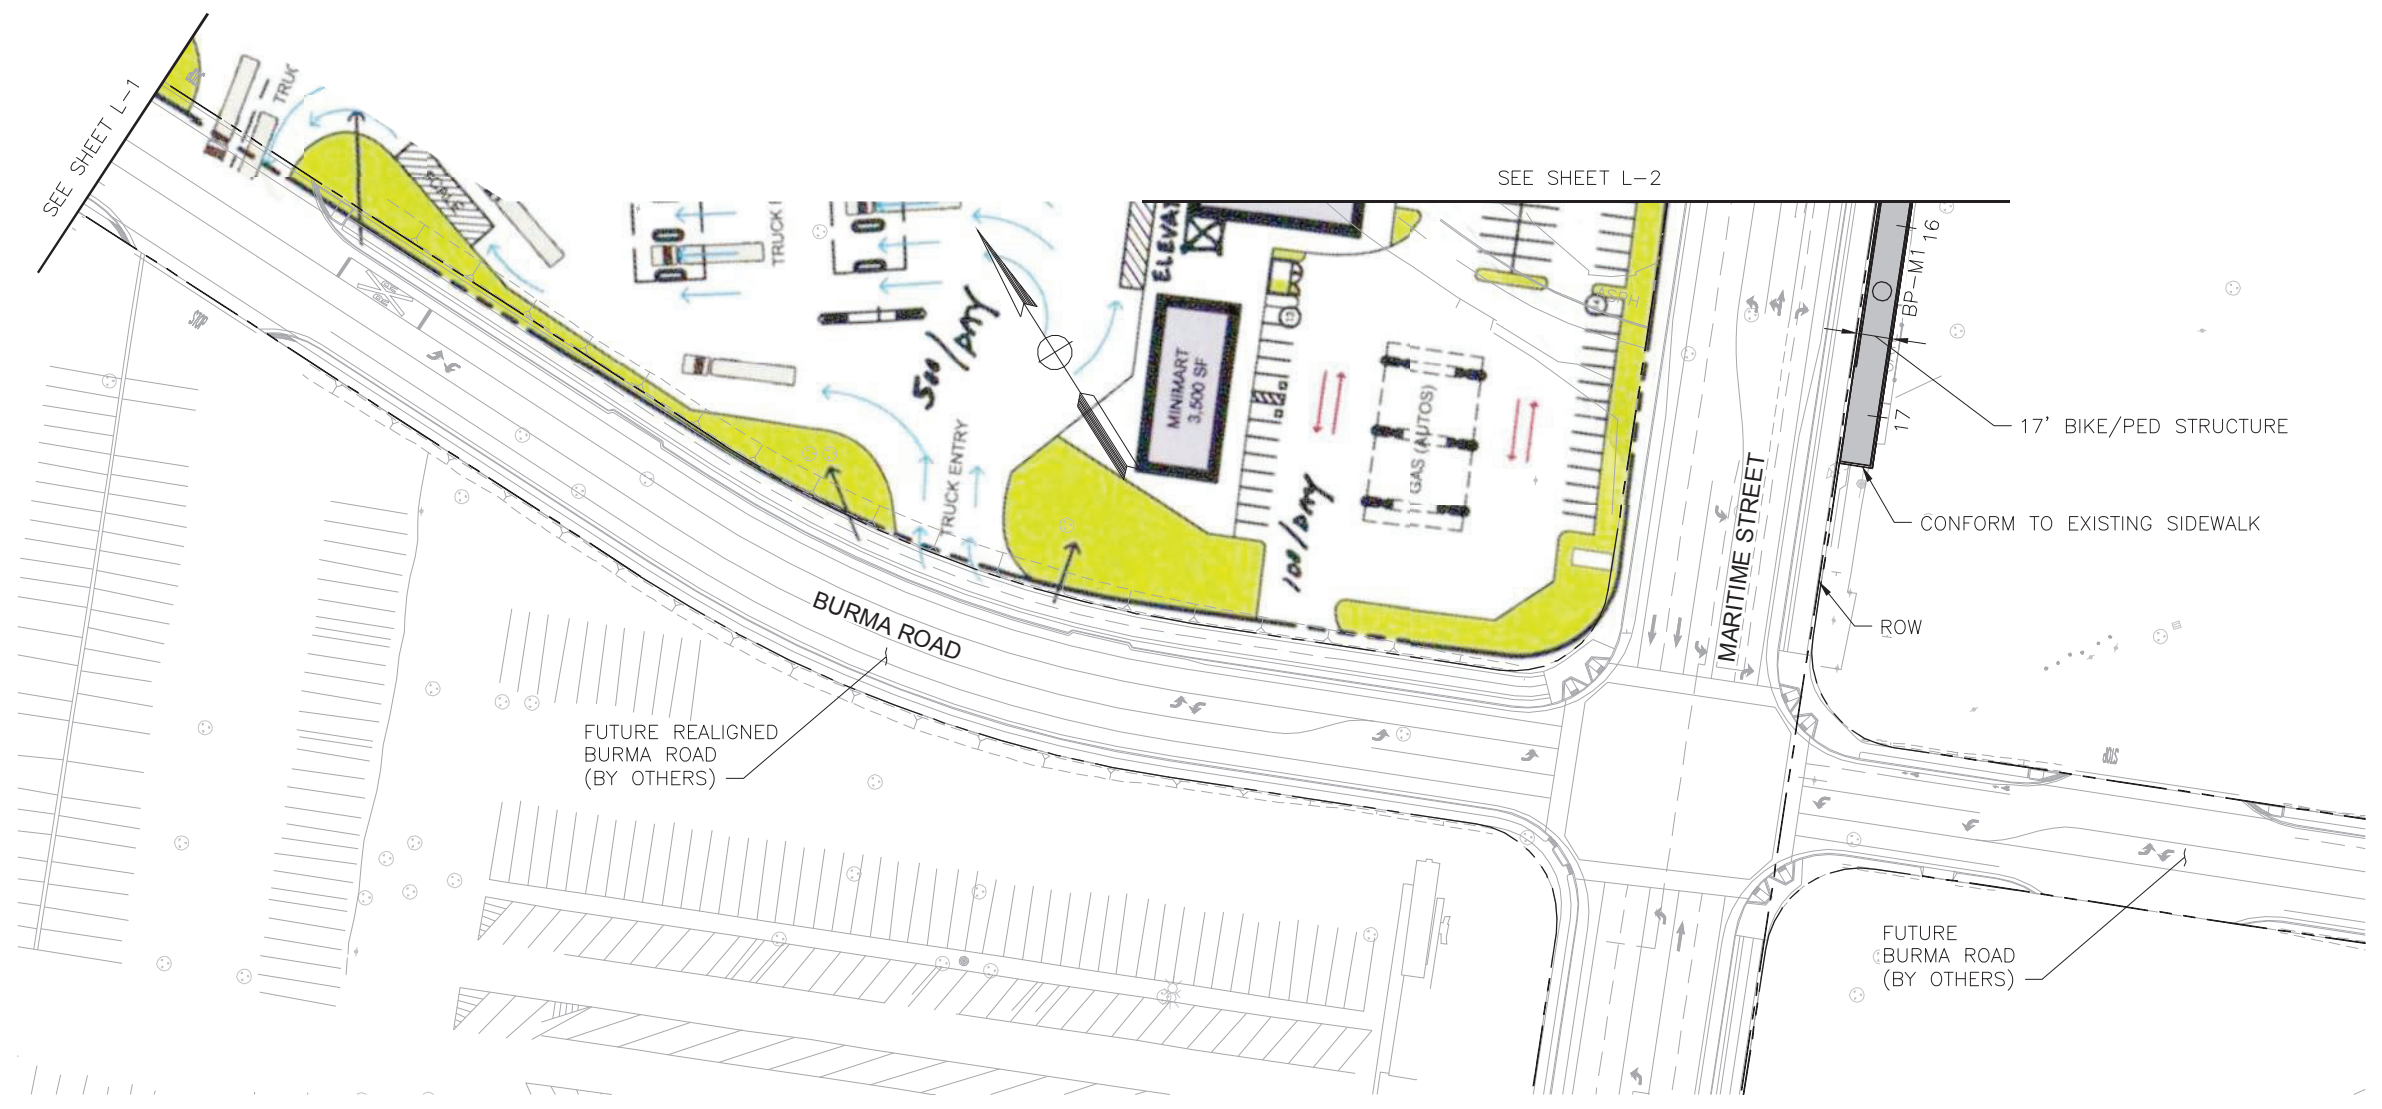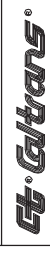

Dist	COUNTY	ROUTE	POST MILES TOTAL PROJECT	SHEET NO.	TOTAL SHEETS
------	--------	-------	--------------------------	-----------	--------------

REGISTERED CIVIL ENGINEER DATE _____

PLANS APPROVAL DATE _____


THE STATE OF CALIFORNIA OR ITS OFFICERS OR AGENTS SHALL NOT BE RESPONSIBLE FOR THE ACCURACY OR COMPLETENESS OF SCANNED COPIES OF THIS PLAN SHEET.

BAY AREA TOLL AUTHORITY
101 EIGHT STREET
OAKLAND, CALIFORNIA 94607

T.Y. LIN INTERNATIONAL
1111 BROADWAY, SUITE 2150
OAKLAND, CALIFORNIA 94607




- NOTES:**
- XXXXXXXXXXXXXXXX
 - XXXXXXXXXXXXXXXX

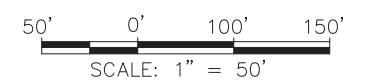

LAYOUT
Scale: 1"=50'

PRELIMINARY PLAN

L-3

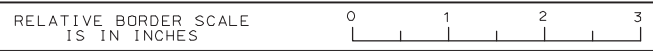

EA XX-XXXX

LAST REVISION
06-05-14

Drawing: P:\320142.00 Gateway Park\CADD\00 Shts\S-LINK-XXX-C-L004-50sc.dwg

STATE OF CALIFORNIA - DEPARTMENT OF TRANSPORTATION




CONSULTANT FUNCTIONAL SUPERVISOR

CALCULATED-DESIGNED BY

REVISED BY

CHECKED BY

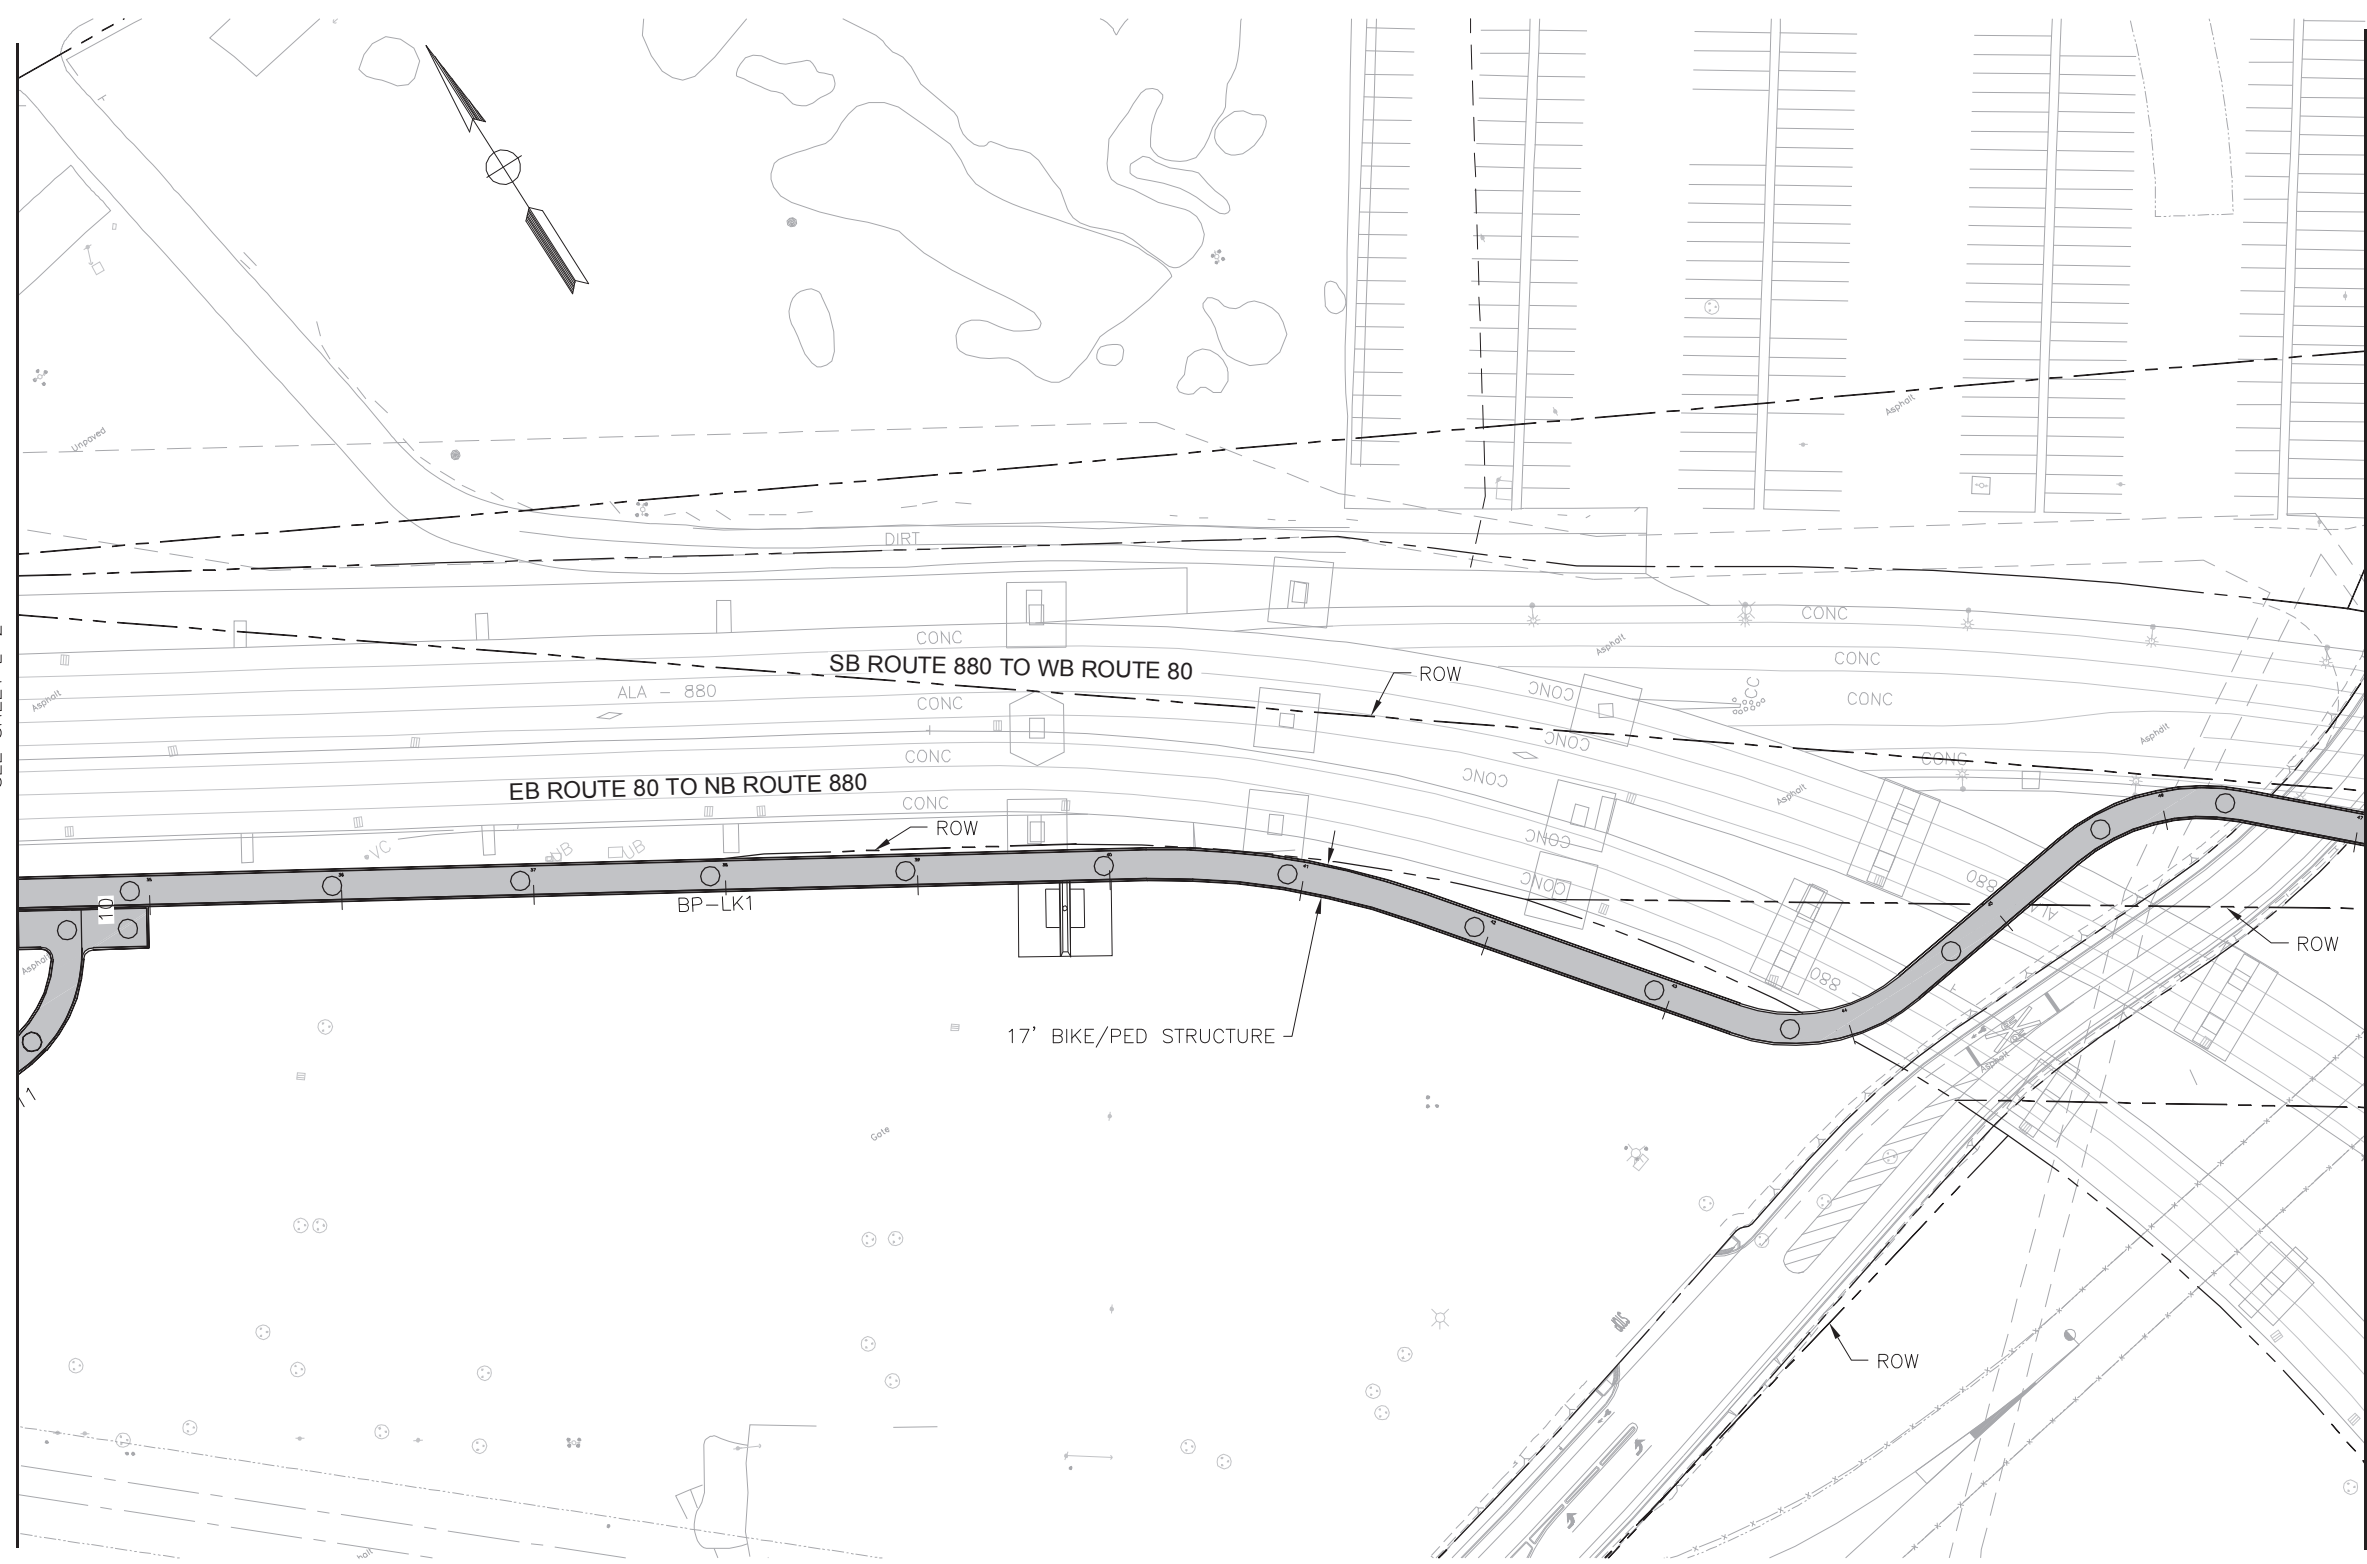

Dist	COUNTY	ROUTE	POST MILES TOTAL PROJECT	SHEET No.	TOTAL SHEETS


REGISTERED CIVIL ENGINEER DATE _____
 PLANS APPROVAL DATE _____
 THE STATE OF CALIFORNIA OR ITS OFFICERS OR AGENTS SHALL NOT BE RESPONSIBLE FOR THE ACCURACY OR COMPLETENESS OF SCANNED COPIES OF THIS PLAN SHEET.



BAY AREA TOLL AUTHORITY
 101 EIGHT STREET
 OAKLAND, CALIFORNIA 94607

T.Y. LIN INTERNATIONAL
 1111 BROADWAY, SUITE 2150
 OAKLAND, CALIFORNIA 94607


- NOTES:**
- XXXXXXXXXXXXXXXX
 - XXXXXXXXXXXXXXXX

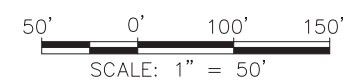

LAYOUT
 Scale: 1"=50'

PRELIMINARY PLAN

L-4

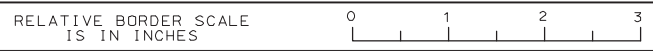

EA XX-XXXXX




LAST REVISION
 06-05-14

P:\320142.00 Gateway Park\CADD\00 Shits\S-LINK-XXX-C-L005-50sc.dwg

STATE OF CALIFORNIA - DEPARTMENT OF TRANSPORTATION CONSULTANT FUNCTIONAL SUPERVISOR



DESIGNED BY	REVISOR
CHECKED BY	REVISION
CALCULATED/DESIGNED BY	DATE

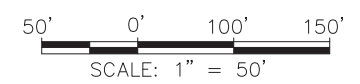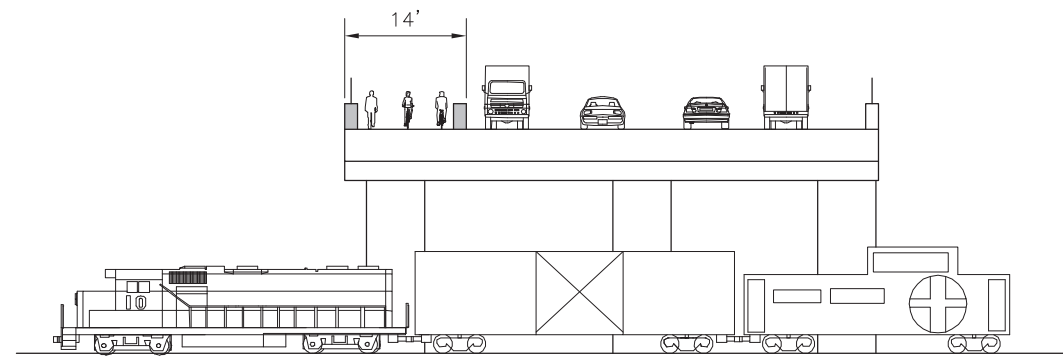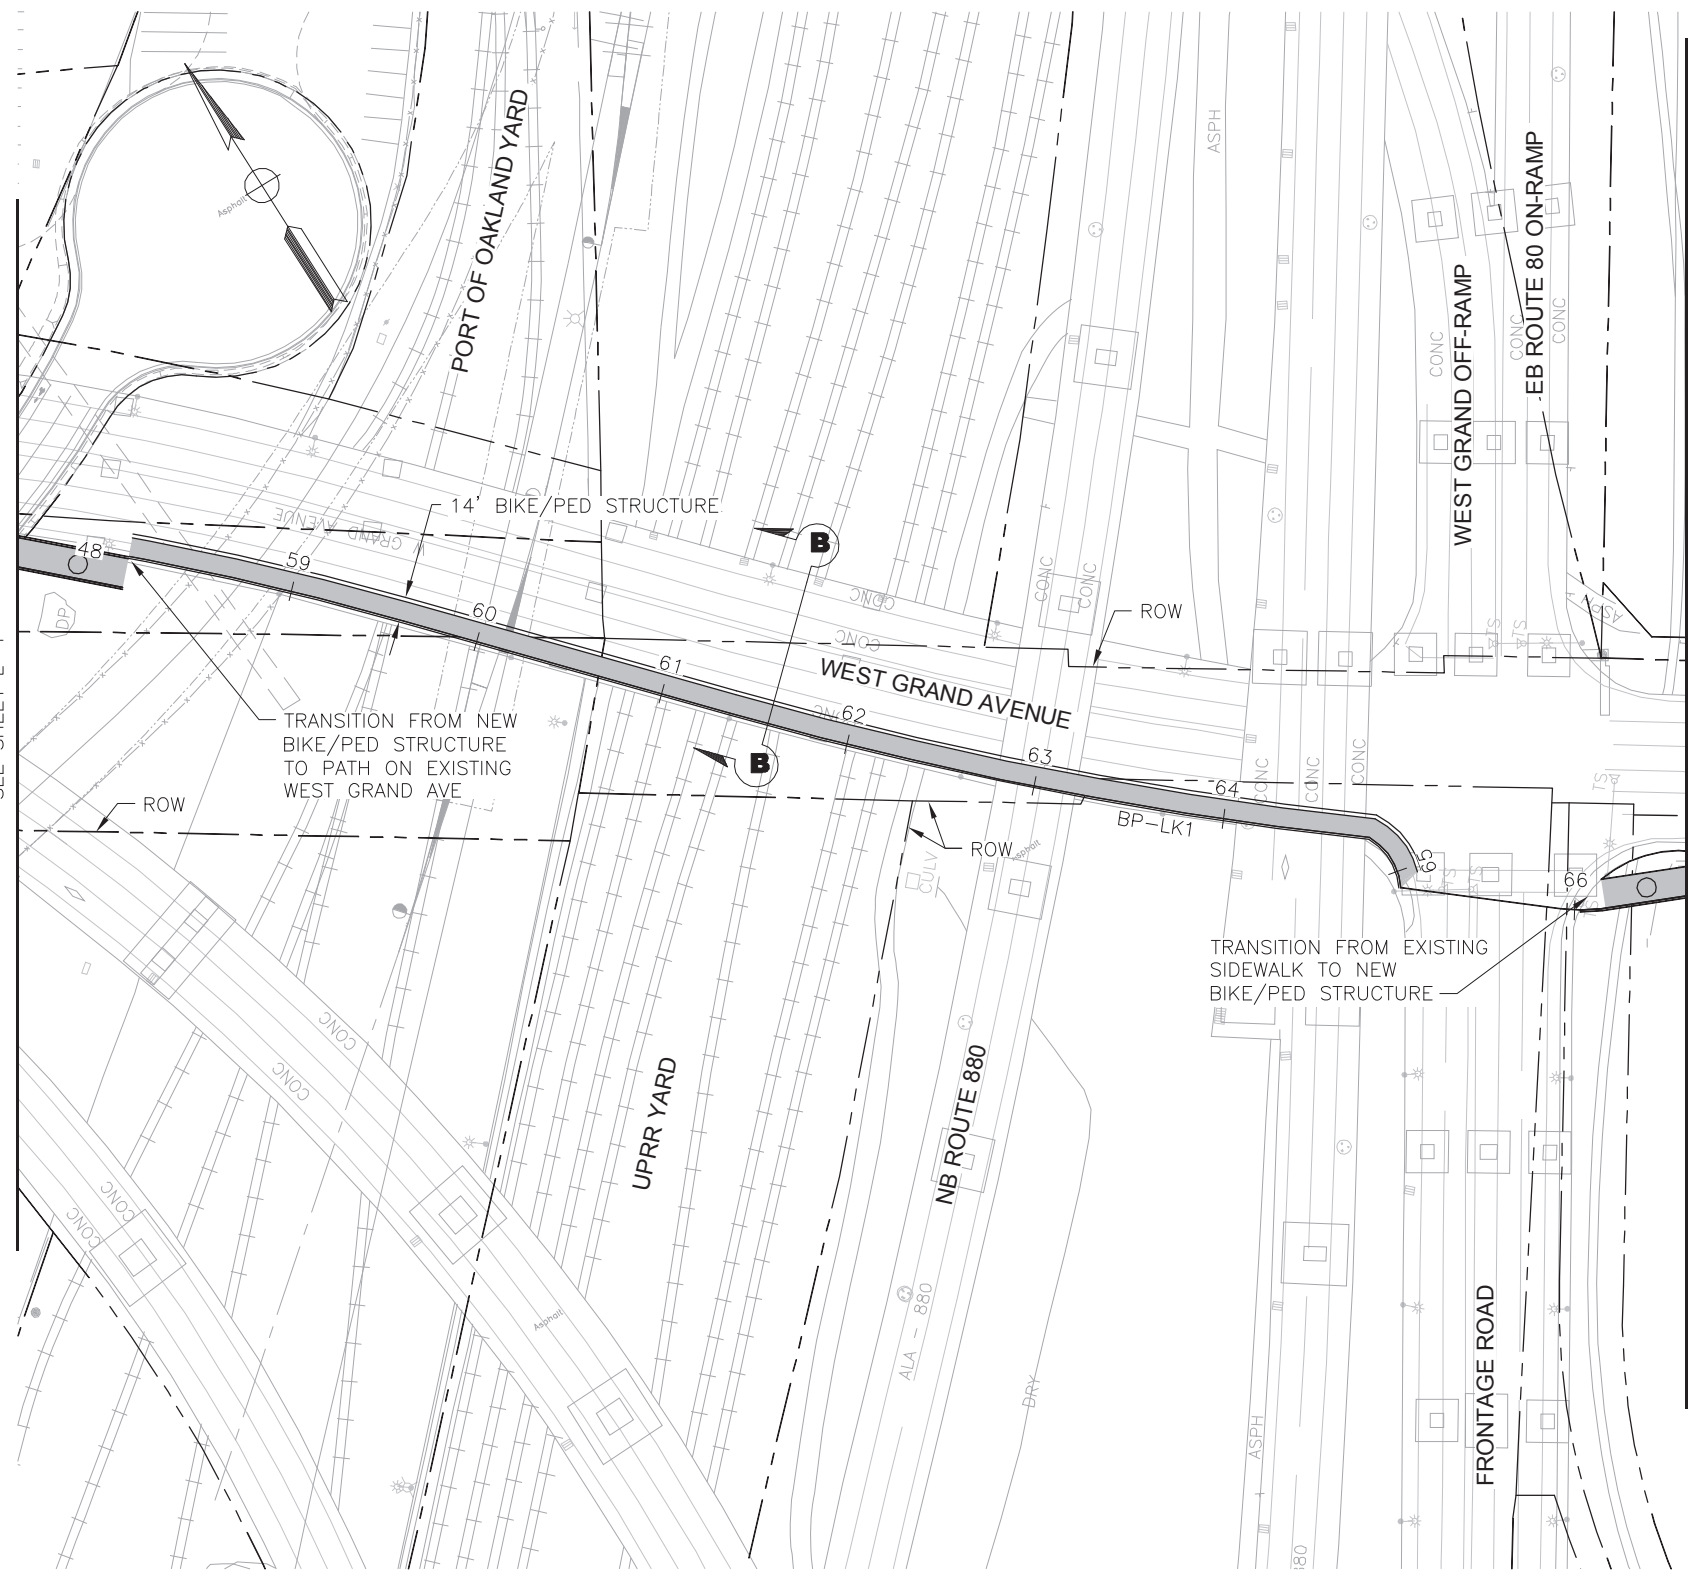

LAYOUT
Scale: 1"=50'




Dist	COUNTY	ROUTE	POST MILES TOTAL PROJECT	SHEET No.	TOTAL SHEETS
REGISTERED CIVIL ENGINEER DATE					
PLANS APPROVAL DATE					
<small>THE STATE OF CALIFORNIA OR ITS OFFICERS OR AGENTS SHALL NOT BE RESPONSIBLE FOR THE ACCURACY OR COMPLETENESS OF SCANNED COPIES OF THIS PLAN SHEET.</small>					
BAY AREA TOLL AUTHORITY 101 EIGHT STREET OAKLAND, CALIFORNIA 94607					
T.Y. LIN INTERNATIONAL 1111 BROADWAY, SUITE 2150 OAKLAND, CALIFORNIA 94607					



- NOTES:
- XXXXXXXXXXXXXXXXXX
 - XXXXXXXXXXXXXXXXXX

PRELIMINARY PLAN


L-5

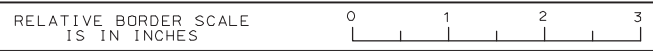

EA XX-XXXXX

LAST REVISION
06-05-14

Drawing: P:\320142.00 Gateway Park\CADD\00 Shts\S-LINK-XXX-C-L006-50sc.dwg
 STATE OF CALIFORNIA - DEPARTMENT OF TRANSPORTATION CONSULTANT FUNCTIONAL SUPERVISOR

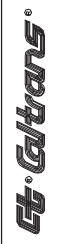


DESIGNED BY	REVISIONS
CHECKED BY	DATE
CALCULATED BY	BY
DESIGNED BY	BY




Dist	COUNTY	ROUTE	POST MILES TOTAL PROJECT	SHEET No.	TOTAL SHEETS
REGISTERED CIVIL ENGINEER DATE					
PLANS APPROVAL DATE					
<small>THE STATE OF CALIFORNIA OR ITS OFFICERS OR AGENTS SHALL NOT BE RESPONSIBLE FOR THE ACCURACY OR COMPLETENESS OF SCANNED COPIES OF THIS PLAN SHEET.</small>					
BAY AREA TOLL AUTHORITY 101 EIGHT STREET OAKLAND, CALIFORNIA 94607					
T.Y. LIN INTERNATIONAL 1111 BROADWAY, SUITE 2150 OAKLAND, CALIFORNIA 94607					

- NOTES:**
- XXXXXXXXXXXXXXXX
 - XXXXXXXXXXXXXXXX

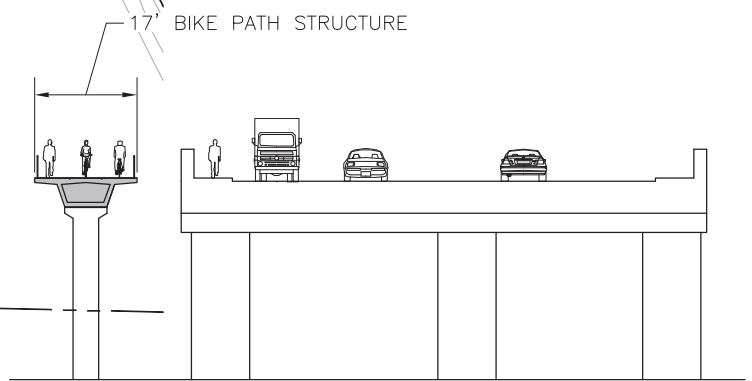


PROPOSED SECTION C-C
NTS

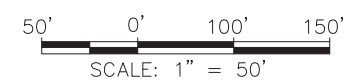

LAYOUT
Scale: 1"=50'

PRELIMINARY PLAN

L-6

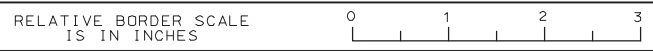

EA XX-XXXXX

LAST REVISION
06-05-14


Drawing: P:\320142.00 Gateway Park\CADD\00 Shits\S-LINK-XXX-C-L007-50sc.dwg

STATE OF CALIFORNIA - DEPARTMENT OF TRANSPORTATION CONSULTANT FUNCTIONAL SUPERVISOR


REVISOR BY DESIGNED BY CHECKED BY

REVISOR BY DESIGNED BY CHECKED BY

REVISOR BY DESIGNED BY CHECKED BY

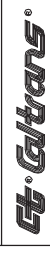

PRELIMINARY PLAN

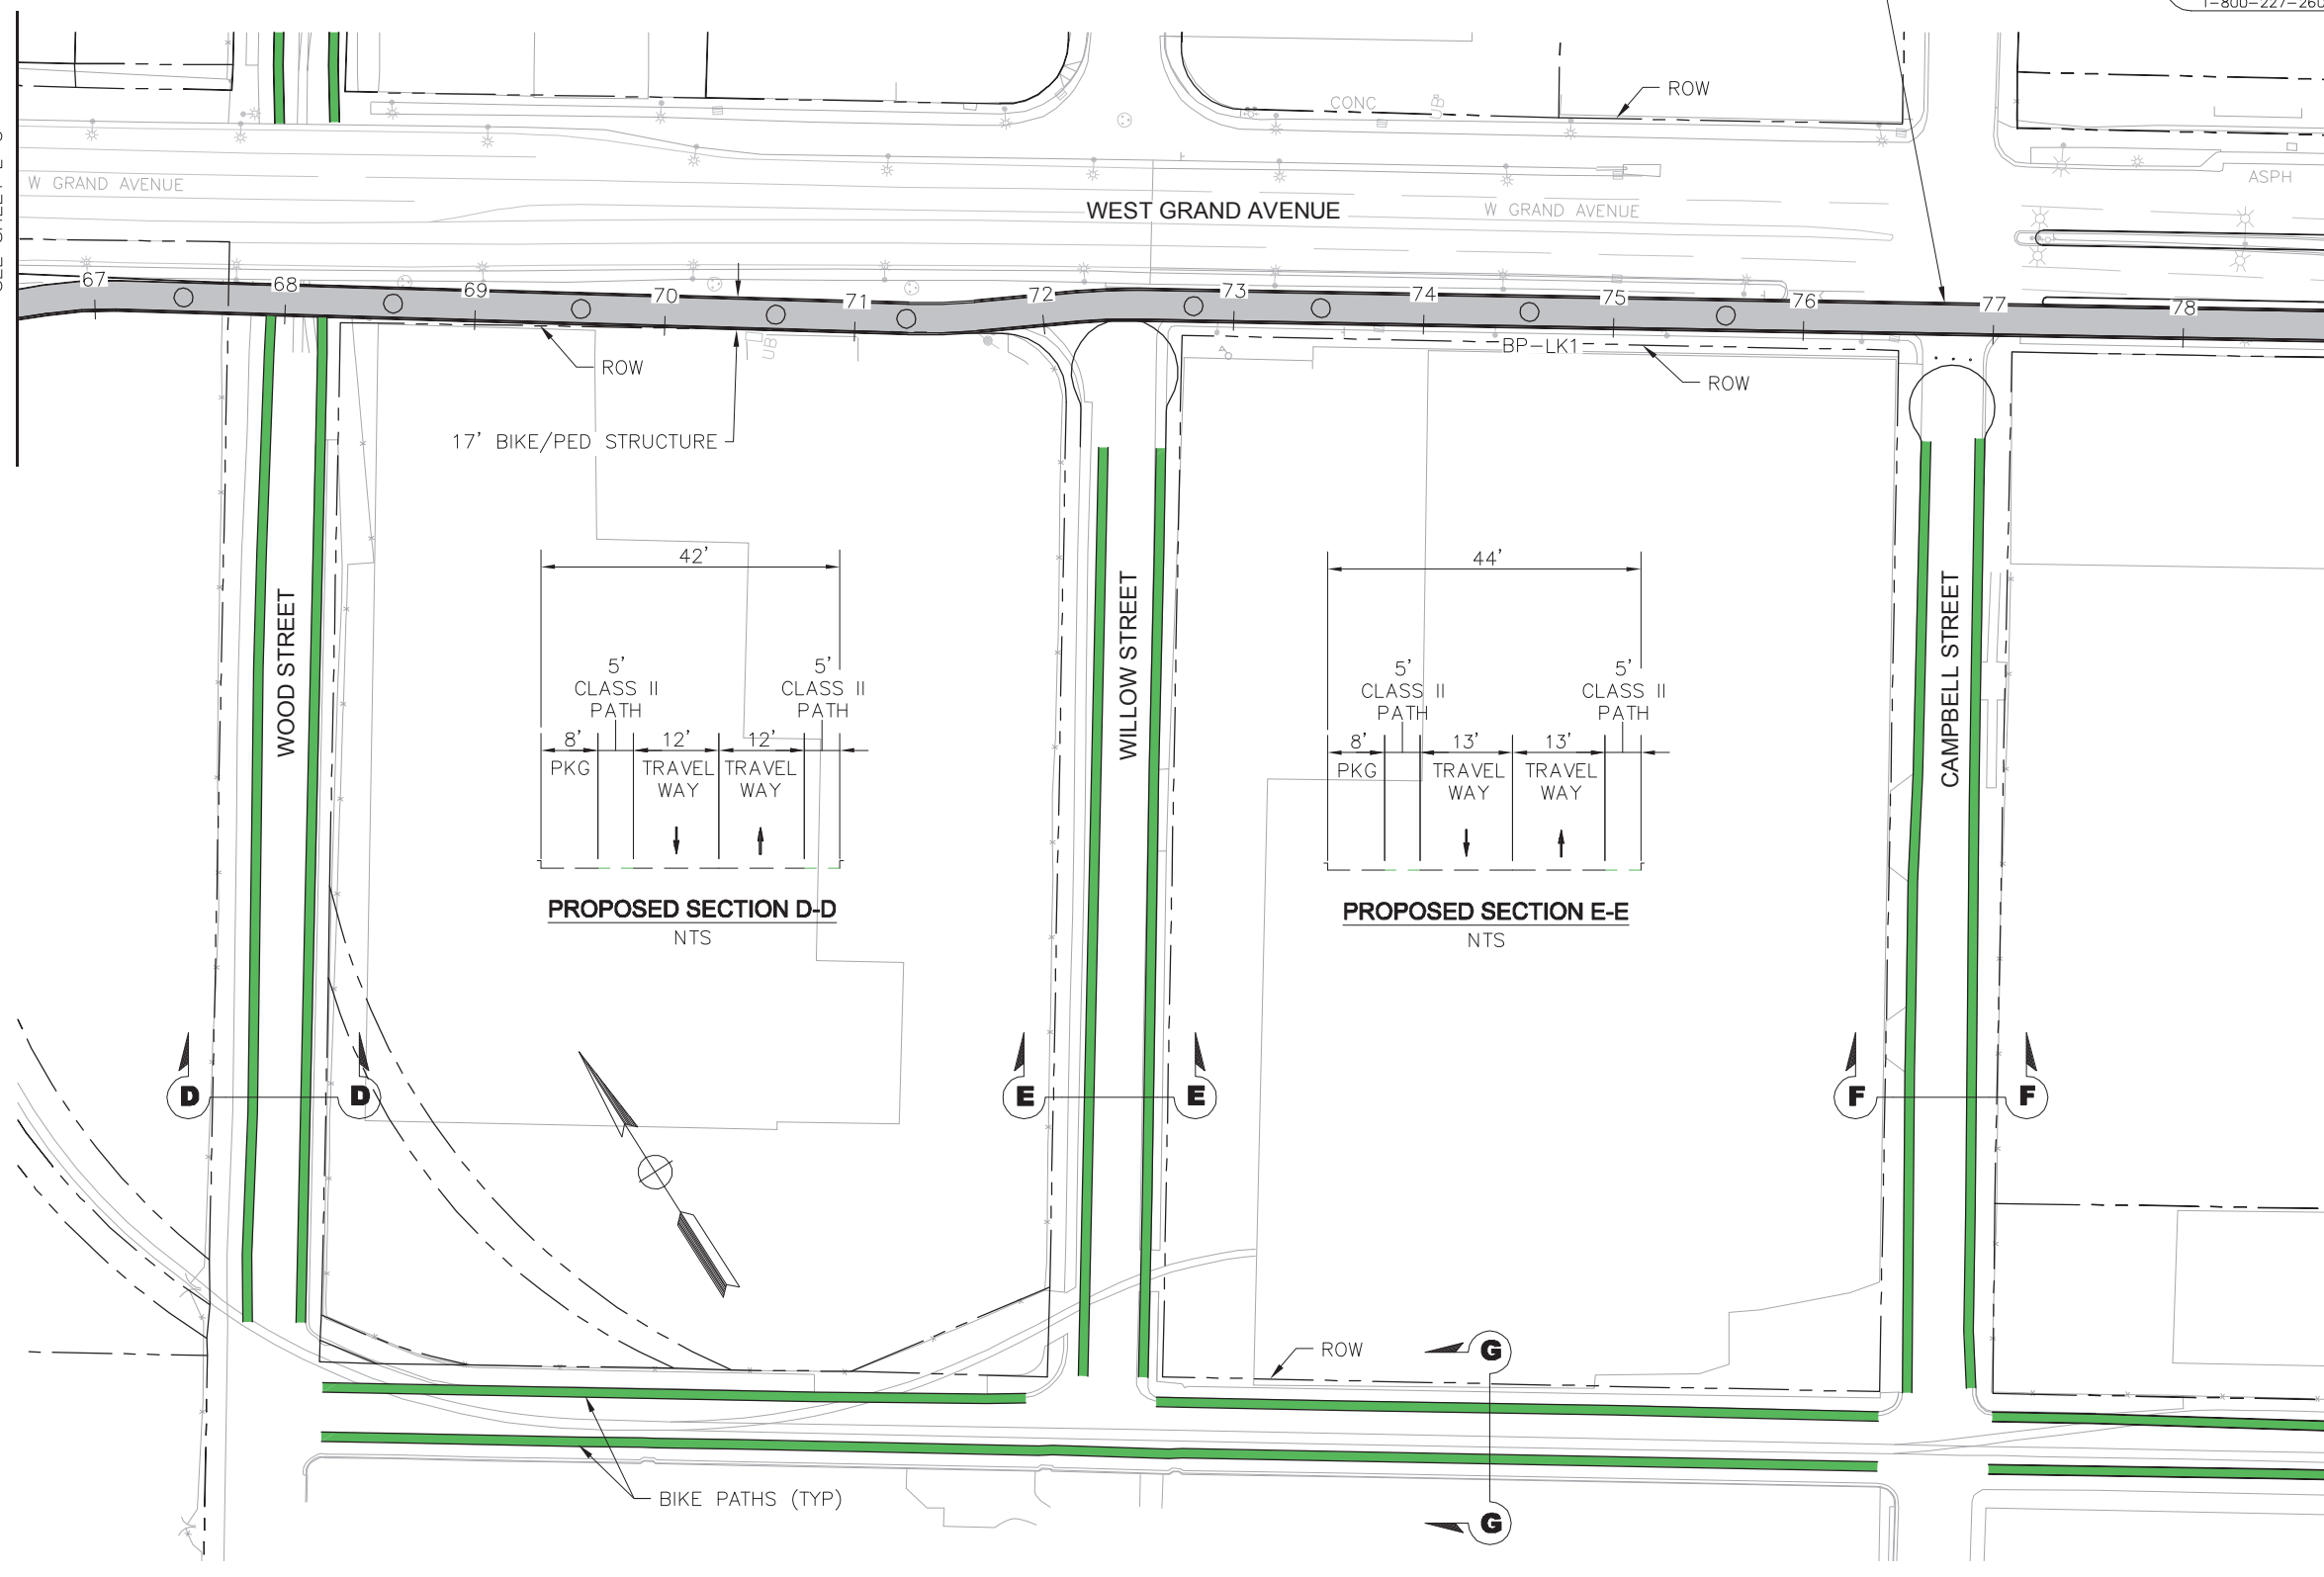

DIST	COUNTY	ROUTE	POST MILES TOTAL PROJECT	SHEET NO.	TOTAL SHEETS

REGISTERED CIVIL ENGINEER DATE _____

PLANS APPROVAL DATE _____




THE STATE OF CALIFORNIA OR ITS OFFICERS OR AGENTS SHALL NOT BE RESPONSIBLE FOR THE ACCURACY OR COMPLETENESS OF SCANNED COPIES OF THIS PLAN SHEET.




BAY AREA TOLL AUTHORITY
101 EIGHT STREET
OAKLAND, CALIFORNIA 94607

T.Y. LIN INTERNATIONAL
1111 BROADWAY, SUITE 2150
OAKLAND, CALIFORNIA 94607

- NOTES:**
- XXXXXXXXXXXXXXXX
 - XXXXXXXXXXXXXXXX

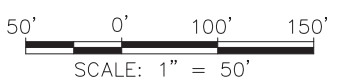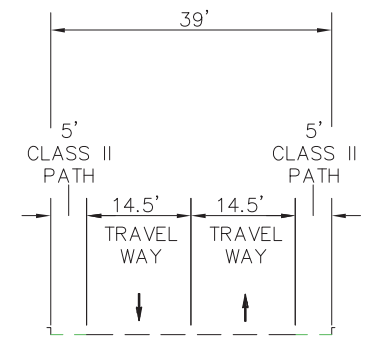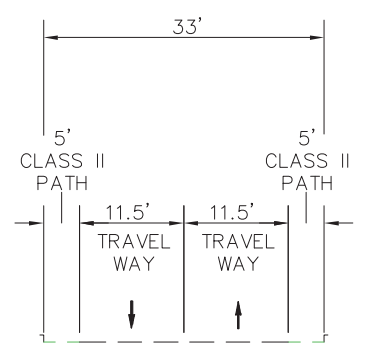


LAYOUT
Scale: 1"=50'

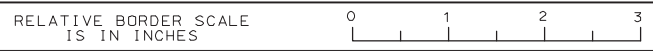

EA XX-XXXX

Drawing: P:\320142.00 Gateway Park\CADD\00 Shits\S-LINK-XXX-C-L008-50sc.dwg

STATE OF CALIFORNIA - DEPARTMENT OF TRANSPORTATION CONSULTANT FUNCTIONAL SUPERVISOR

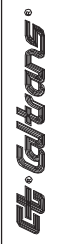

REVISOR BY
CALCULATED-DESIGNED BY
CHECKED BY




Dist	COUNTY	ROUTE	POST MILES TOTAL PROJECT	SHEET No.	TOTAL SHEETS

REGISTERED CIVIL ENGINEER DATE _____

PLANS APPROVAL DATE _____

THE STATE OF CALIFORNIA OR ITS OFFICERS OR AGENTS SHALL NOT BE RESPONSIBLE FOR THE ACCURACY OR COMPLETENESS OF SCANNED COPIES OF THIS PLAN SHEET.


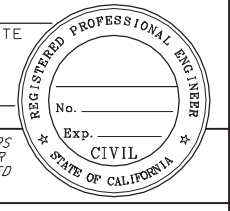


BAY AREA TOLL AUTHORITY
101 EIGHT STREET
OAKLAND, CALIFORNIA 94607

T.Y. LIN INTERNATIONAL
1111 BROADWAY, SUITE 2150
OAKLAND, CALIFORNIA 94607

NOTES:


- XXXXXXXXXXXXXXXXXX
- XXXXXXXXXXXXXXXXXX

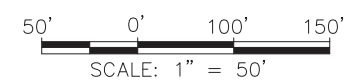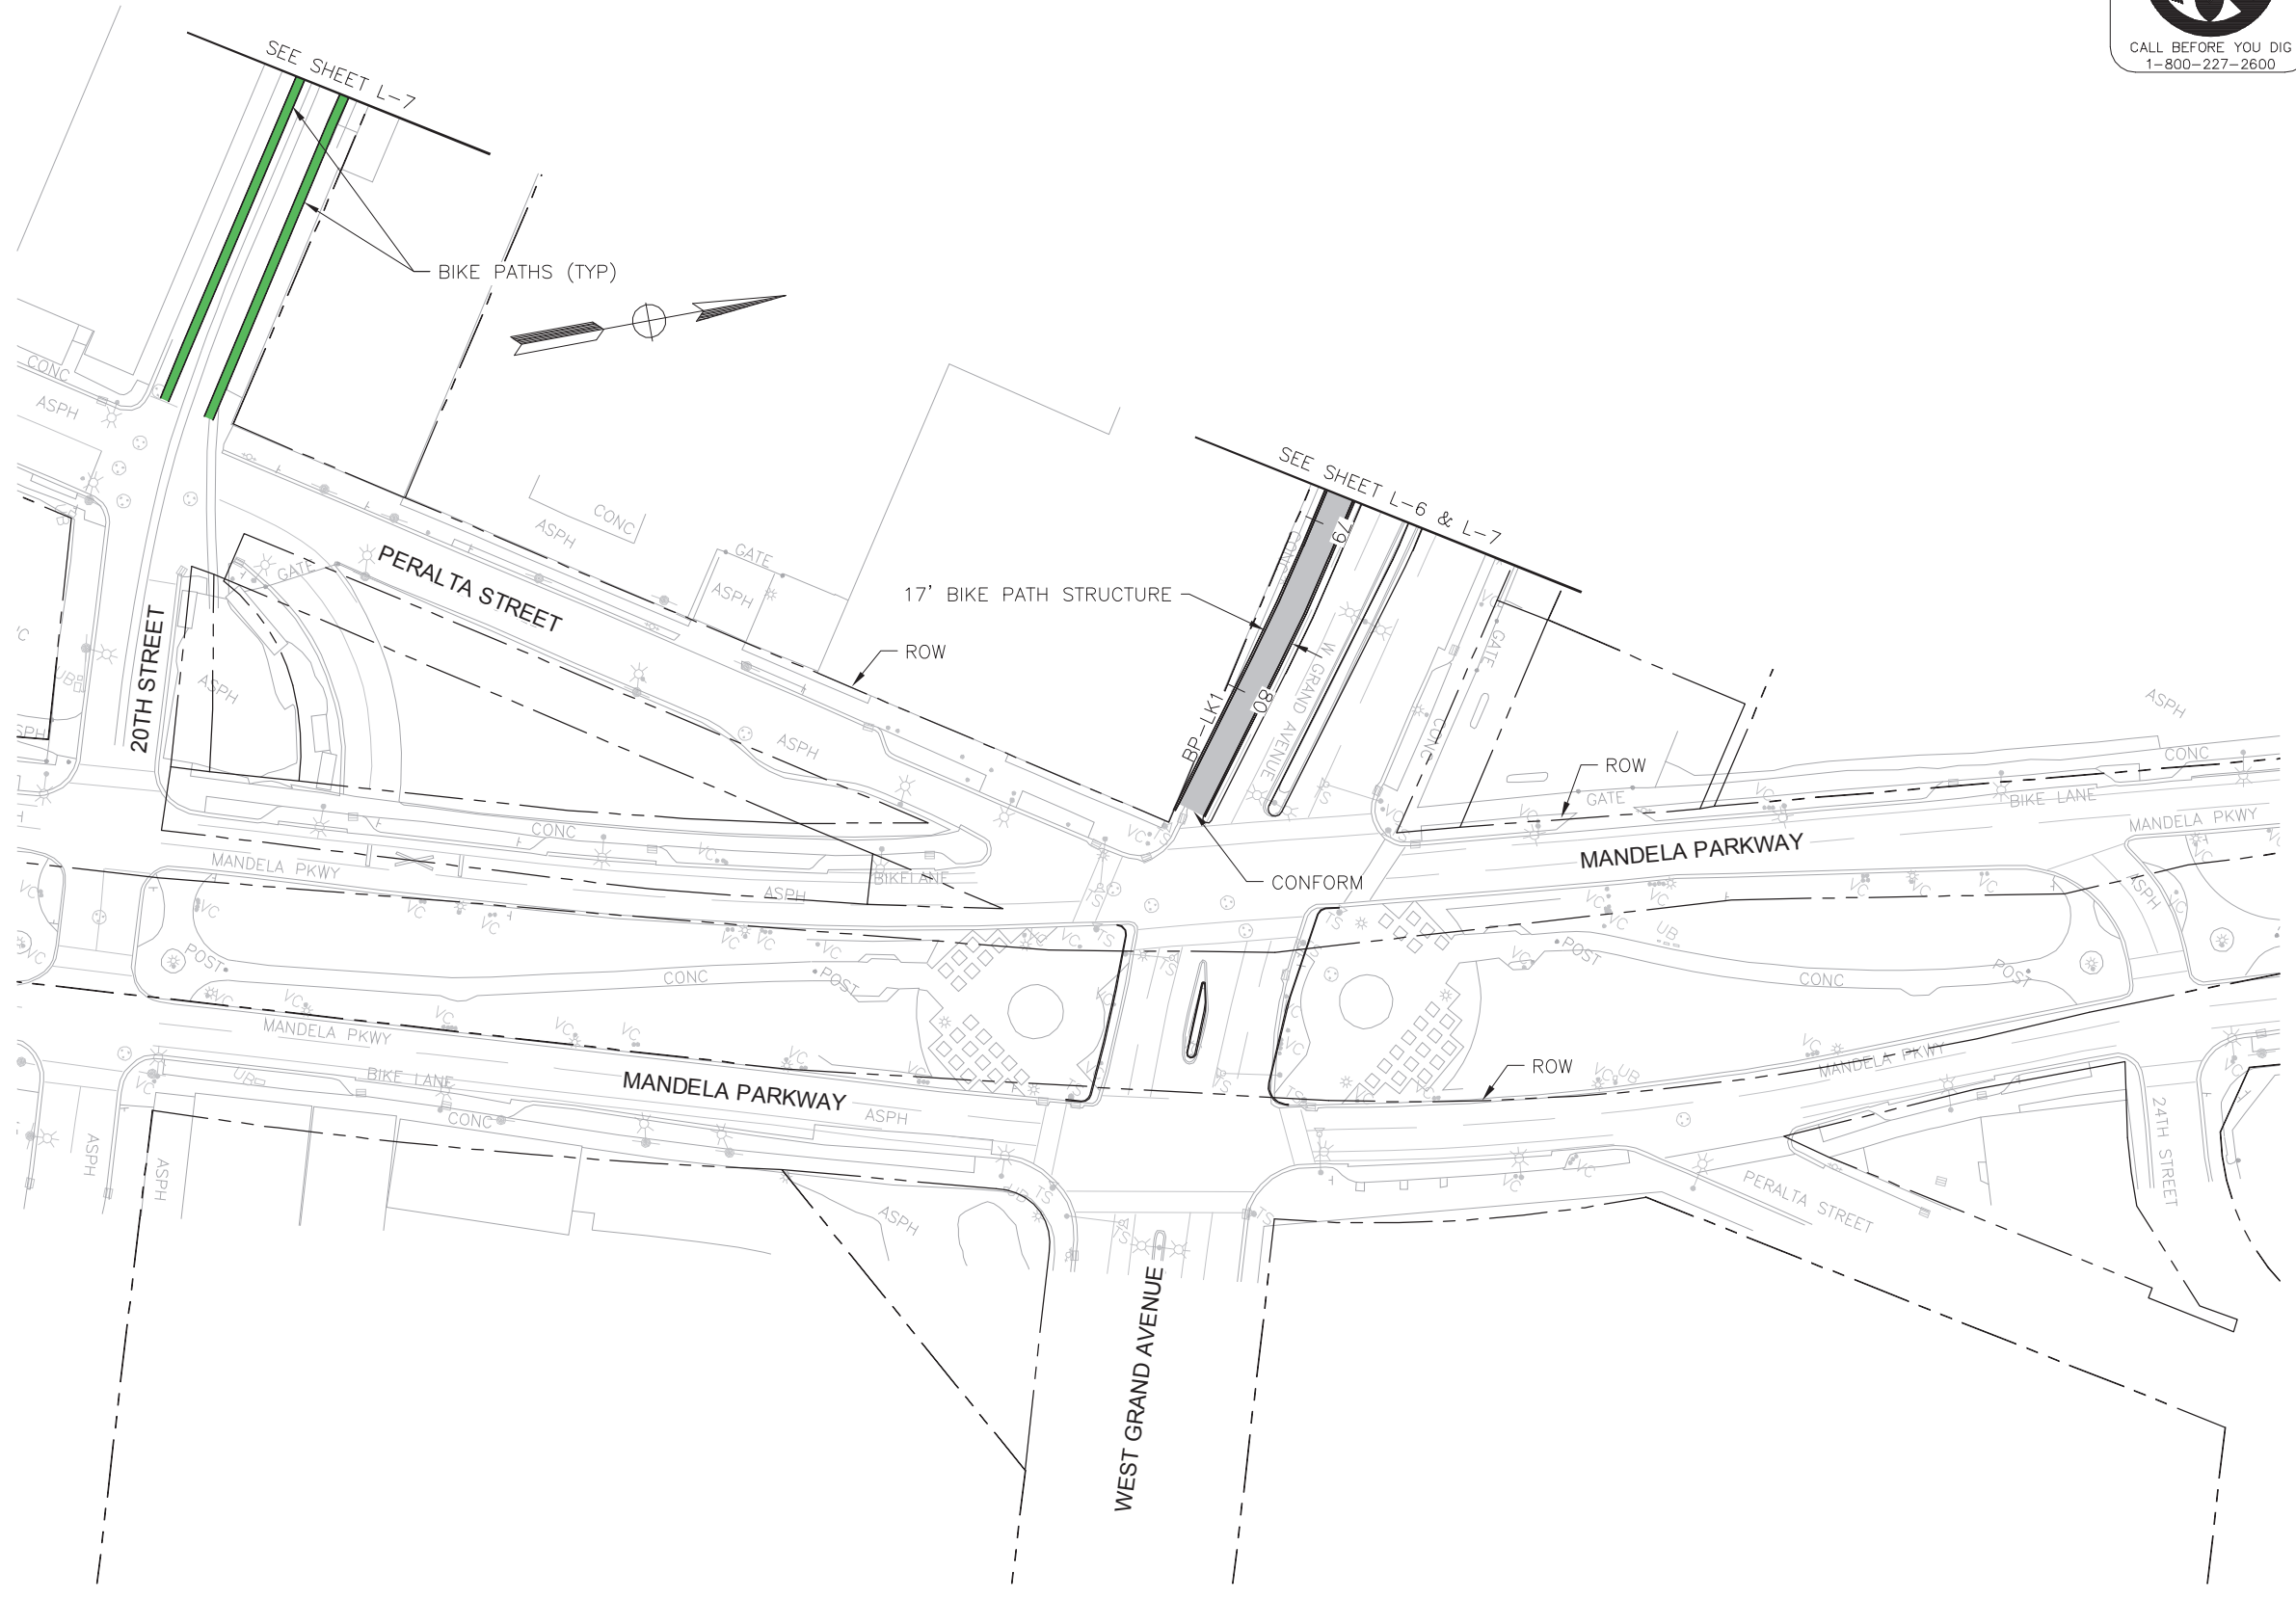

LAYOUT
Scale: 1"=50'

PRELIMINARY PLAN

L-8

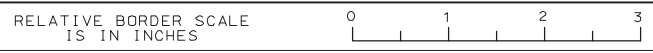


EA XX-XXXXX

LAST REVISION
06-05-14

APPENDIX B
BORING LOGS FROM PREVIOUS INVESTIGATIONS

DIST.	COUNTY	ROUTE	POST MILES TOTAL PROJECT	SHEET NO.	TOTAL SHEETS
04	Ala	880	34.3/35.0	888	940

R.C. Wilhelms
R.C. WILHELMS
 No. 560
 Exp. 6-30-94
 CERTIFIED ENGINEERING GEOLOGIST
 STATE OF CALIFORNIA

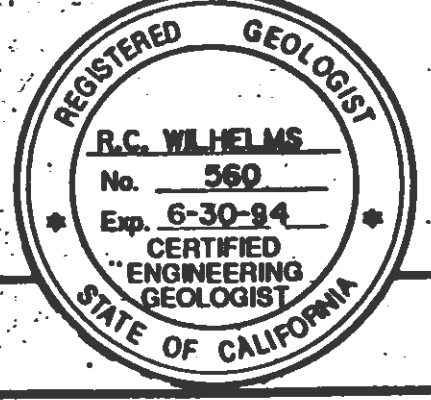

3-13-95
 PLANS APPROVAL DATE

The State of California or its officers or agents shall not be responsible for the accuracy or completeness of electronic copies of this plan sheet.

BENCH MARK

BM-AB-1036 EL.=5.92'
 P.K. NAIL W/C.T. SHINER AT NORTHERLY END OF A.C. PATH LEADING AWAY (NORTHERLY) S.P.R.R. DEPOT (16TH & WOOD ST.) APPROX. OPPOSITE FROM 20TH STREET.


BM-AB-441 EL.=5.33'
 P.K. NAIL AND SHINER 0.04 BELOW A.C. PAVEMENT NEAR $\frac{1}{2}$ INTERSECTION OF WOOD AND 20TH STREET.

BM-AB-420 EL.=39.64'
 P.K. NAIL W/ SHINER AT NORTHEASTERLY SIDE OF ABANDONED WOOD BRIDGE OVER S.P.R.R. TRACKS. 1200' NORTHERLY OF WEST GRAND AVE. AT END OF WAKE AVE.

AS BUILT



CORRECTIONS BY S. WHIPPLE
 CONTRACT NO. 04-192244
 DATE 01-28-98
 NO AS-BUILT CHANGES .M.F. 4-16-78

CONTRACT "E"

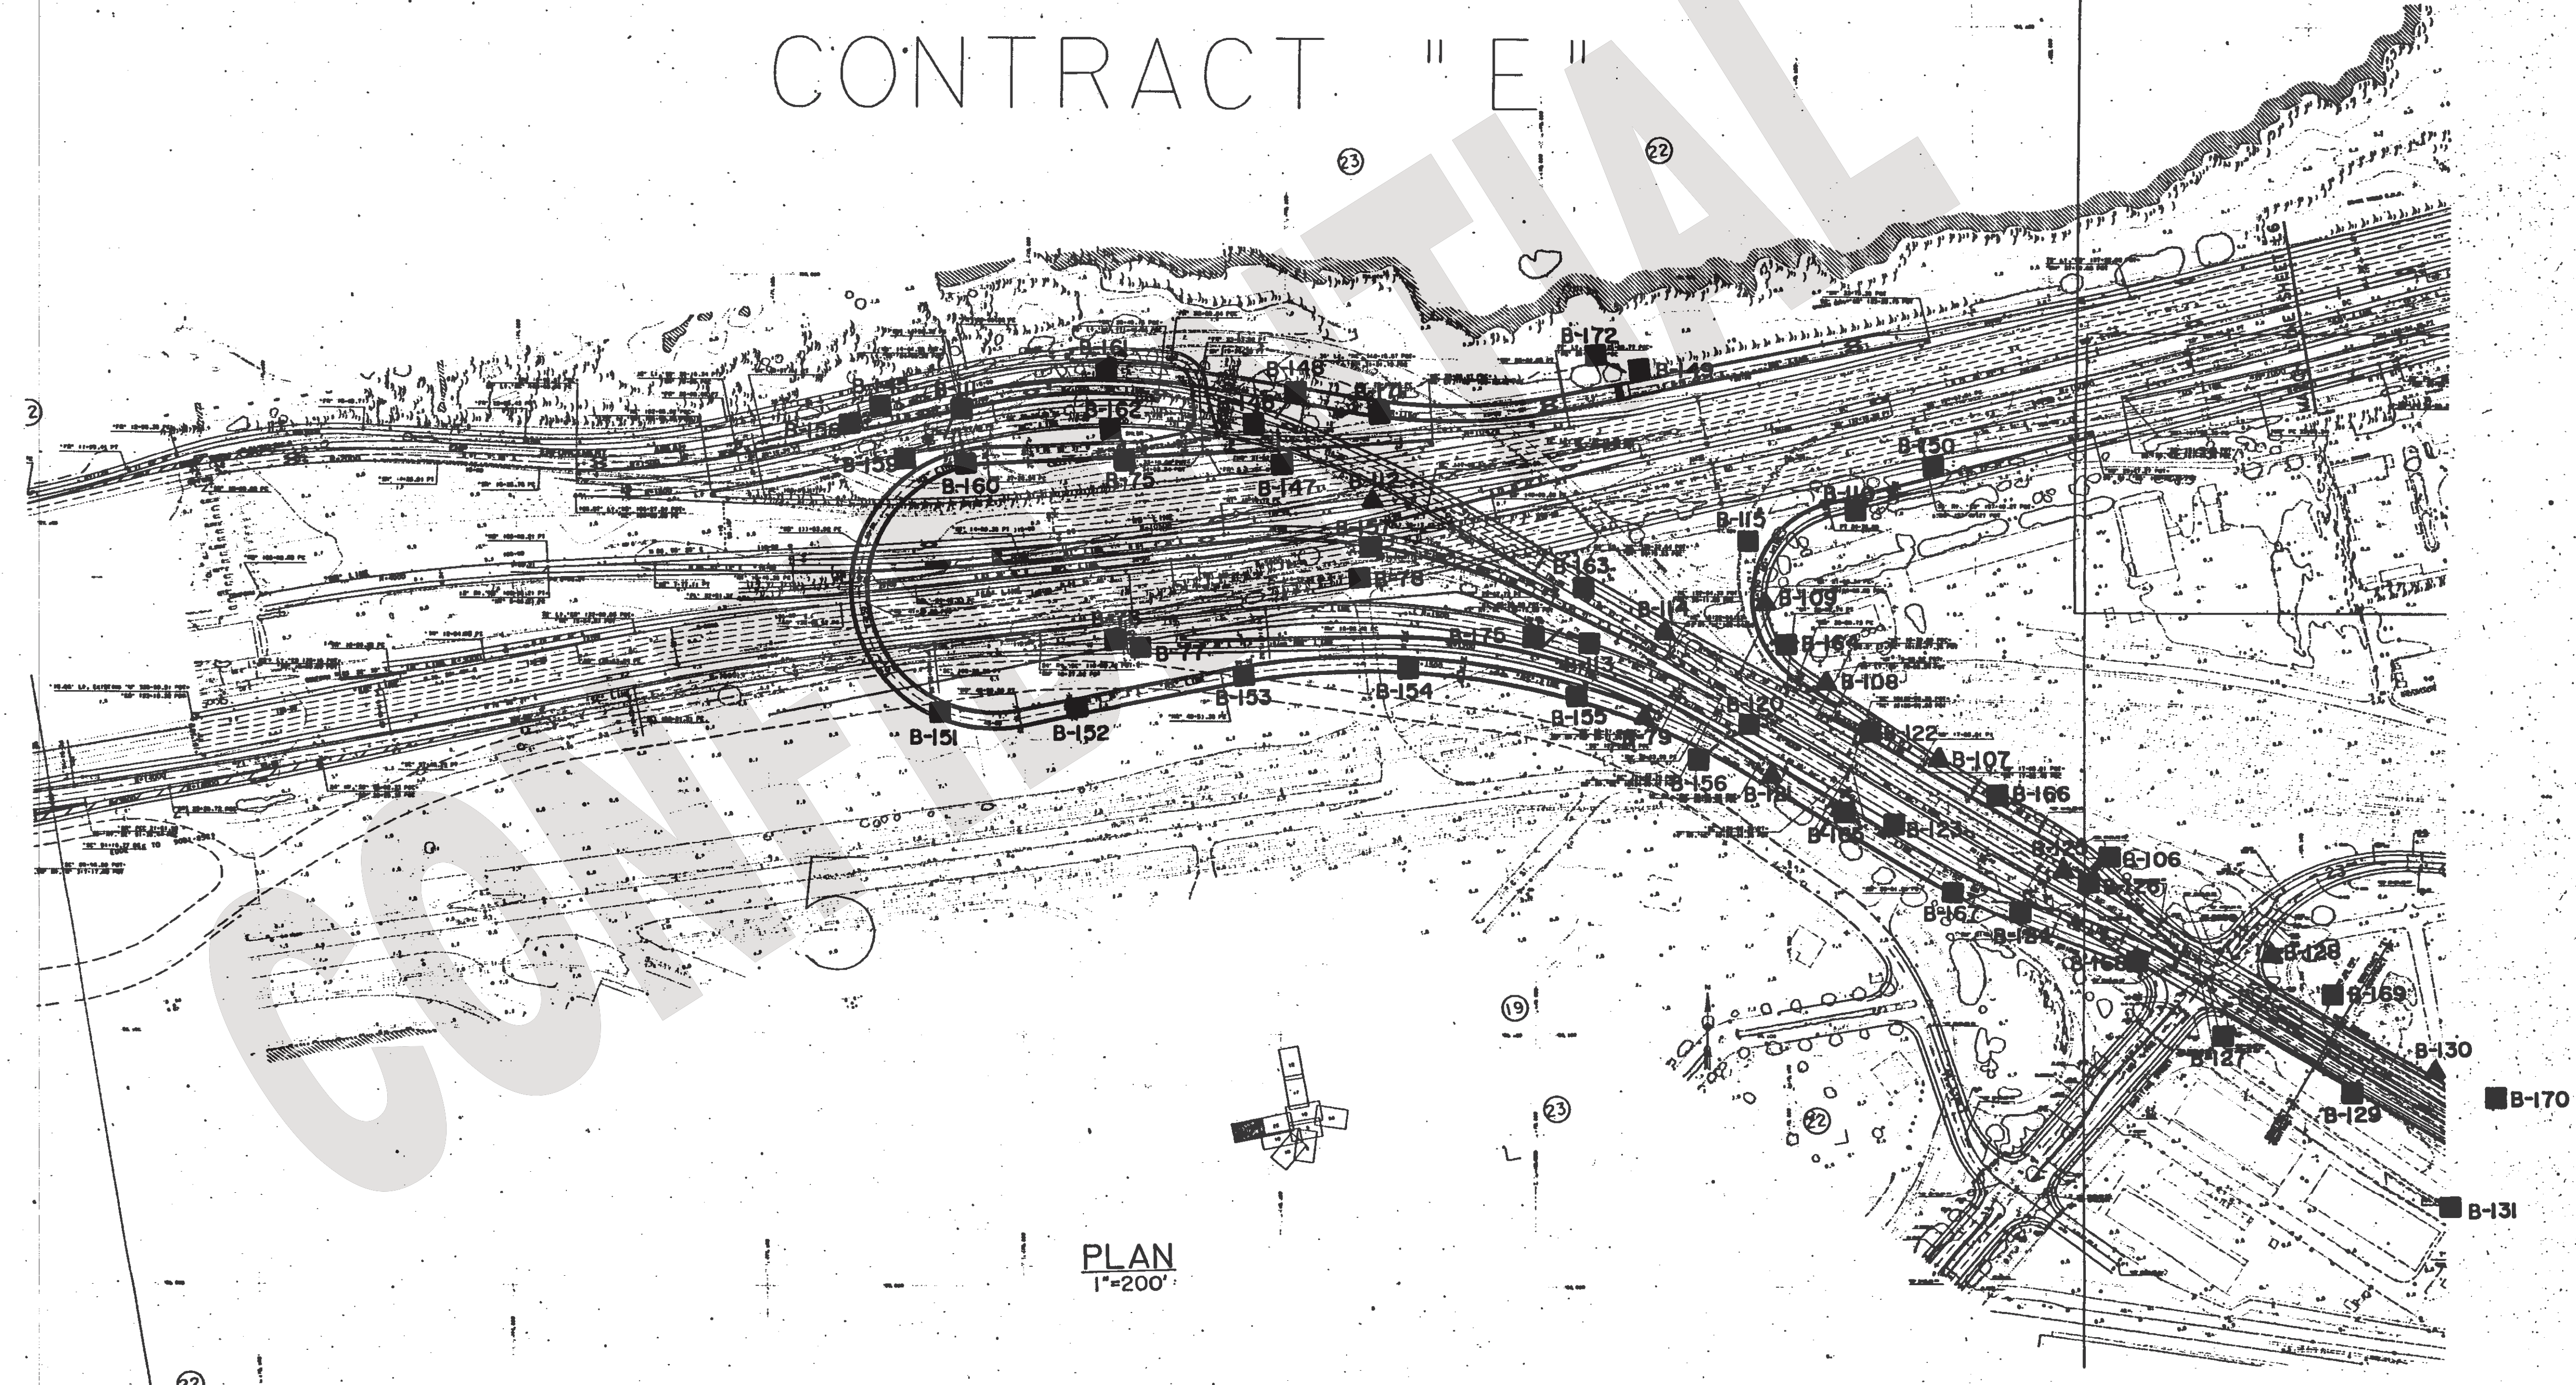

PLAN
 1"=200'

LEGEND OF BORING OPERATIONS

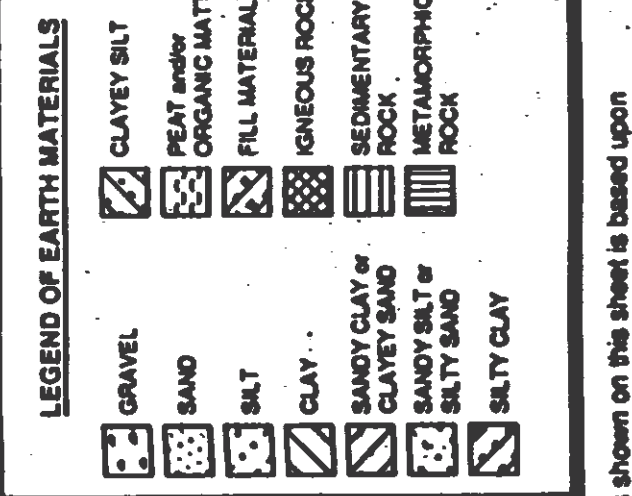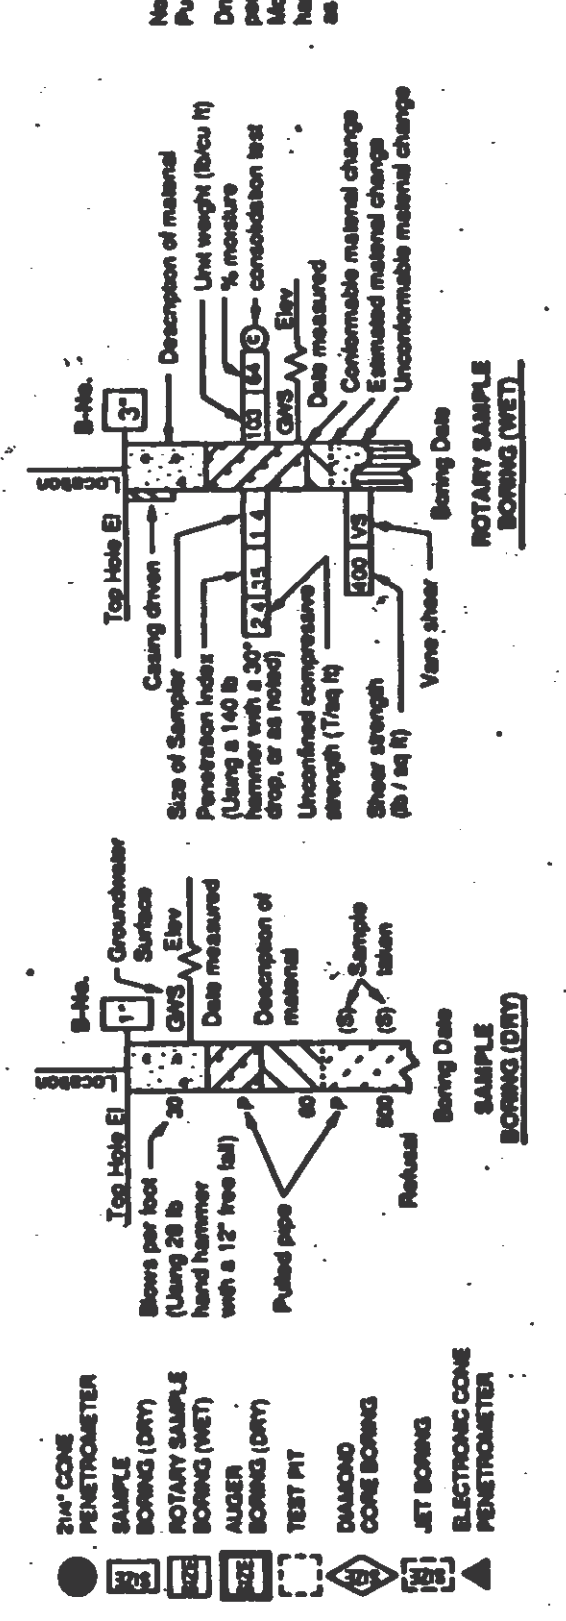

CONSISTENCY CLASSIFICATION FOR SOILS	
According to the Standard Penetration Test	
Cohesive	Very soft
	Soft
	Very stiff
Granular	Very loose
	Loose
	Slightly compact
Penetration (Blows / Ft)	0-4
	5-9
Cohesive	10-19
	20-29
	30-39
Granular	40-49
	50-59
	60-69

NOTE: Classification of earth material as shown on this sheet is based upon field inspection and is not to be construed to imply mechanical analysis.

OFFICE OF TRANSPORTATION MATERIALS & RESEARCH		ENGINEERING GEOLOGY BRANCH		FIELD INVESTIGATION BY:	State of CALIFORNIA DEPARTMENT OF TRANSPORTATION	DIVISION OF STRUCTURES STRUCTURE DESIGN	BRIDGE NO. 33-612 E	PORT OF OAKLAND CONN. VIADUCT	
DRAWN BY	K. WAHL	5-92		M. WILLIAM			POST MILE	LOG OF TEST BORINGS 1 OF 20	
CHECKED BY								REVISION DATES (PRELIMINARY STAGE ONLY)	
					ORIGINAL SCALE IN INCHES FOR REDUCED PLANS	0 1 2 3	CU 04 EA 192231	DISREGARD PRINTS BEARING EARLIER REVISION DATES	SHEET 68 OF 101

DIST	COUNTY	ROUTE	POST MILES TOTAL PROJECT	SHEET NO	TOTAL SHEETS
04	Ala	880.80	34.4 1.3/3.0	557	1412


R.C. Wilhelm
 CERTIFIED ENGINEERING GEOLOGIST
 No. 360
 Exp. 6-30-94
 REGISTERED GEOLOGIST
 R.C. WILHELMS
 No. 360
 Exp. 6-30-94
 CERTIFIED ENGINEERING GEOLOGIST
 STATE OF CALIFORNIA
 6-13-94
 PLANS APPROVAL DATE

BENCH MARK

BM'AB-036 EL.=5.92
 P.K. NAIL W/C.T. SHINER AT NORTHERLY END OF A.C. PATH LEADING AWAY (NORTHERLY) S.P.R.R. DEPOT (16TH & WOOD ST.) APPROX. OPPOSITE FROM 20TH STREET.

BM'AB-441 EL.=5.33'
 P.K. NAIL AND SHINER O.D.4 BELDW A.C. PAVEMENT NEAR 1/2 INTERSECTION OF WOOD AND 20TH STREET.

BM'AB-420 EL.=39.64
 P.K. NAIL W/ SHINER AT NORTHEASTERLY SIDE OF ABANDONED WOOD BRIDGE OVER S.P.R.R. TRACKS. 1200' NORTHERLY OF WEST GRAND AVE AT END OF WAKE AVE.

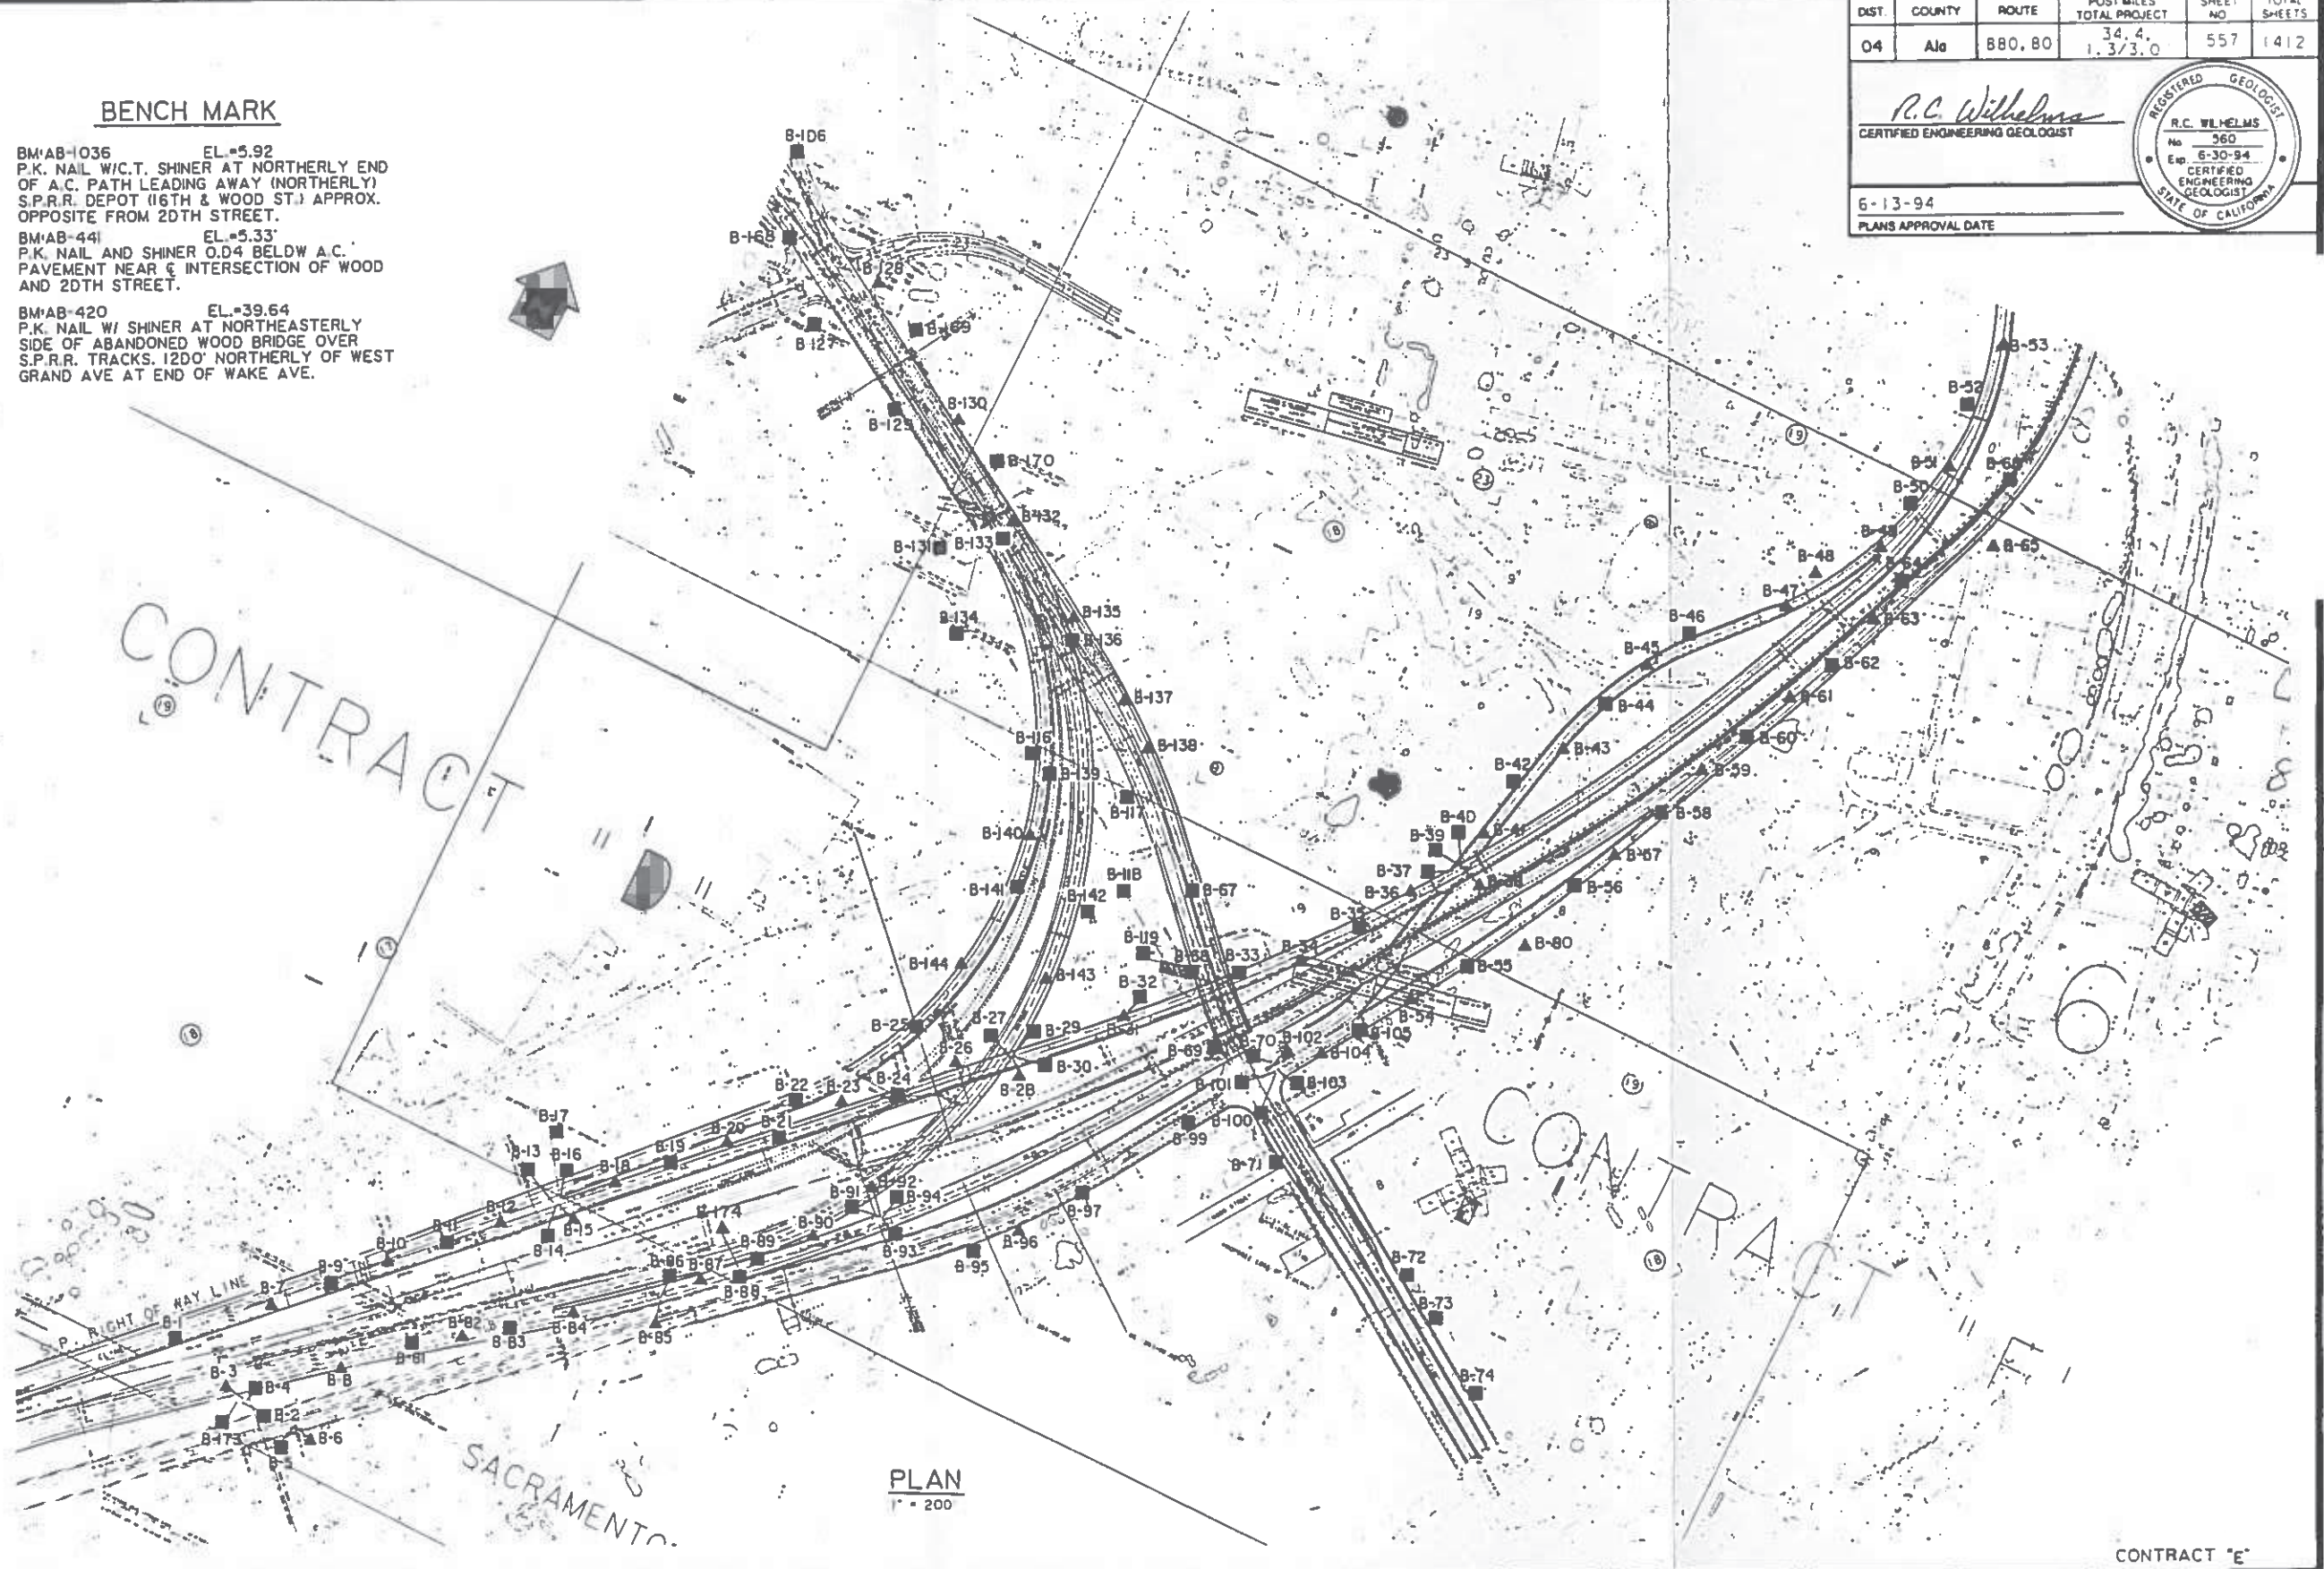

TEST METHODS

PERMEABILITY TESTS
 1. Constant Head Permeability Test
 2. Falling Head Permeability Test
 3. Diaphragm Permeability Test
 4. Hydraulic Head Permeability Test
 5. Gas Permeability Test

SOIL CLASSIFICATION
 1. Plasticity Chart
 2. Unified Soil Classification System
 3. AASHTO Soil Classification System

FOUNDATION TESTS
 1. Standard Penetration Test (SPT)
 2. Cone Penetration Test (CPT)
 3. Vane Shear Test
 4. Triaxial Compression Test
 5. Direct Shear Test
 6. Unconfined Compression Test
 7. Consolidation Test
 8. Swell Test
 9. Free Swell Test
 10. Shrinkage Test
 11. Liquid Limit Test
 12. Plastic Limit Test
 13. Shrinkage Limit Test
 14. Compaction Test
 15. Proctor Test
 16. Modified Proctor Test
 17. Free Compaction Test
 18. Density Test
 19. Moisture Content Test
 20. Specific Gravity Test
 21. Sand Equivalent Test
 22. Sand Fraction Test
 23. Clay Fraction Test
 24. Organic Matter Test
 25. Organic Content Test
 26. Organic Liquid Limit Test
 27. Organic Plastic Limit Test
 28. Organic Shrinkage Limit Test
 29. Organic Liquid Limit Index Test
 30. Organic Plasticity Index Test
 31. Organic Shrinkage Index Test
 32. Organic Liquid Limit - Plasticity Chart
 33. Organic Liquid Limit - Shrinkage Chart
 34. Organic Plastic Limit - Shrinkage Chart
 35. Organic Liquid Limit - Plasticity Index Chart
 36. Organic Liquid Limit - Plasticity Index - Shrinkage Chart
 37. Organic Liquid Limit - Plasticity Index - Shrinkage Index Chart
 38. Organic Liquid Limit - Plasticity Index - Shrinkage Index - Shrinkage Chart
 39. Organic Liquid Limit - Plasticity Index - Shrinkage Index - Shrinkage Index Chart
 40. Organic Liquid Limit - Plasticity Index - Shrinkage Index - Shrinkage Index - Shrinkage Chart

OFFICE OF TRANSPORTATION MATERIALS & RESEARCH		ENGINEERING GEOLOGY BRANCH	FIELD INVESTIGATION BY M. WILLIAMS	State of CALIFORNIA DEPARTMENT OF TRANSPORTATION	DIVISION OF STRUCTURES STRUCTURE DESIGN	BRIDGE NO. 33-612 E POST MILE	PORT OF OAKLAND CONN. VIADUCT LOG OF TEST BORINGS 2 OF 20
DRAWN BY IRMA GAMARRA	5/92						
CHECKED BY							

ORIGINAL SCALE IN INCHES FOR REDUCED PLANS
 0 1 2 3
 CU 04
 EA 192231

DISREGARD PRINTS BEARING EARLIER REVISION DATES
 SHEET NO. 116 OF 148



240-B-11
B-78

DIST	COUNTY	ROUTE	POST MILES TOTAL PROJECT	SHEET NO
04	Alc	880.80	3.4, 4, 1.3/3.0	558

R.C. Wilhelm
CERTIFIED ENGINEERING GEOLOGIST

6-13-94
PLANS APPROVAL DATE

REGISTERED
R.C. WILHELM
No. 300
Exp. 6-30-94
CERTIFIED ENGINEERING GEOLOGIST
STATE OF CALIF.

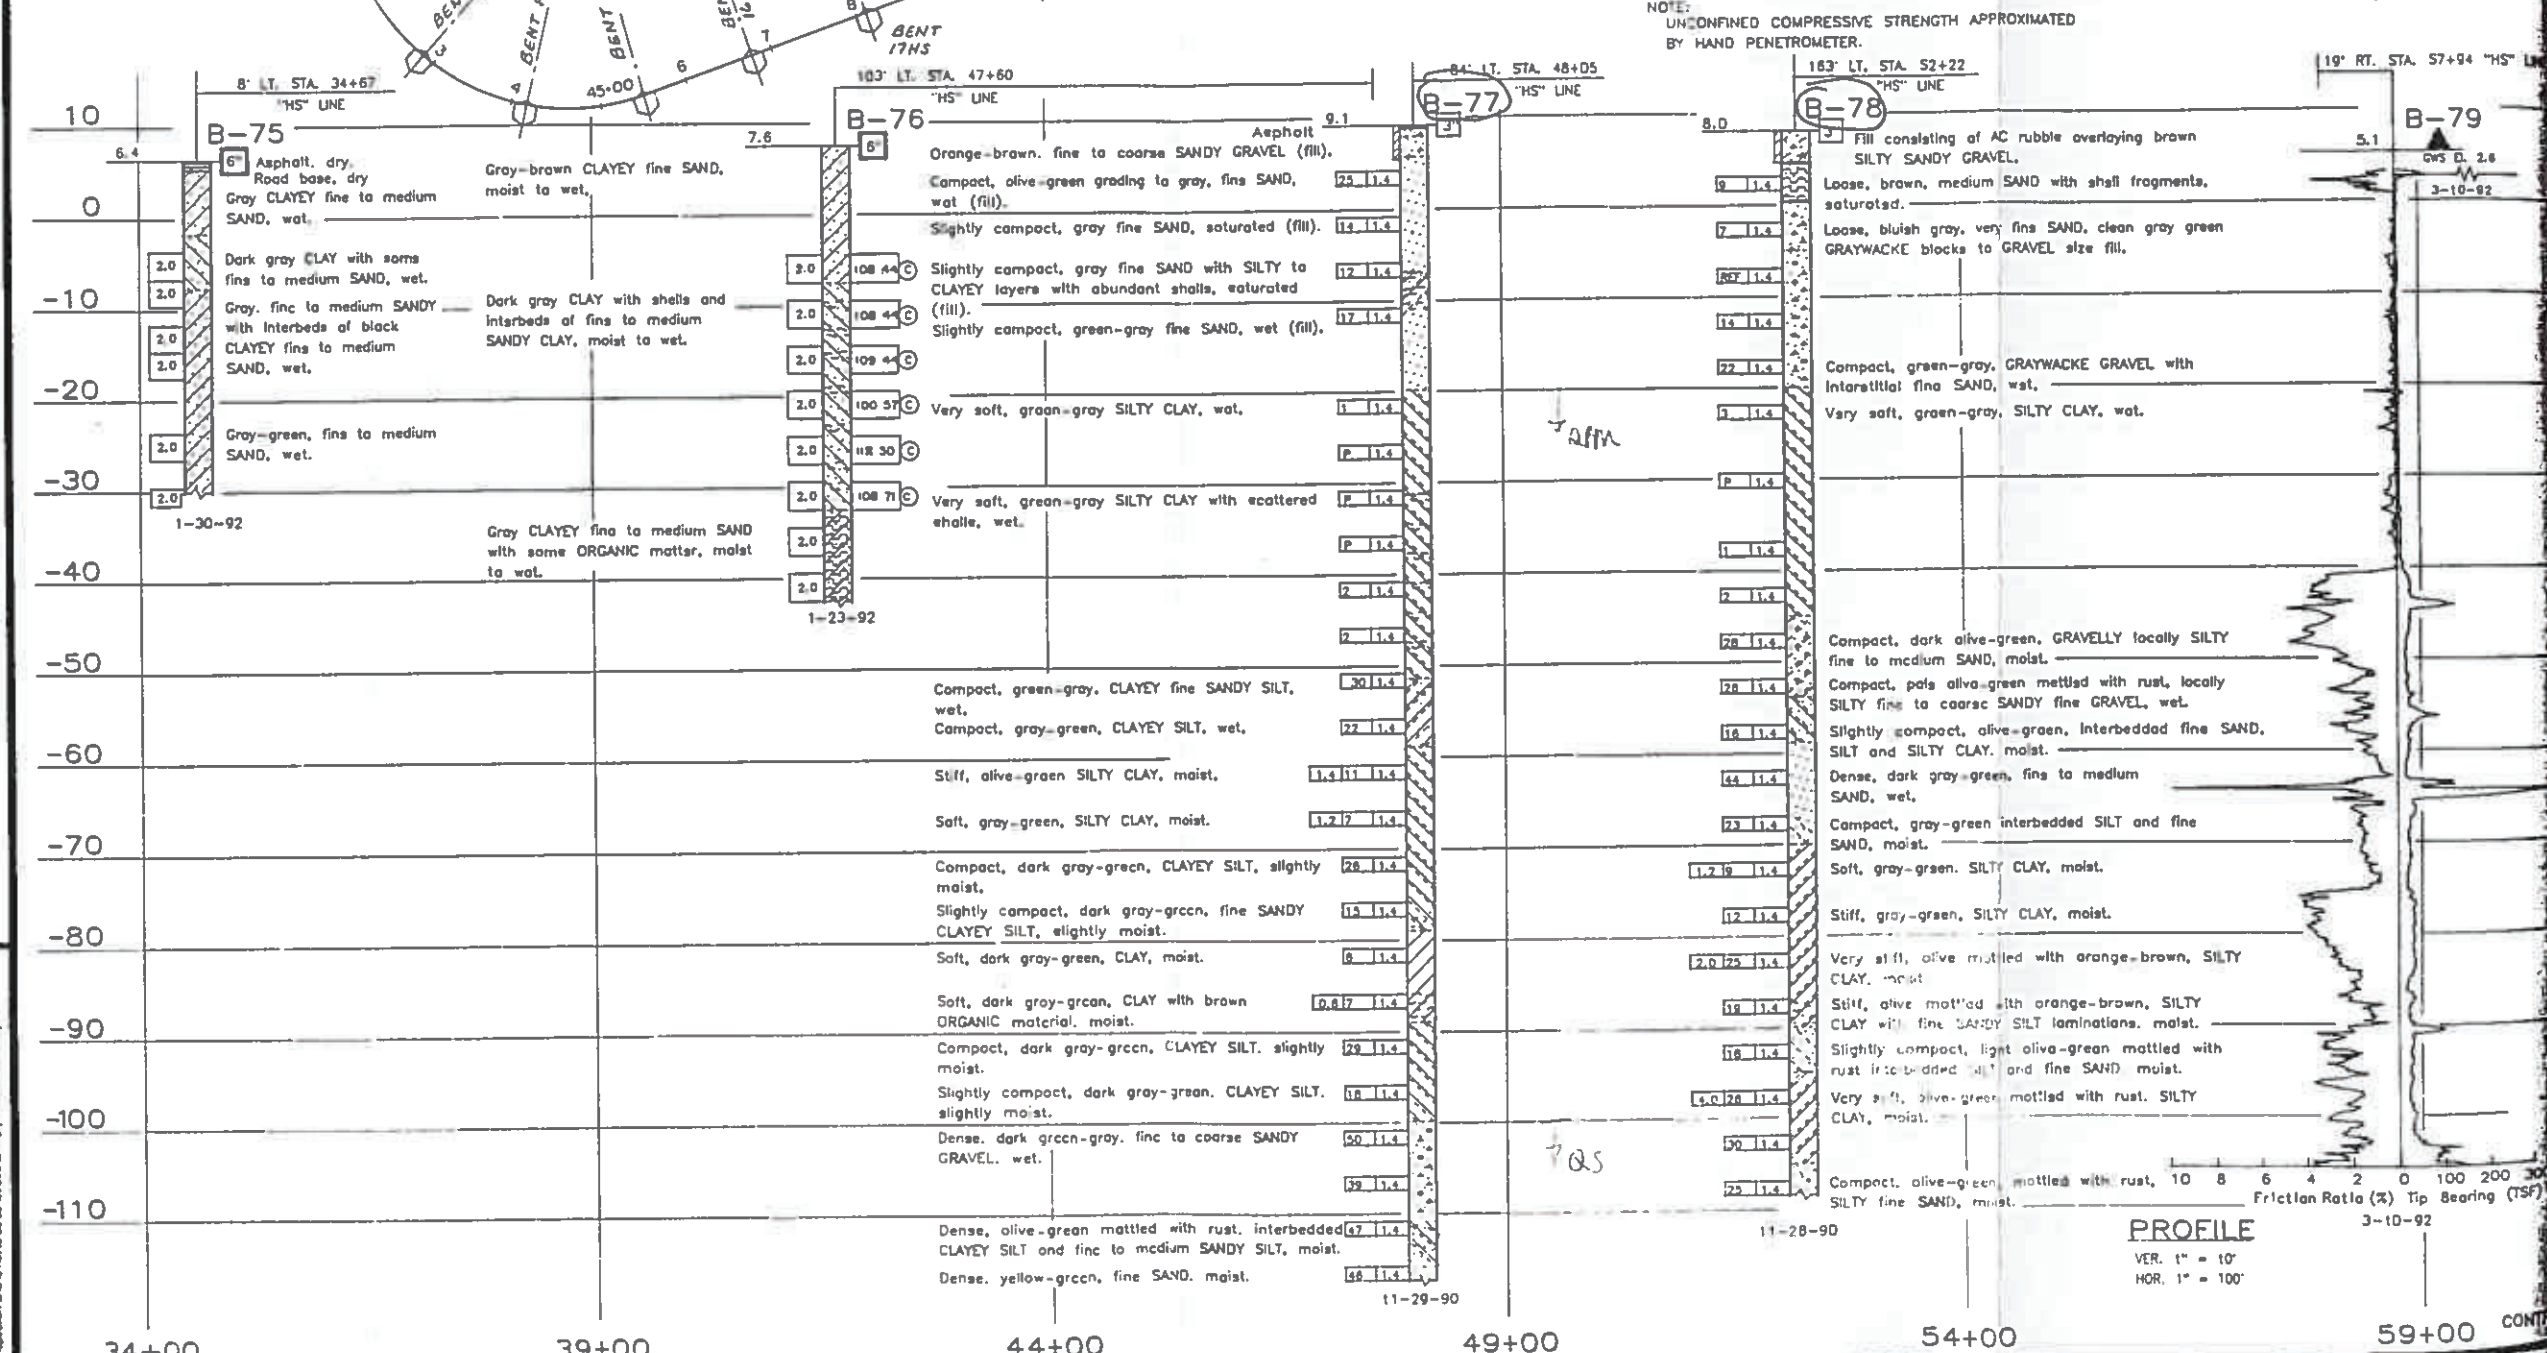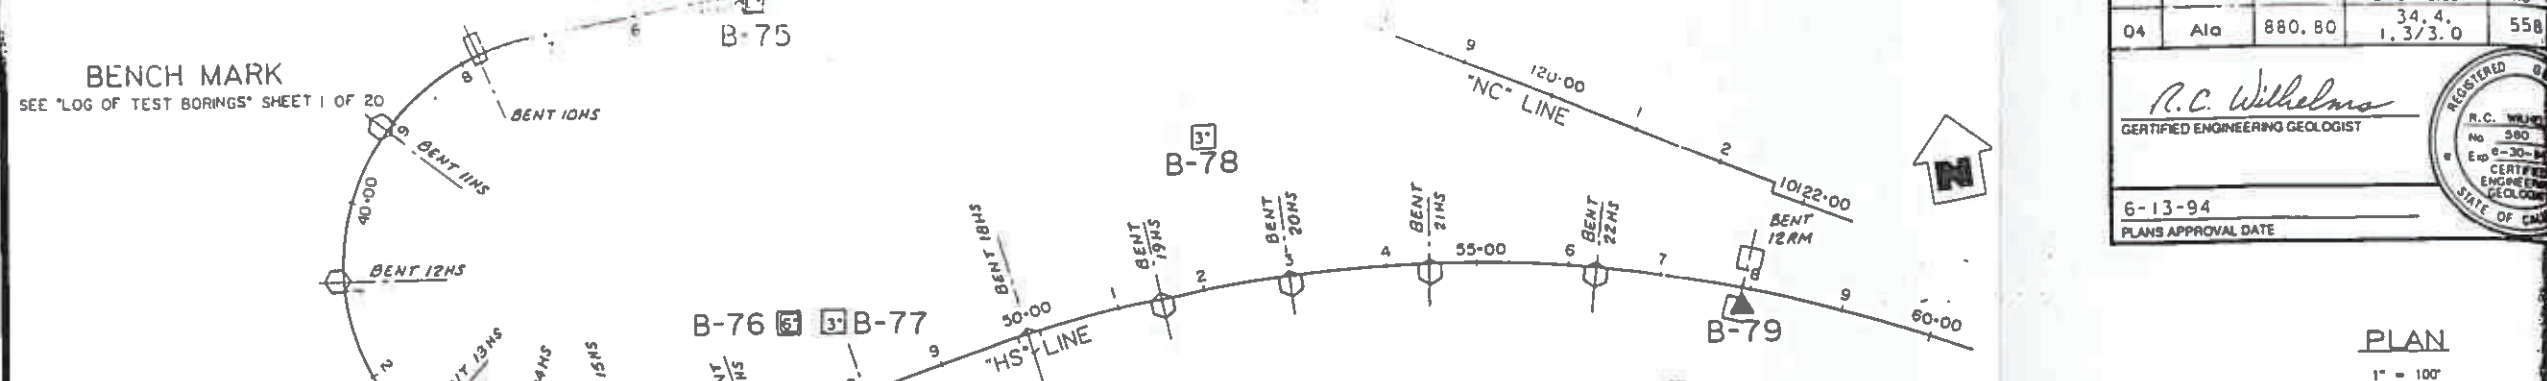

LEGEND OF BORING OPERATIONS

LEGEND OF EARTH MATERIALS

CONSISTENCY CLASSIFICATION FOR SOILS

NOTE: Classification of earth material as shown on this sheet is based upon field inspection and is not to be construed to imply mechanical analysis.

OFFICE OF TRANSPORTATION MATERIALS & RESEARCH ENGINEERING GEOLOGY BRANCH

FIELD INVESTIGATION BY: M. WILLIAMS

State of CALIFORNIA DEPARTMENT OF TRANSPORTATION

DIVISION OF STRUCTURES STRUCTURE DESIGN

BRIDGE NO. 33-612 E POST MILE 3.0

PORT OF OAKLAND CONN. VIADUCT LOG OF TEST BORINGS 3

DISREGARD PRINTS BEARING EARLIER REVISION DATES


REVISION DATES (PRELIMINARY STAGE ONE)

DIST.	COUNTY	ROUTE	POST MILES TOTAL PROJECT	SHEET NO.	TOTAL SHEETS
04	Ala	880	34.3/35.0	891	940

R.C. Wilhelms
 CERTIFIED ENGINEERING GEOLOGIST
 No. 580
 Exp. 6-30-94
 REGISTERED GEOLOGIST
 STATE OF CALIFORNIA

3-13-95
 PLANS APPROVAL DATE

The State of California or its officers or agents shall not be responsible for the accuracy or completeness of electronic copies of this plan sheet.

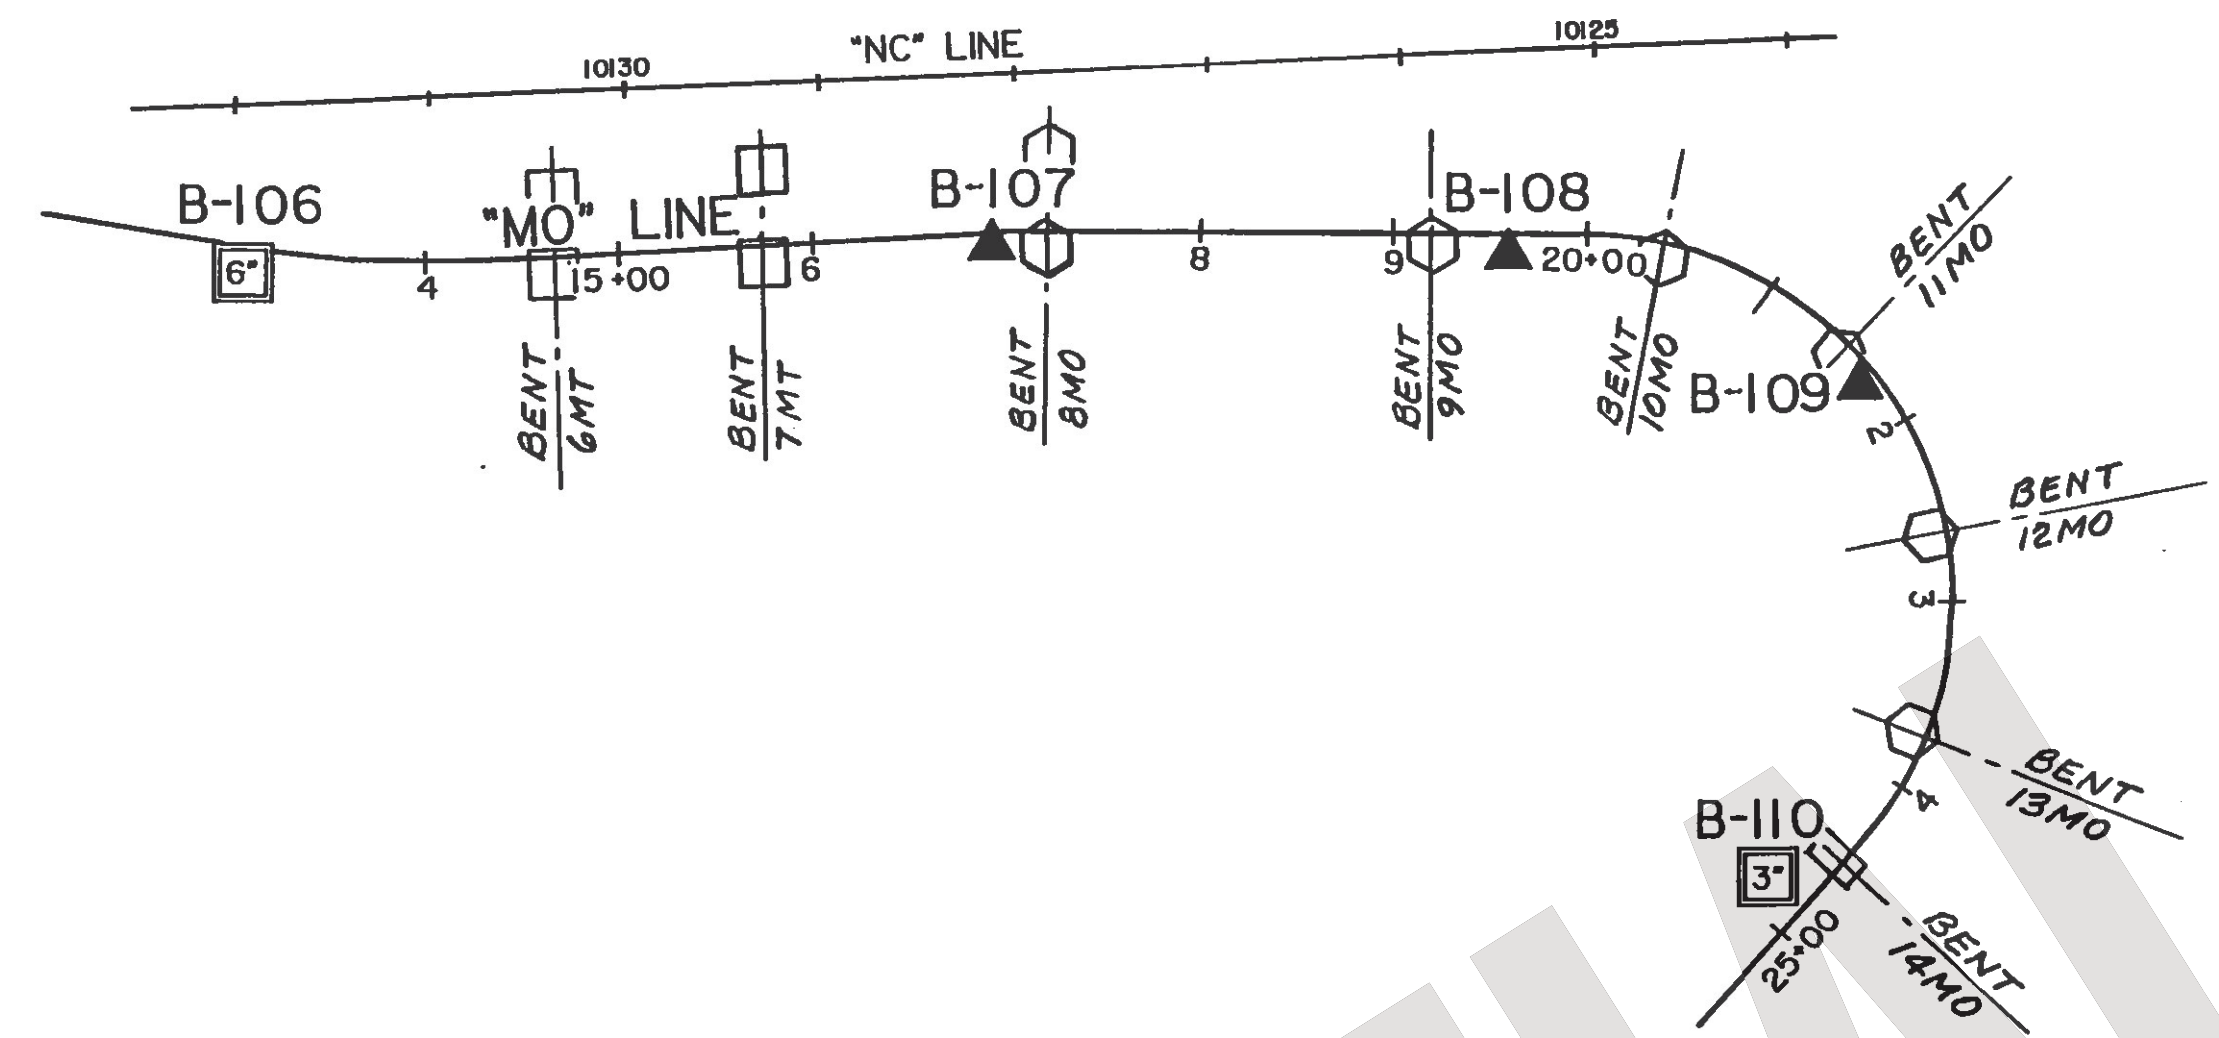


BENCH MARK
 SEE "LOG OF TEST BORINGS 1 OF 20"

PLAN
 1" = 100'

AS BUILT

CORRECTIONS BY S. WHIPPLE
 CONTRACT NO. 04-192244
 DATE 01-28-98
 NO AS-BUILT CHANGES M.F. 4-6-78

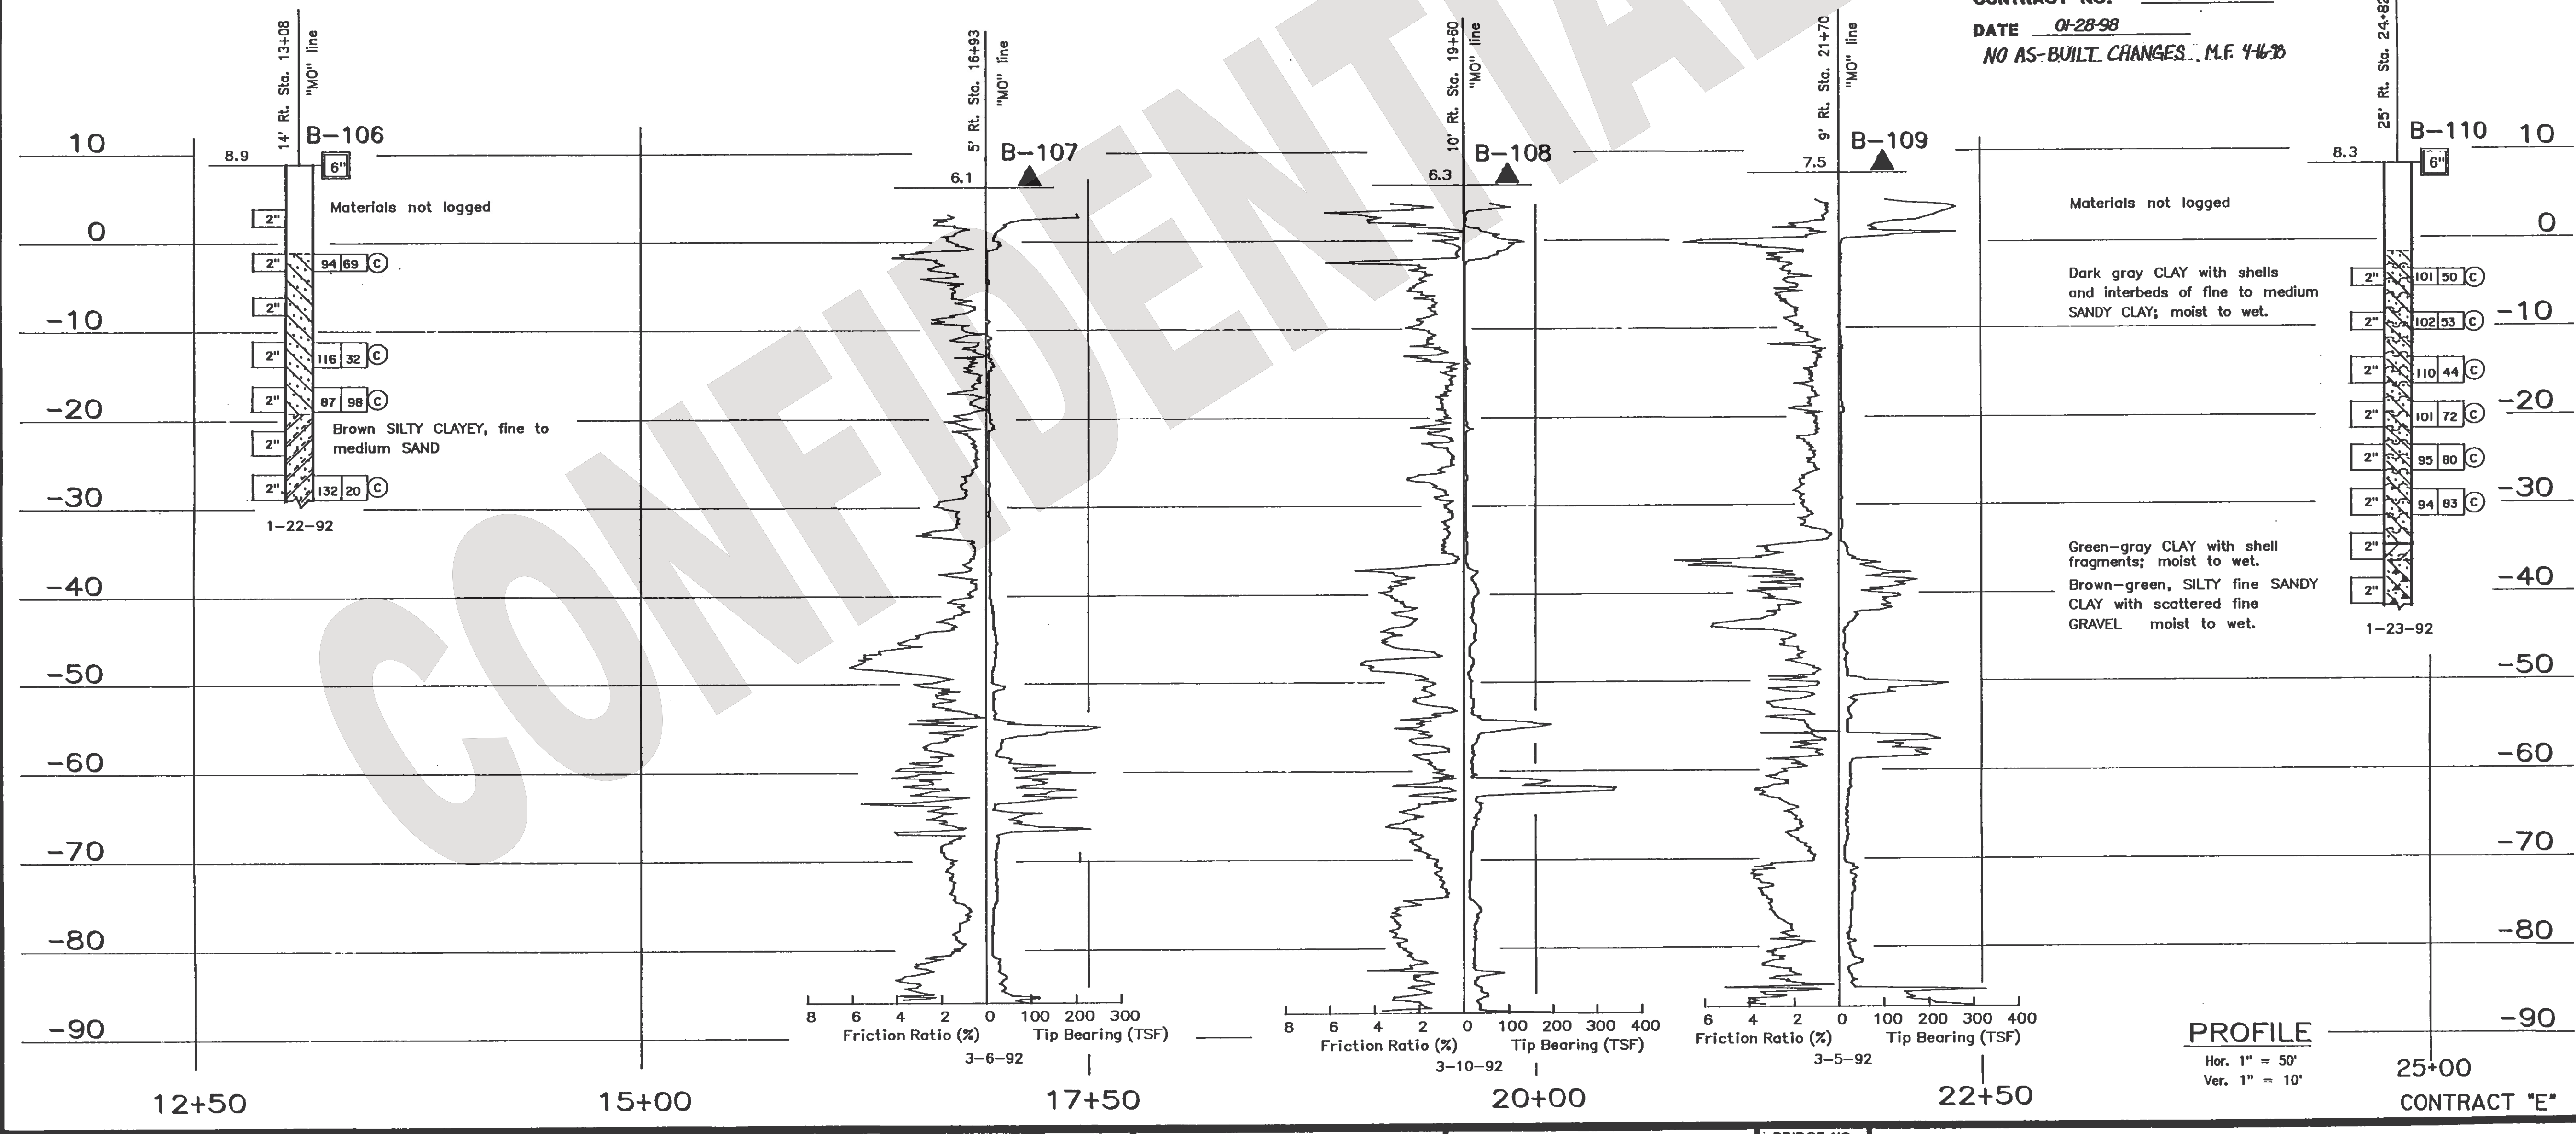

LEGEND OF BORING OPERATIONS

2 1/4" CONE PENETROMETER
 SAMPLE
 BORING (DRY)
 BORING (WET)
 ALGER
 BORING (DRY)
 TEST PIT
 DILUENT
 CORE BORING
 JET BORING
 ELECTRONIC CONE PENETROMETER

LEGEND OF EARTH MATERIALS

GRAVEL
 SAND
 SILT
 CLAY
 SANDY CLAY or CLAYEY SAND
 SANDY SILT or SILTY SAND
 SILTY CLAY

CLAYEY SILT
 SILT
 ORGANIC MATTER
 FILL MATERIAL
 IGNEOUS ROCK
 SEDIMENTARY ROCK
 METAMORPHIC ROCK

LEGEND OF BORING OPERATIONS (CONT.)

SOIL SAMPLE BORING (WET)
 Description of material
 Log weight (lb) (kg)
 % moisture
 % consolidation test
 Date measured
 Unconfined compressive strength (T_{un})
 Shear strength (S_u)
 Vane shear
 Unrecoverable material change
 Recoverable material change

SOIL SAMPLE BORING (DRY)
 Description of material
 Log weight (lb) (kg)
 Date measured
 Sample (S₁) taken
 Sample (S₂) taken
 Refusal
 Blows per foot
 Pulver pipe
 No count recorded
 Pushed
 Driving rate in seconds per foot (Using a 140 lb hammer with a 1 1/2" dia. anvil)
 No count recorded
 Pushed
 Driving rate in seconds per foot (Using a 140 lb hammer with a 1 1/2" dia. anvil)
 No count recorded
 Pushed
 Driving rate in seconds per foot (Using a 140 lb hammer with a 1 1/2" dia. anvil)

NOTE: Classification of earth material as shown on this sheet is based upon field inspection and is not to be construed to imply mechanical analysis.

CONSISTENCY CLASSIFICATION FOR SOILS

According to the Standard Penetration Test

Penetration (Blows / Ft)	Granular	Cohesive
0-4	Very loose	Very soft
5-9	Loose	Soft
10-19	Slightly compact	Silty
20-34	Compact	Very stiff
35-59	Dense	Hard
>70	Very dense	Very hard



OFFICE OF TRANSPORTATION MATERIALS & RESEARCH		ENGINEERING GEOLOGY BRANCH	FIELD INVESTIGATION BY: M. WILLIAN	State of CALIFORNIA DEPARTMENT OF TRANSPORTATION	DIVISION OF STRUCTURES STRUCTURE DESIGN	BRIDGE NO. 33-612 E	PORT OF OAKLAND CONN. VIADUCT
DRAWN BY: IRMA GAMARRA	5/92					POST MILE	LOG OF TEST BORINGS 4 OF 20
CHECKED BY:							

DIST	COUNTY	ROUTE	POST MILES TOTAL PROJECT	SHEET NO	TOTAL SHEETS
04	Ala	880.80	34.4 1.3/3.0	560	141

R.C. Williams
CERTIFIED ENGINEERING GEOLOGIST

REGISTERED GEOLOGIST
R.C. WILLIAMS
No. 280
Exp. 8-30-94
CERTIFIED ENGINEERING GEOLOGIST
STATE OF CALIFORNIA

6-13-94
PLANS APPROVAL DATE

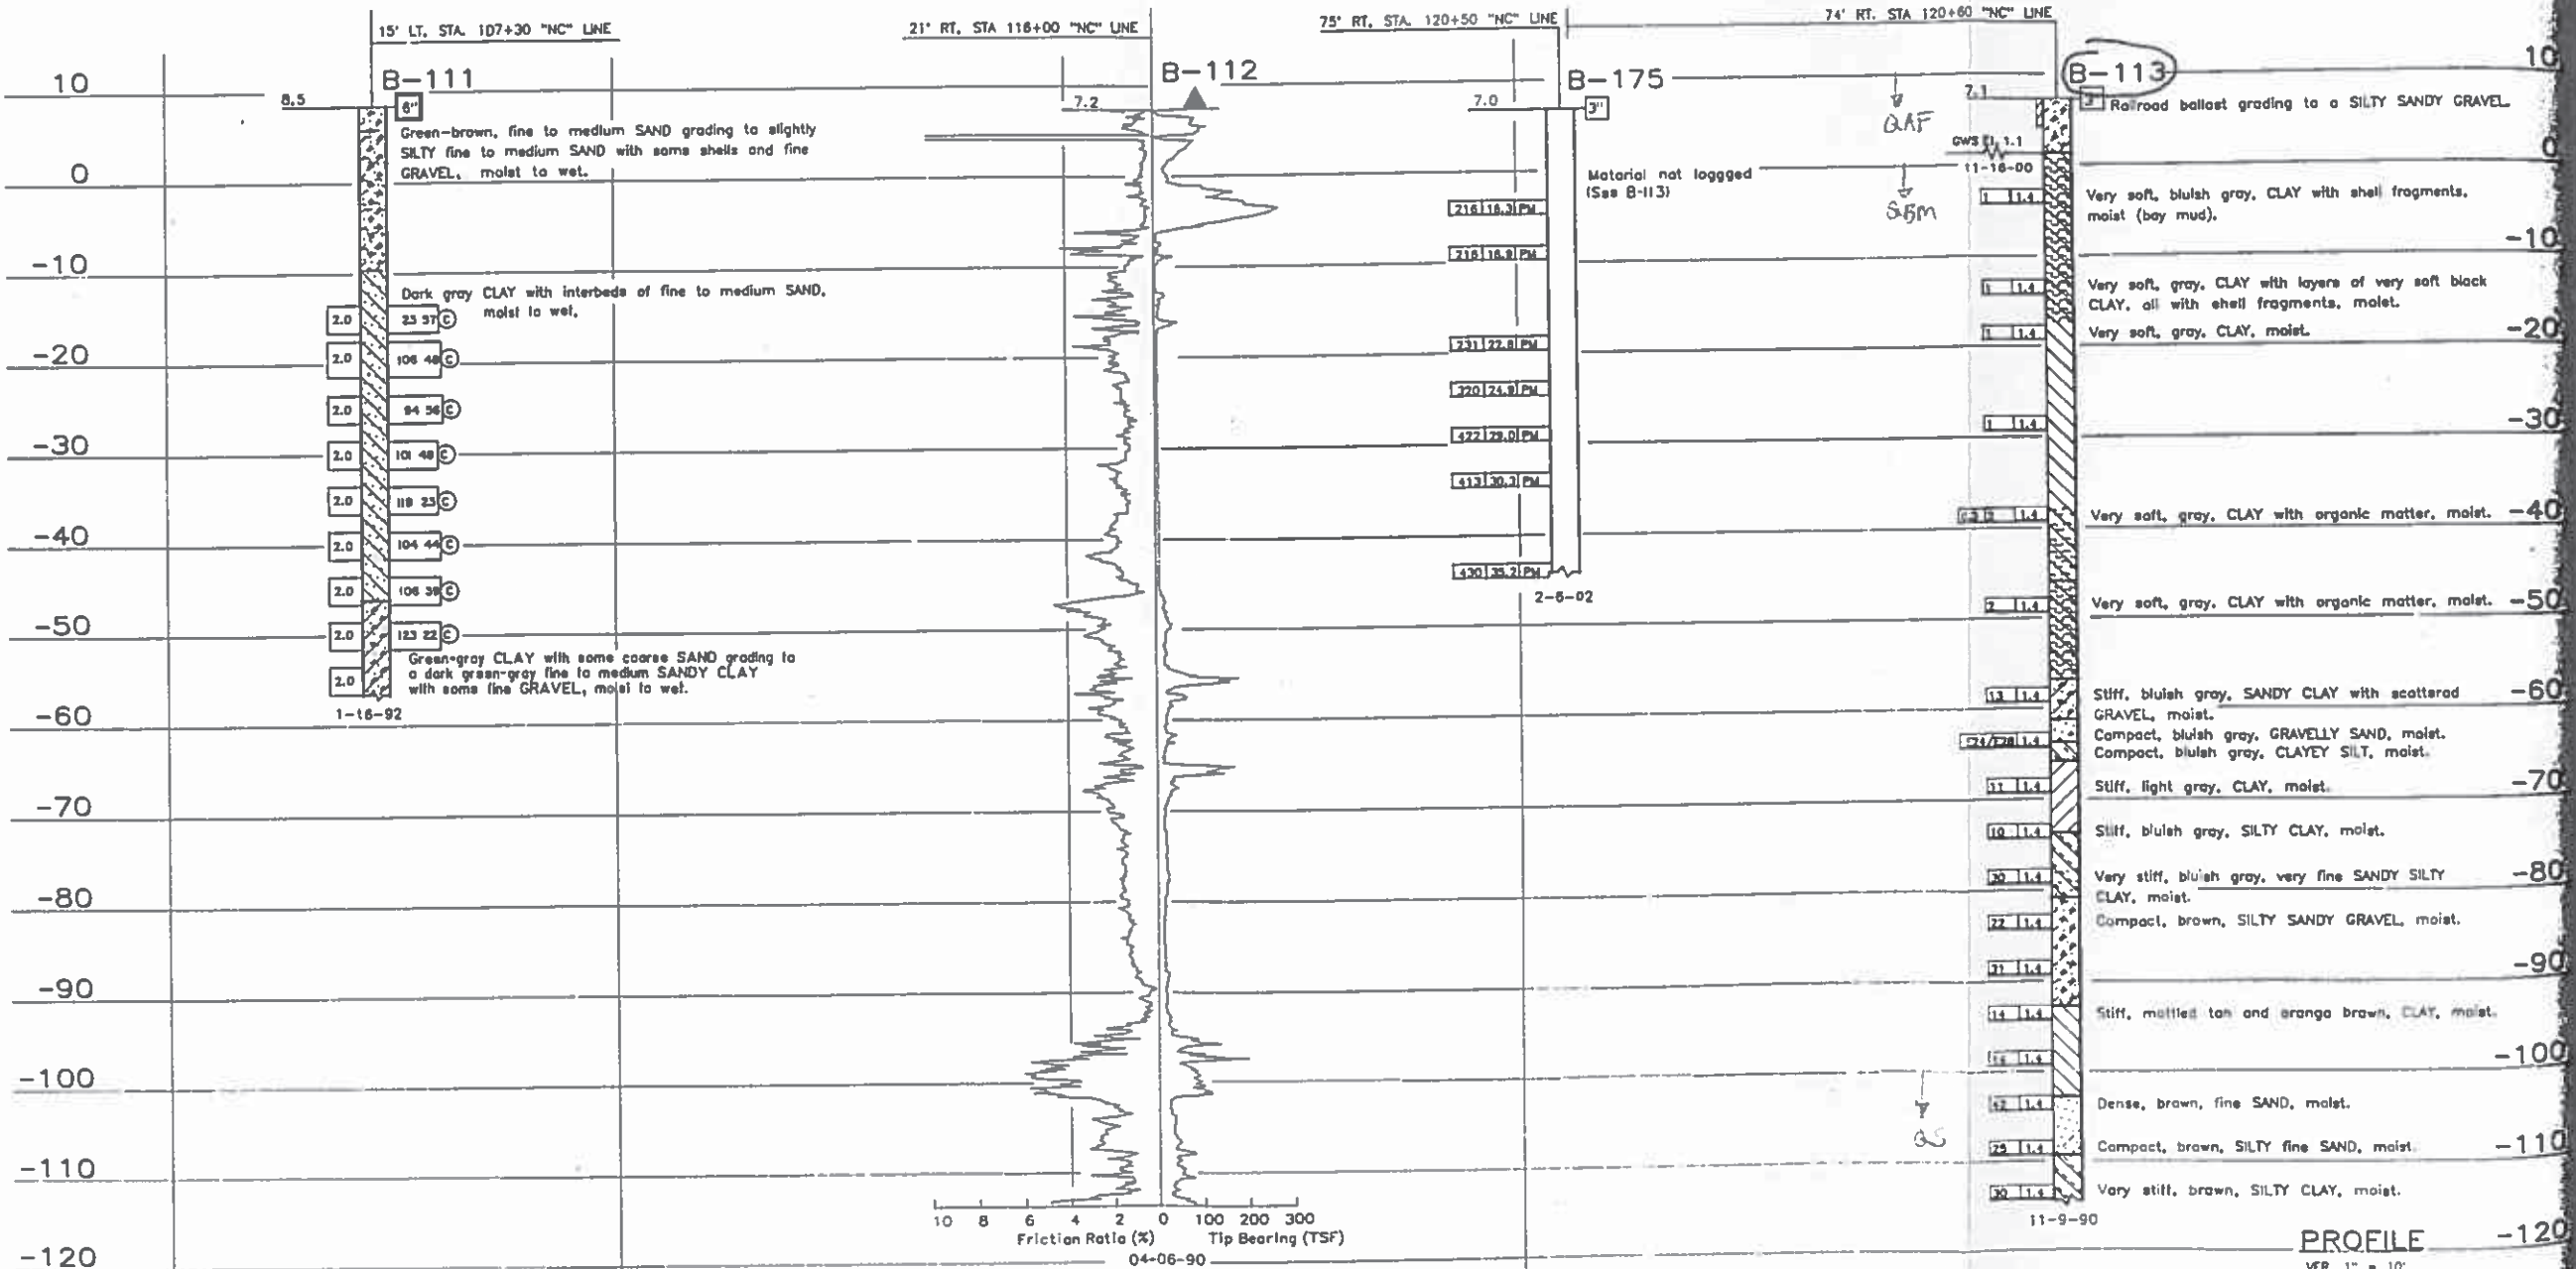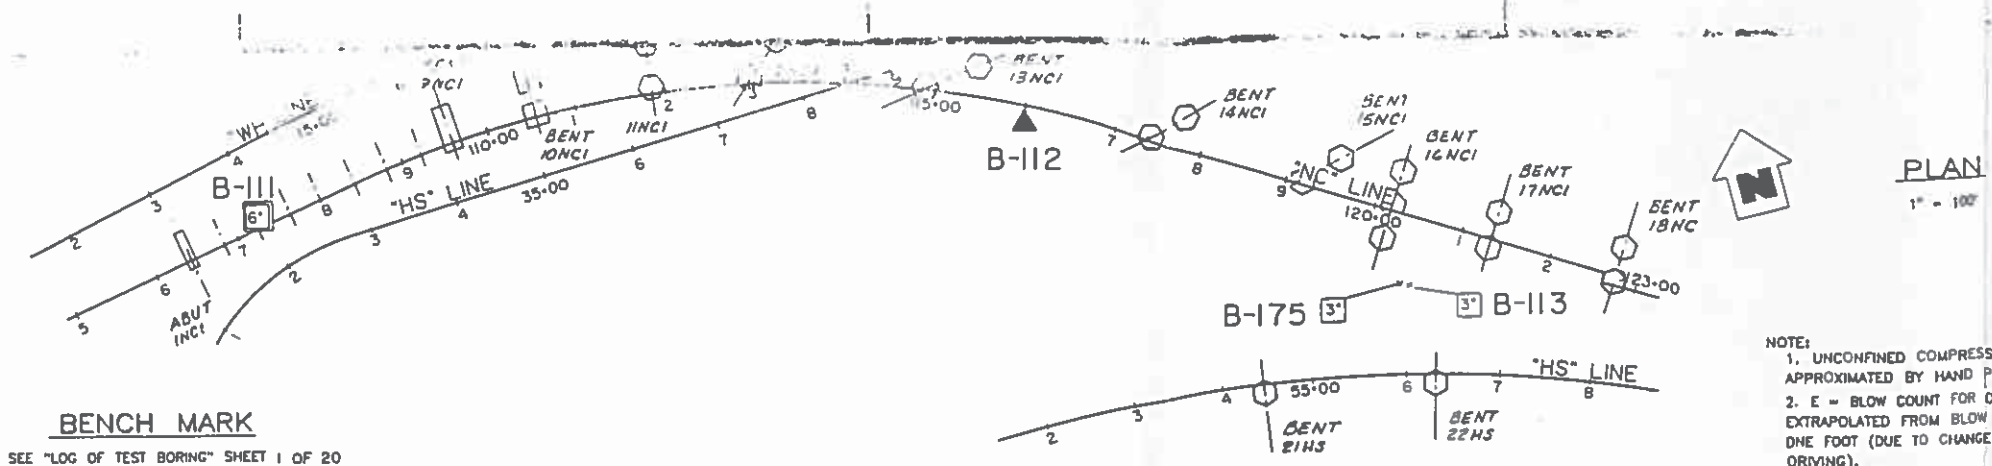

NOTE:
1. UNCONFINED COMPRESSIVE STRENGTH APPROXIMATED BY HAND PENETROMETER.
2. E = BLOW COUNT FOR ONE FOOT PENETRATION EXTRAPOLATED FROM BLOW COUNT FOR LESS THAN ONE FOOT (DUE TO CHANGE IN MATERIAL OR HARD DRIVING).

LEGEND

Menard's Modulus (psi)	245/27.8 PM
Net Limit Pressure (psi)	
Pressure Meter	

LEGEND OF BORING OPERATIONS

1. **PRELIMINARY OPERATIONS:** Includes diagrams for boring types (e.g., open hole, auger, wash), casing, and sampling methods. It details how to identify casing, casing logs, and how to handle casing changes.

2. **OPERATIONS:** Includes diagrams for sampling techniques (e.g., Shelby tube, split spoon, core sampler) and how to identify and log samples.

3. **TESTING:** Includes diagrams for various tests (e.g., SPT, GWS, CPT) and how to identify and log test results.

LEGEND OF EARTH MATERIALS

CONSISTENCY CLASSIFICATION FOR SOILS:

Penetration (Blows/ft)	Group	Consistency	
		Very loose	Very hard
0-4	Very loose	Very soft	Very hard
5-9	Loose	Soft	Very hard
10-19	Slightly compact	Stiff	Very hard
20-29	Compact	Very stiff	Very hard
30-39	Very compact	Very stiff	Very hard
40-49	Very dense	Very stiff	Very hard

NOTE: Classification of earth material as shown on this sheet is based upon field inspection and is not to be construed to imply mechanical analysis.

OFFICE OF TRANSPORTATION MATERIALS & RESEARCH ENGINEERING GEOLOGY BRANCH

FIELD INVESTIGATION BY: M. WILLIAM

State of CALIFORNIA DEPARTMENT OF TRANSPORTATION


DIVISION OF STRUCTURES STRUCTURE DESIGN

BRIDGE NO. 33-612 E PORT OF OAKLAND CONN. VIADUCT

POST MILE LOG OF TEST BORINGS 5 OF 24

DISREGARD PRINTS BEARING EARLIER REVISION DATES

REVISION DATES (PRELIMINARY STAGE ONLY)

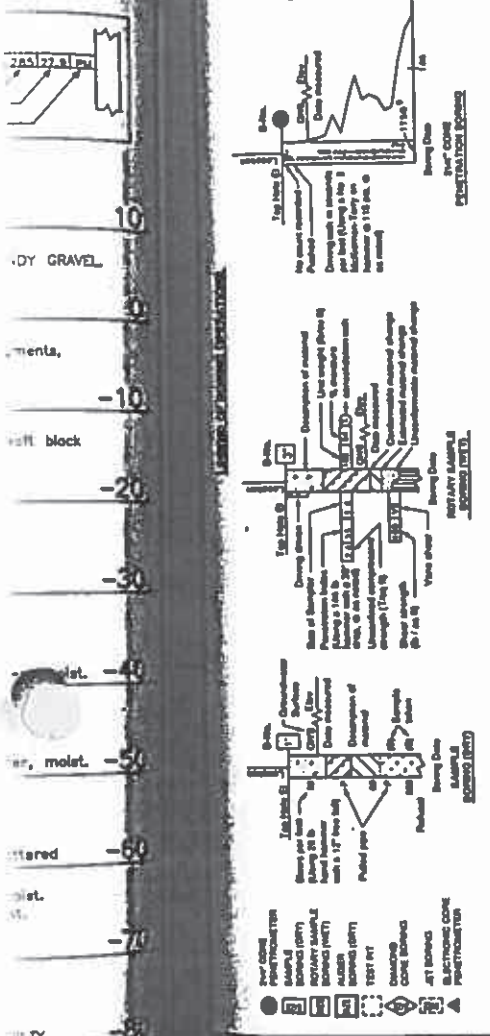


Soil Type	Color	Consistency
Gravel	Very loose	Very soft
Sand	Loose	Soft
Silty Sand	Slightly compact	Stiff
Clayey Sand	Compact	Very stiff
Silty Sand	Dense	Hard
Clay	Very dense	Very hard

CONTRACT NO. 5 OF 19

BENCH MARK
SEE "LOG OF TEST BORINGS 1 OF 20"


- NOTES:**
- UNCONFINED COMPRESSIVE STRENGTH APPROXIMATED BY HAND PENETROMETER TEST
 - E = BLOW COUNT FOR ONE FOOT PENETRATION EXTRAPOLATED FROM BLOW COUNT FOR LESS THAN ONE FOOT (DUE TO CHANGE IN MATERIAL OR HARD DRIVING)

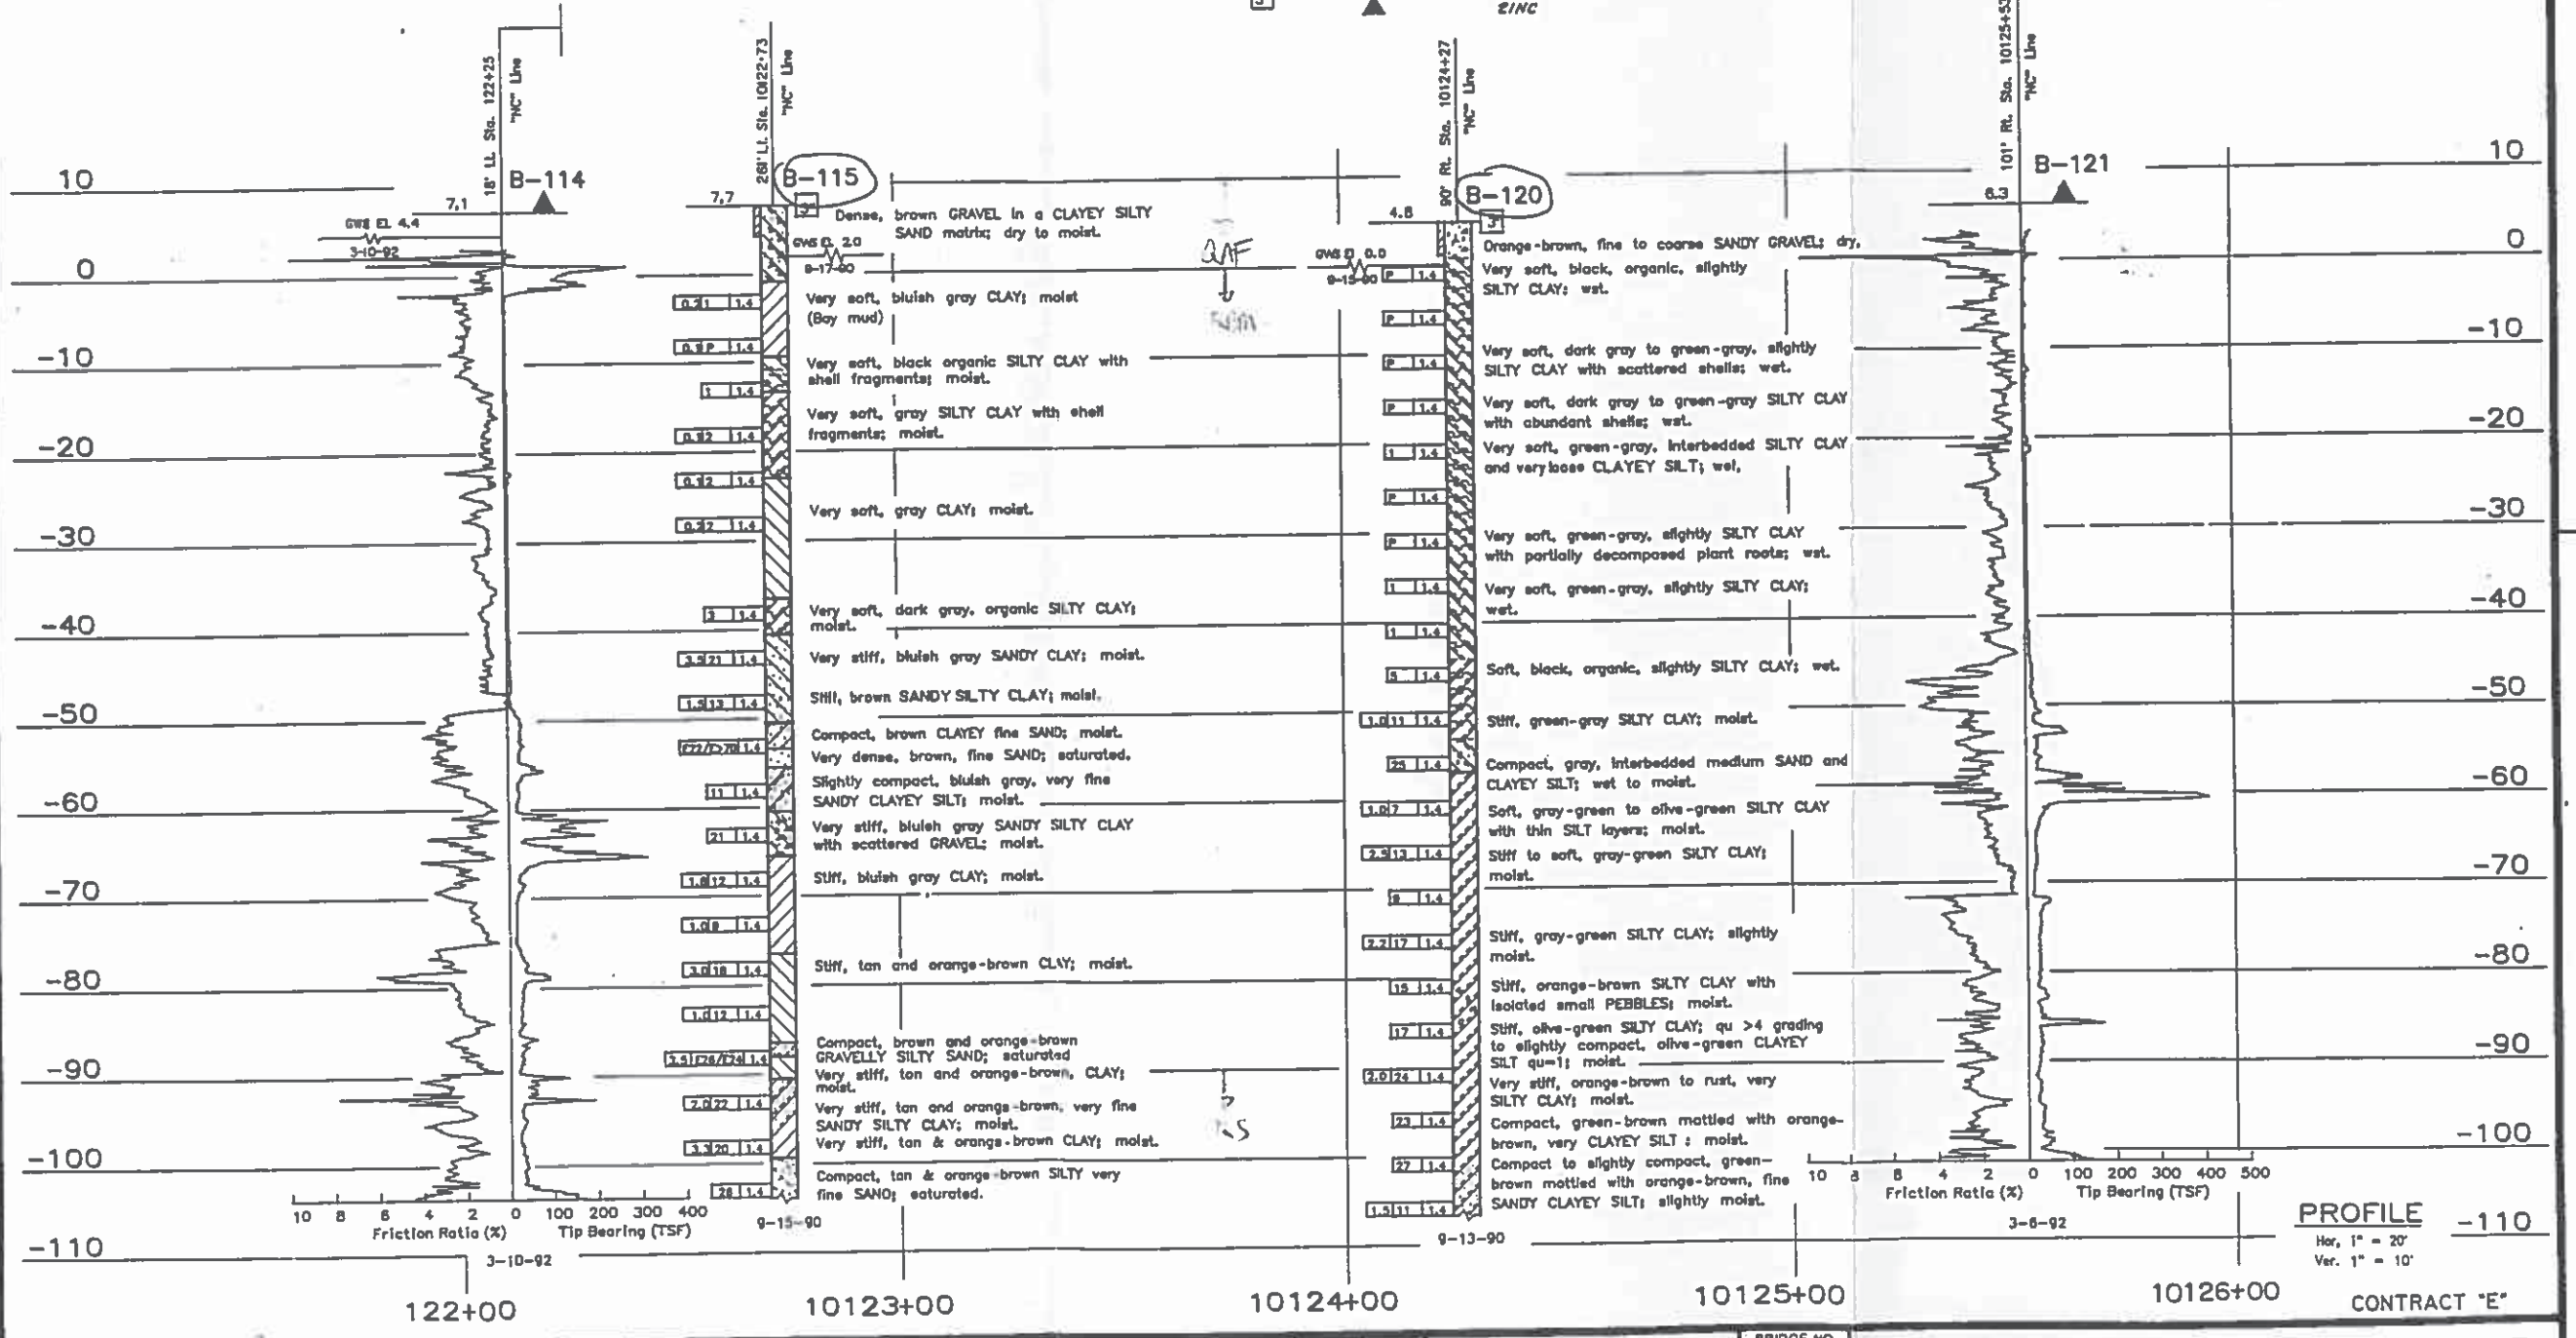

Station	Friction Ratio (%)	Tip Bearing (TSF)
122+00	3-10-92	
10123+00		9-15-90
10124+00		9-13-90
10125+00		3-8-92
10126+00		

<p>OFFICE OF TRANSPORTATION MATERIALS & RESEARCH</p> <p>ENGINEERING GEOLOGY BRANCH</p> <p>FIELD INVESTIGATION BY: M. WILLIAM</p>	<p>State of CALIFORNIA</p> <p>DEPARTMENT OF TRANSPORTATION</p>	<p>DIVISION OF STRUCTURES</p> <p>STRUCTURE DESIGN</p>	<p>BRIDGE NO. 33-612 E</p> <p>POST MILE</p>
<p>DRAWN BY: IRMA GAMARRA 5/92</p> <p>CHECKED BY:</p>	<p>ORIGINAL SCALE IN INCHES FOR REDUCED PLANS</p>	<p>CU 04</p> <p>EA 192231</p>	<p>DISREGARD EARLIER</p>

DIST. 04	COUNTY. Alameda	ROUTE. B80.80	POST MILES TOTAL PROJECT. 34.4, 1, 3/3, 0	SHEET NO. 561	TOTAL SHEETS. 1412
<p>6-13-84 PLANS APPROVAL DATE</p>					

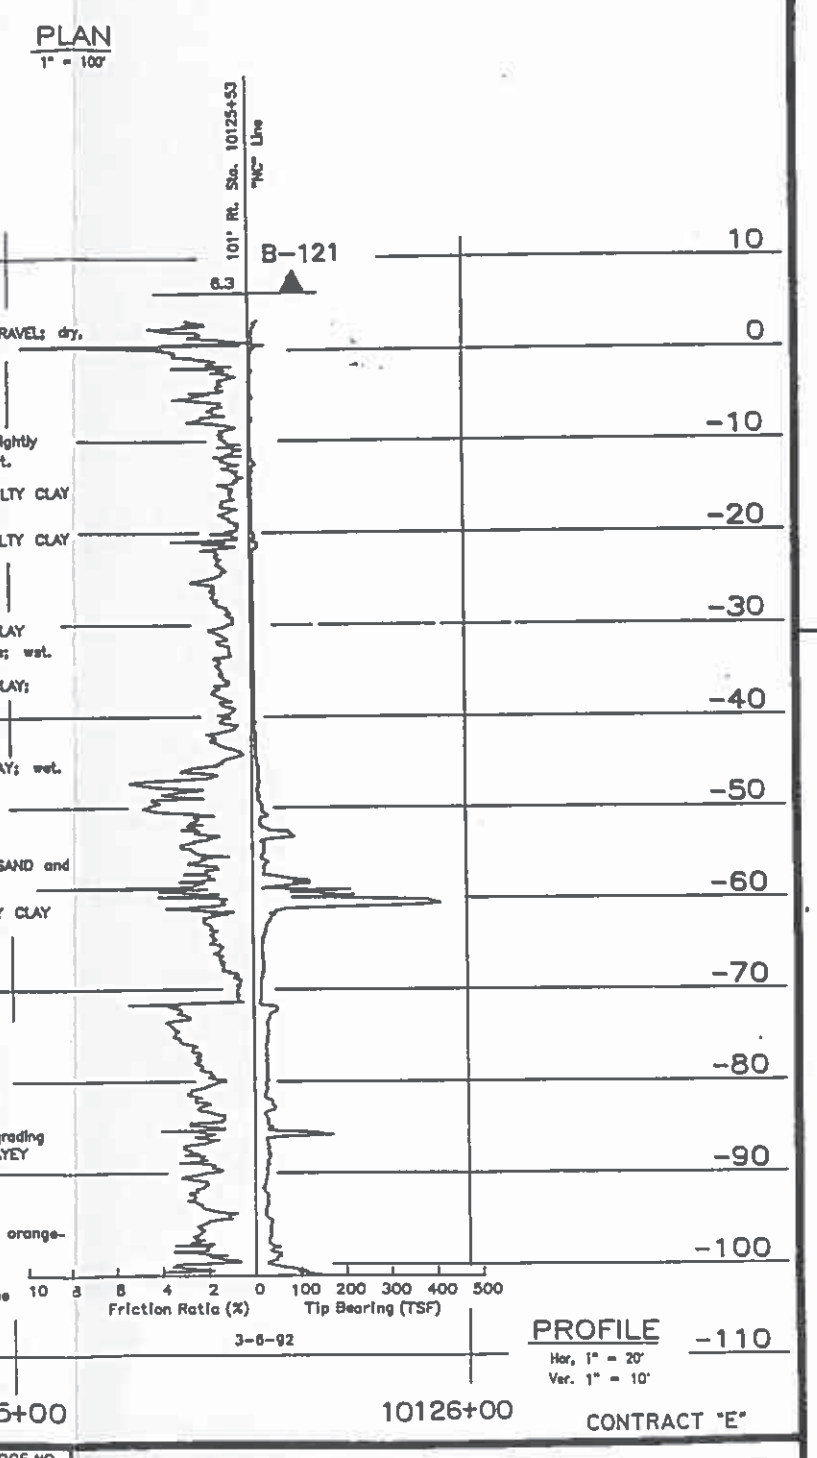


<p>PORT OF OAKLAND CONN. VIADUCT</p> <p>LOG OF TEST BORINGS 6 OF 20</p>	<p>PRELIMINARY STAGE ONLY</p>
---	-------------------------------

DIST	COUNTY	ROUTE	TOTAL PROJECT	SHEET NO.
04	Ala	880, 80	34, 4. 1.3/3.0	562

R.C. Williams
CERTIFIED ENGINEERING GEOLOGIST

6-13-94
PLANS APPROVAL DATE


REGISTERED PROFESSIONAL ENGINEER
No. 10000
Exp. 8-31-94
STATE OF CALIFORNIA

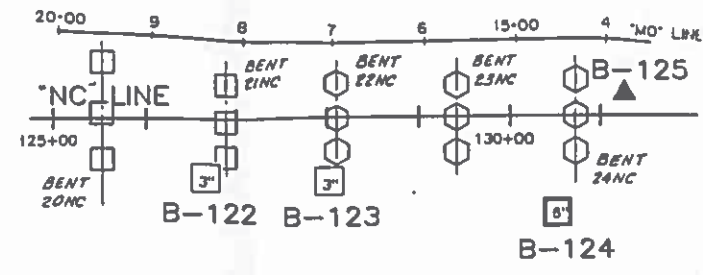

BENCH MARK
See "Log of Test Borings" of 20

NOTES:

- UNCONFINED COMPRESSIVE STRENGTH APPROXIMATED BY HAND PENETROMETER TEST
- E = BLOW COUNT FOR ONE FOOT PENETRATION EXTRAPOLATED FROM BLOW COUNT FOR LESS THAN ONE FOOT (DUE TO CHANGE IN MATERIAL OR HARD DRIVING)

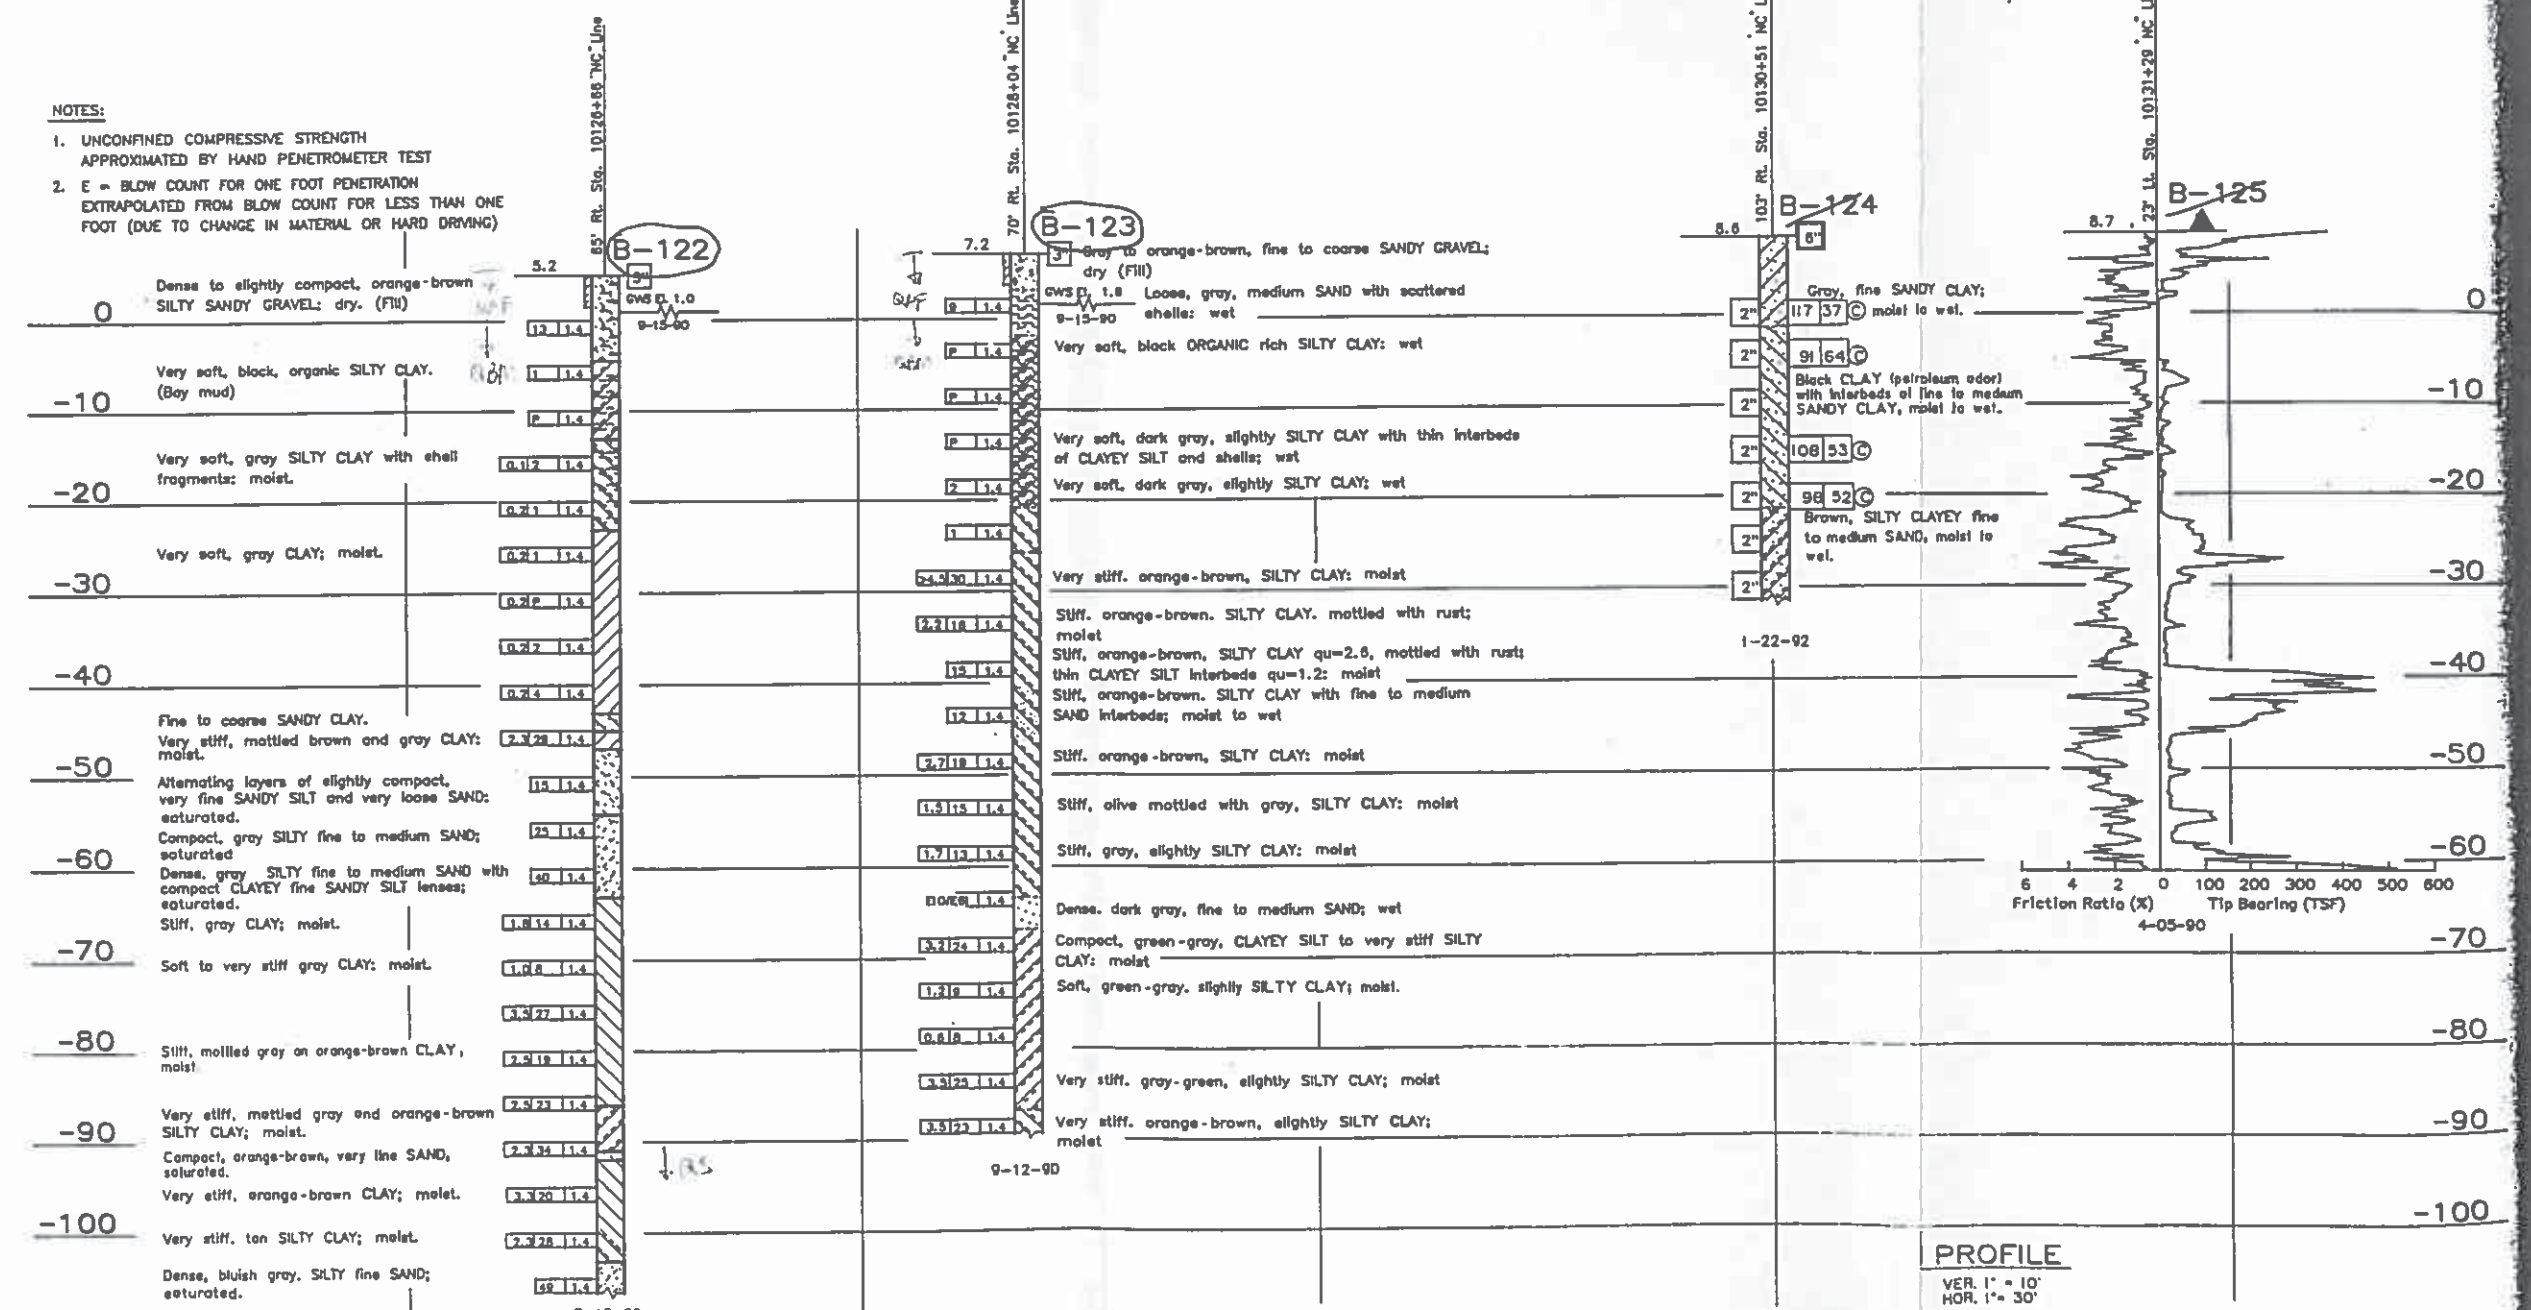

PROFILE

VER. 1" = 10'
HOR. 1" = 30'

LEGEND OF SYMBOLS AND NOTATIONS

LEGEND OF SOIL CLASSIFICATIONS

LEGEND OF EARTH MATERIALS

LEGEND OF BENCH MARKS

LEGEND OF TEST METHODS

LEGEND OF PENETROMETER TESTS

LEGEND OF SOIL SAMPLES

LEGEND OF SOIL TESTS

LEGEND OF SOIL CLASSIFICATION

LEGEND OF EARTH MATERIALS

LEGEND OF BENCH MARKS

LEGEND OF TEST METHODS

LEGEND OF PENETROMETER TESTS

LEGEND OF SOIL SAMPLES

LEGEND OF SOIL TESTS

NOTE: Classification of earth material as shown on this sheet is based upon field inspection and is not to be construed to imply mechanical analysis.

OFFICE OF TRANSPORTATION MATERIALS & RESEARCH
ED FONG

ENGINEERING GEOLOGY BRANCH
5-92

FIELD INVESTIGATION BY:
M. WILLIAM

State of CALIFORNIA
DEPARTMENT OF TRANSPORTATION

DIVISION OF STRUCTURES
STRUCTURE DESIGN

BRIDGE NO. 33-812 E
POST MILE

PORT OF OAKLAND CONN. VIADUCT

LOG OF TEST BORINGS 7 OF



ORIGINAL SCALE IN INCHES FOR REDUCED PLANS



CU EA 192231


DISREGARD PRINTS BEARING EARLIER REVISION DATES

REVISION DATES (PRELIMINARY STAGE ONLY)

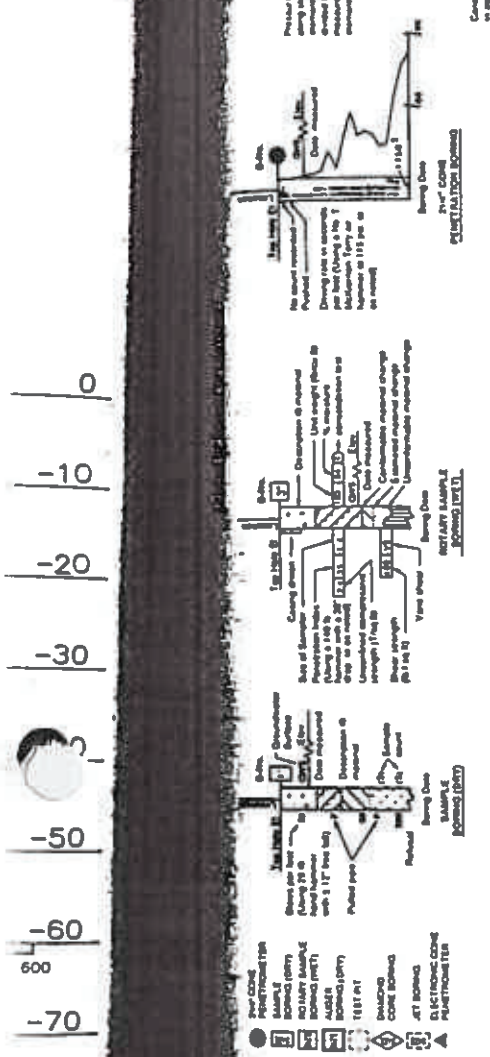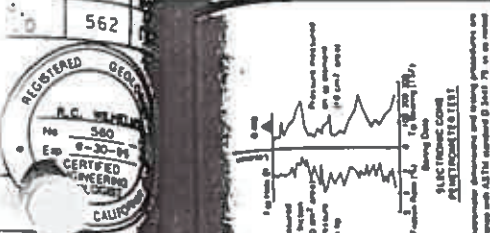

Penetration (Blows/Ft)	Consistency
0-5	Very soft
5-10	Soft
10-20	Medium
20-30	Stiff
30-50	Very stiff
50-70	Hard
70-100	Very hard

NOTE: Classification of soils based on values in this chart of blow counts, liquid limit, and plasticity index is not to be considered as a final determination of soil type.

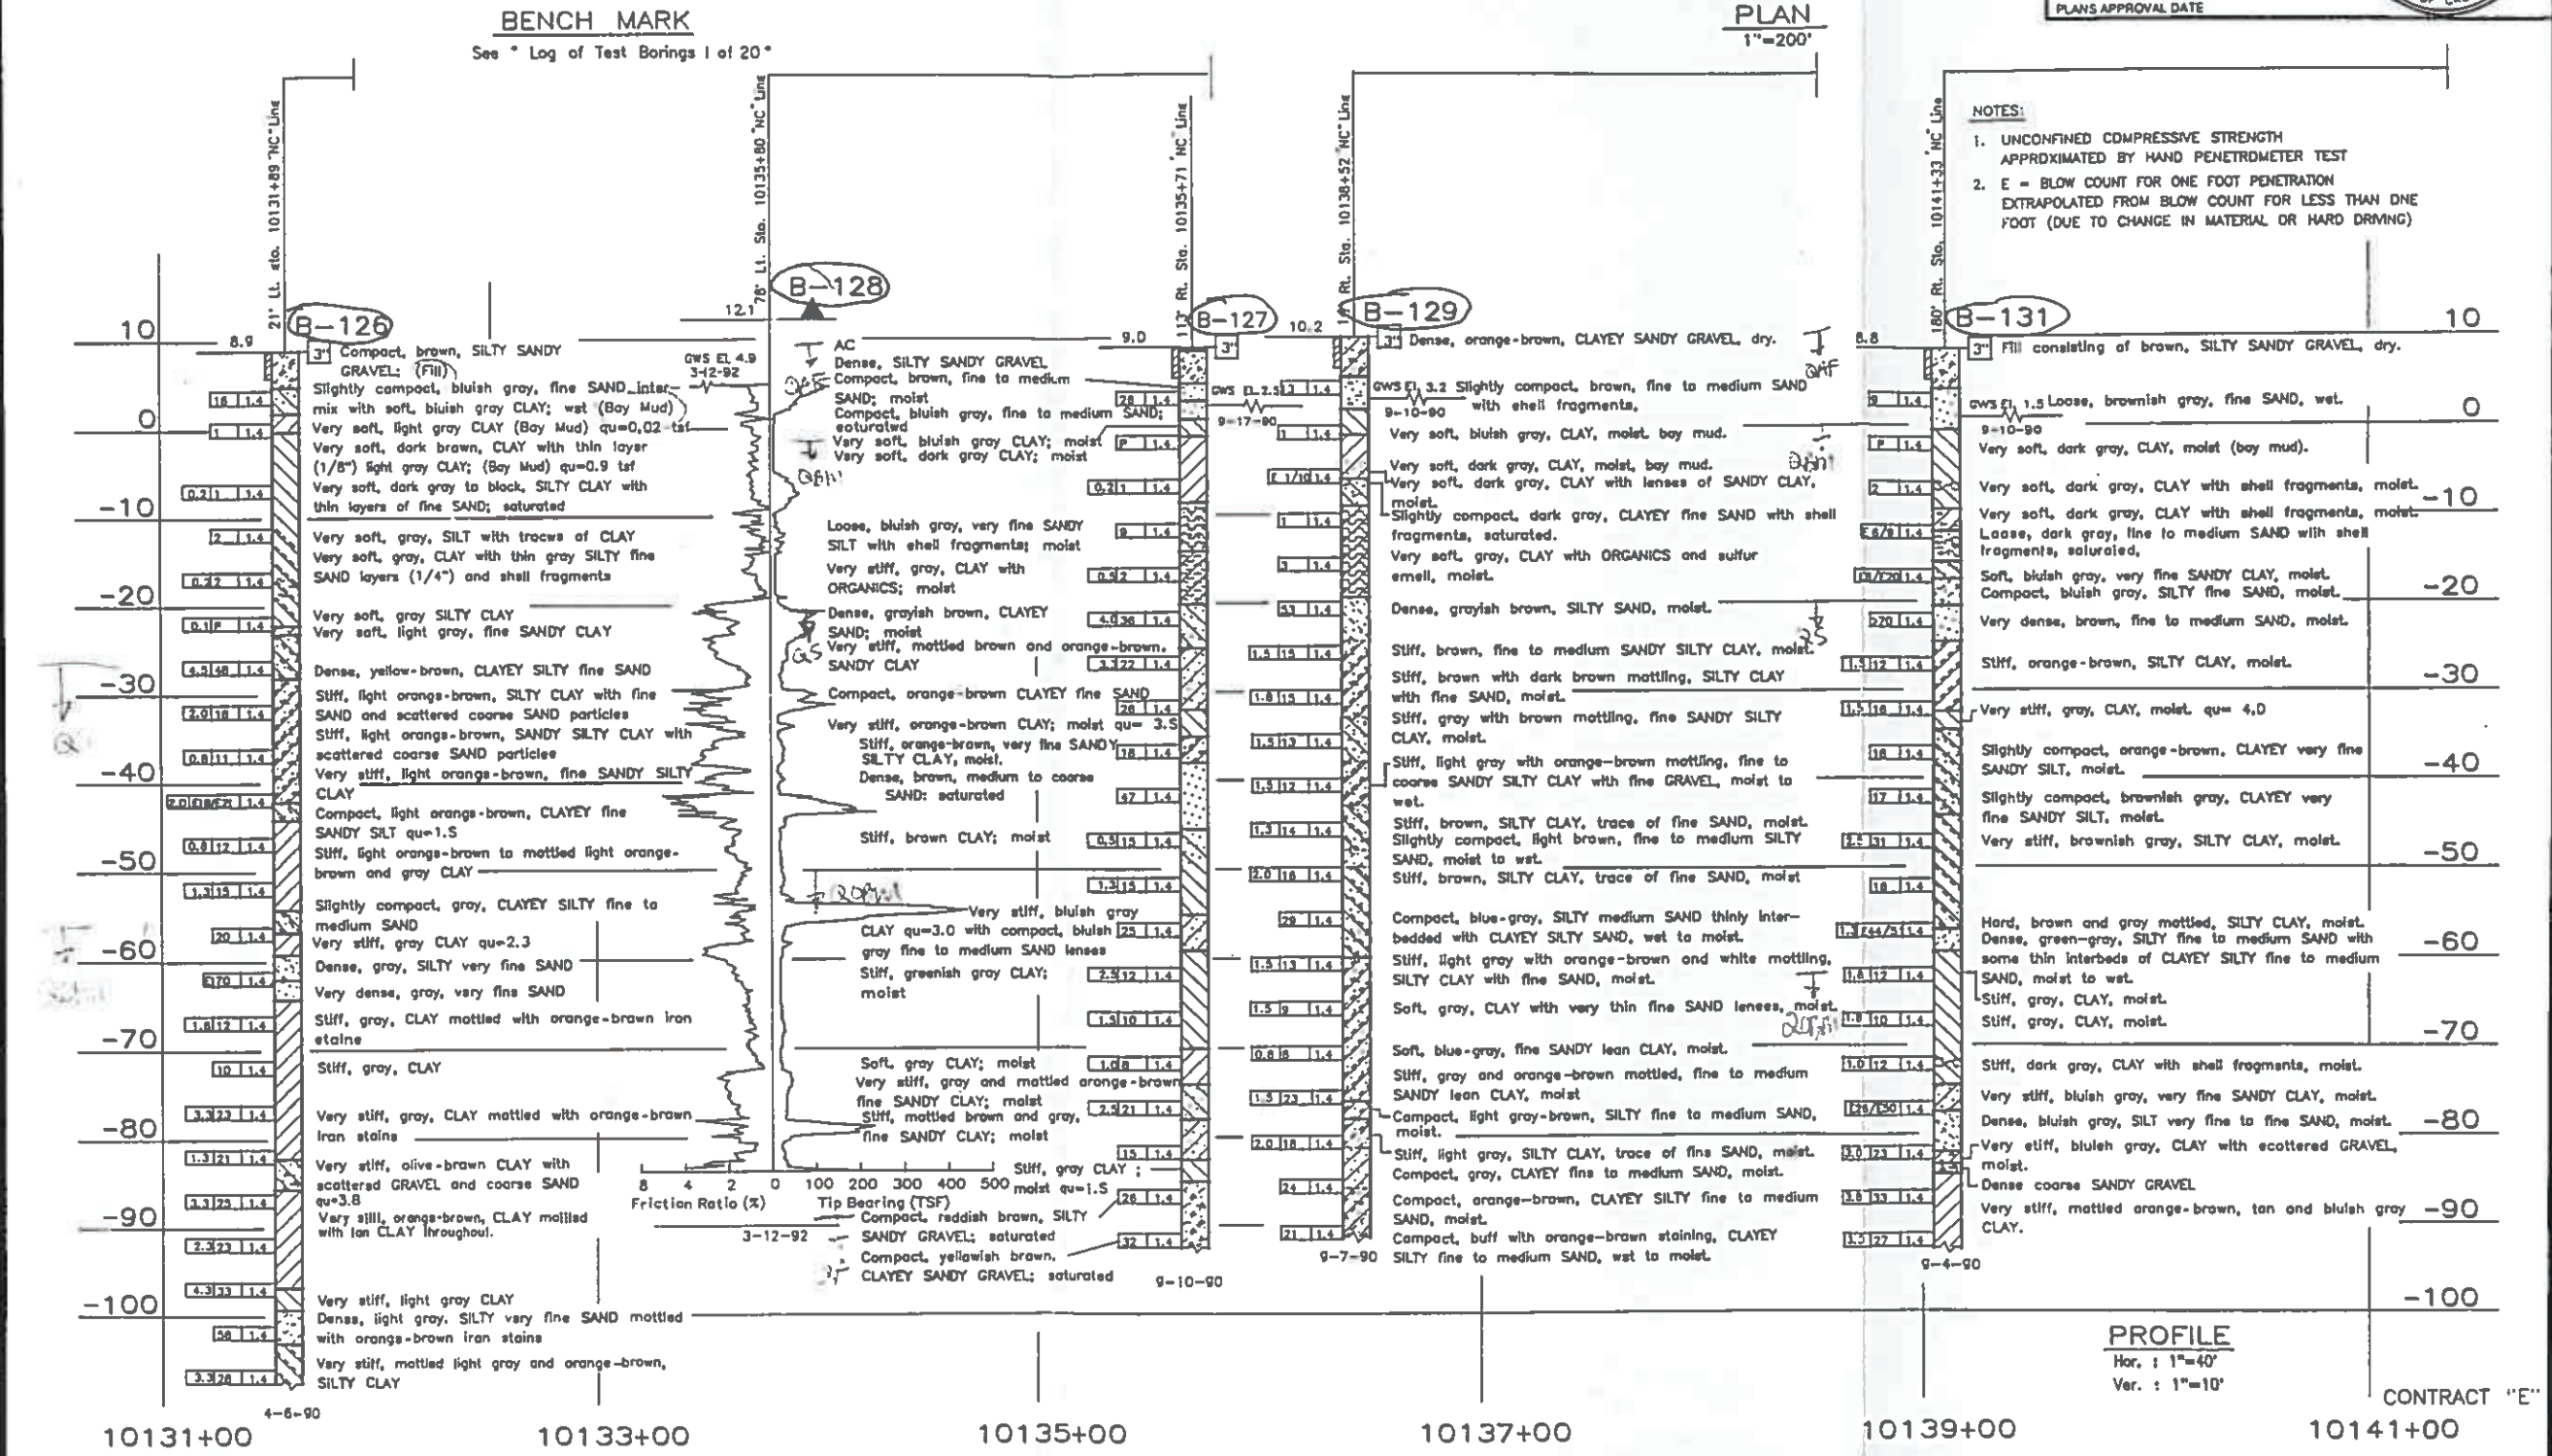


DIVISION OF NEW TECHNOLOGY, MATERIALS AND RESEARCH		OFFICE OF ENGINEERING GEOLOGY		FIELD INVESTIGATION BY		State of CALIFORNIA DEPARTMENT OF TRANSPORTATION		DIVISION OF STRUCTURES STRUCTURE DESIGN		BRIDGE NO. 33-612 E		PORT OF OAKLAND CONN. VIADUCT	
DRAWN BY ED FONG		5-92		M. WILLIAM		CU 04 EA 192231		POST MILE		DISREGARD PRINTS BEARING EARLIER REVISION DATES		REVISION DATES PRELIMINARY STAGE	
CHECKED BY												122 148	

248.8-126
 B-127
 B-128
 B-129
 B-131

DIST	COUNTY	ROUTE	POST MILES TOTAL PROJECT	SHEET NO	TOTAL SHEETS
04	Alc	880, 80	34.4 1.3/3.0	563	1412

6-13-54
 PLANS APPROVAL DATE

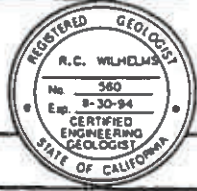

CONTRACT VIADUCT

CONTRACT "E"

LOG OF TEST BORINGS B OF 20

PROJECT NO. 568
 REGISTERED PROFESSIONAL ENGINEER
 STATE OF CALIFORNIA
 H. R. TABER
 No. 817
 EXP. 12-31-92
 GEOTECHNICAL PROFESSIONAL
 PLANS APPROVAL DATE
 6-13-94


248 B-158
 -B-159
 -B-160

DIST	COUNTY	ROUTE	POST MILES	TOTAL PROJECT	SHEET NO	TOTAL SHEETS
04	Alameda	880.80	34.4	1.3/3.0	569	1412

TABER CONSULTANTS
 536 Galveston Street
 West Sacramento, CA 95691

Field Study By: T. A. Krause & W. E. Nichols

FOR PLAN VIEW, SEE SHEET 1 OF 20

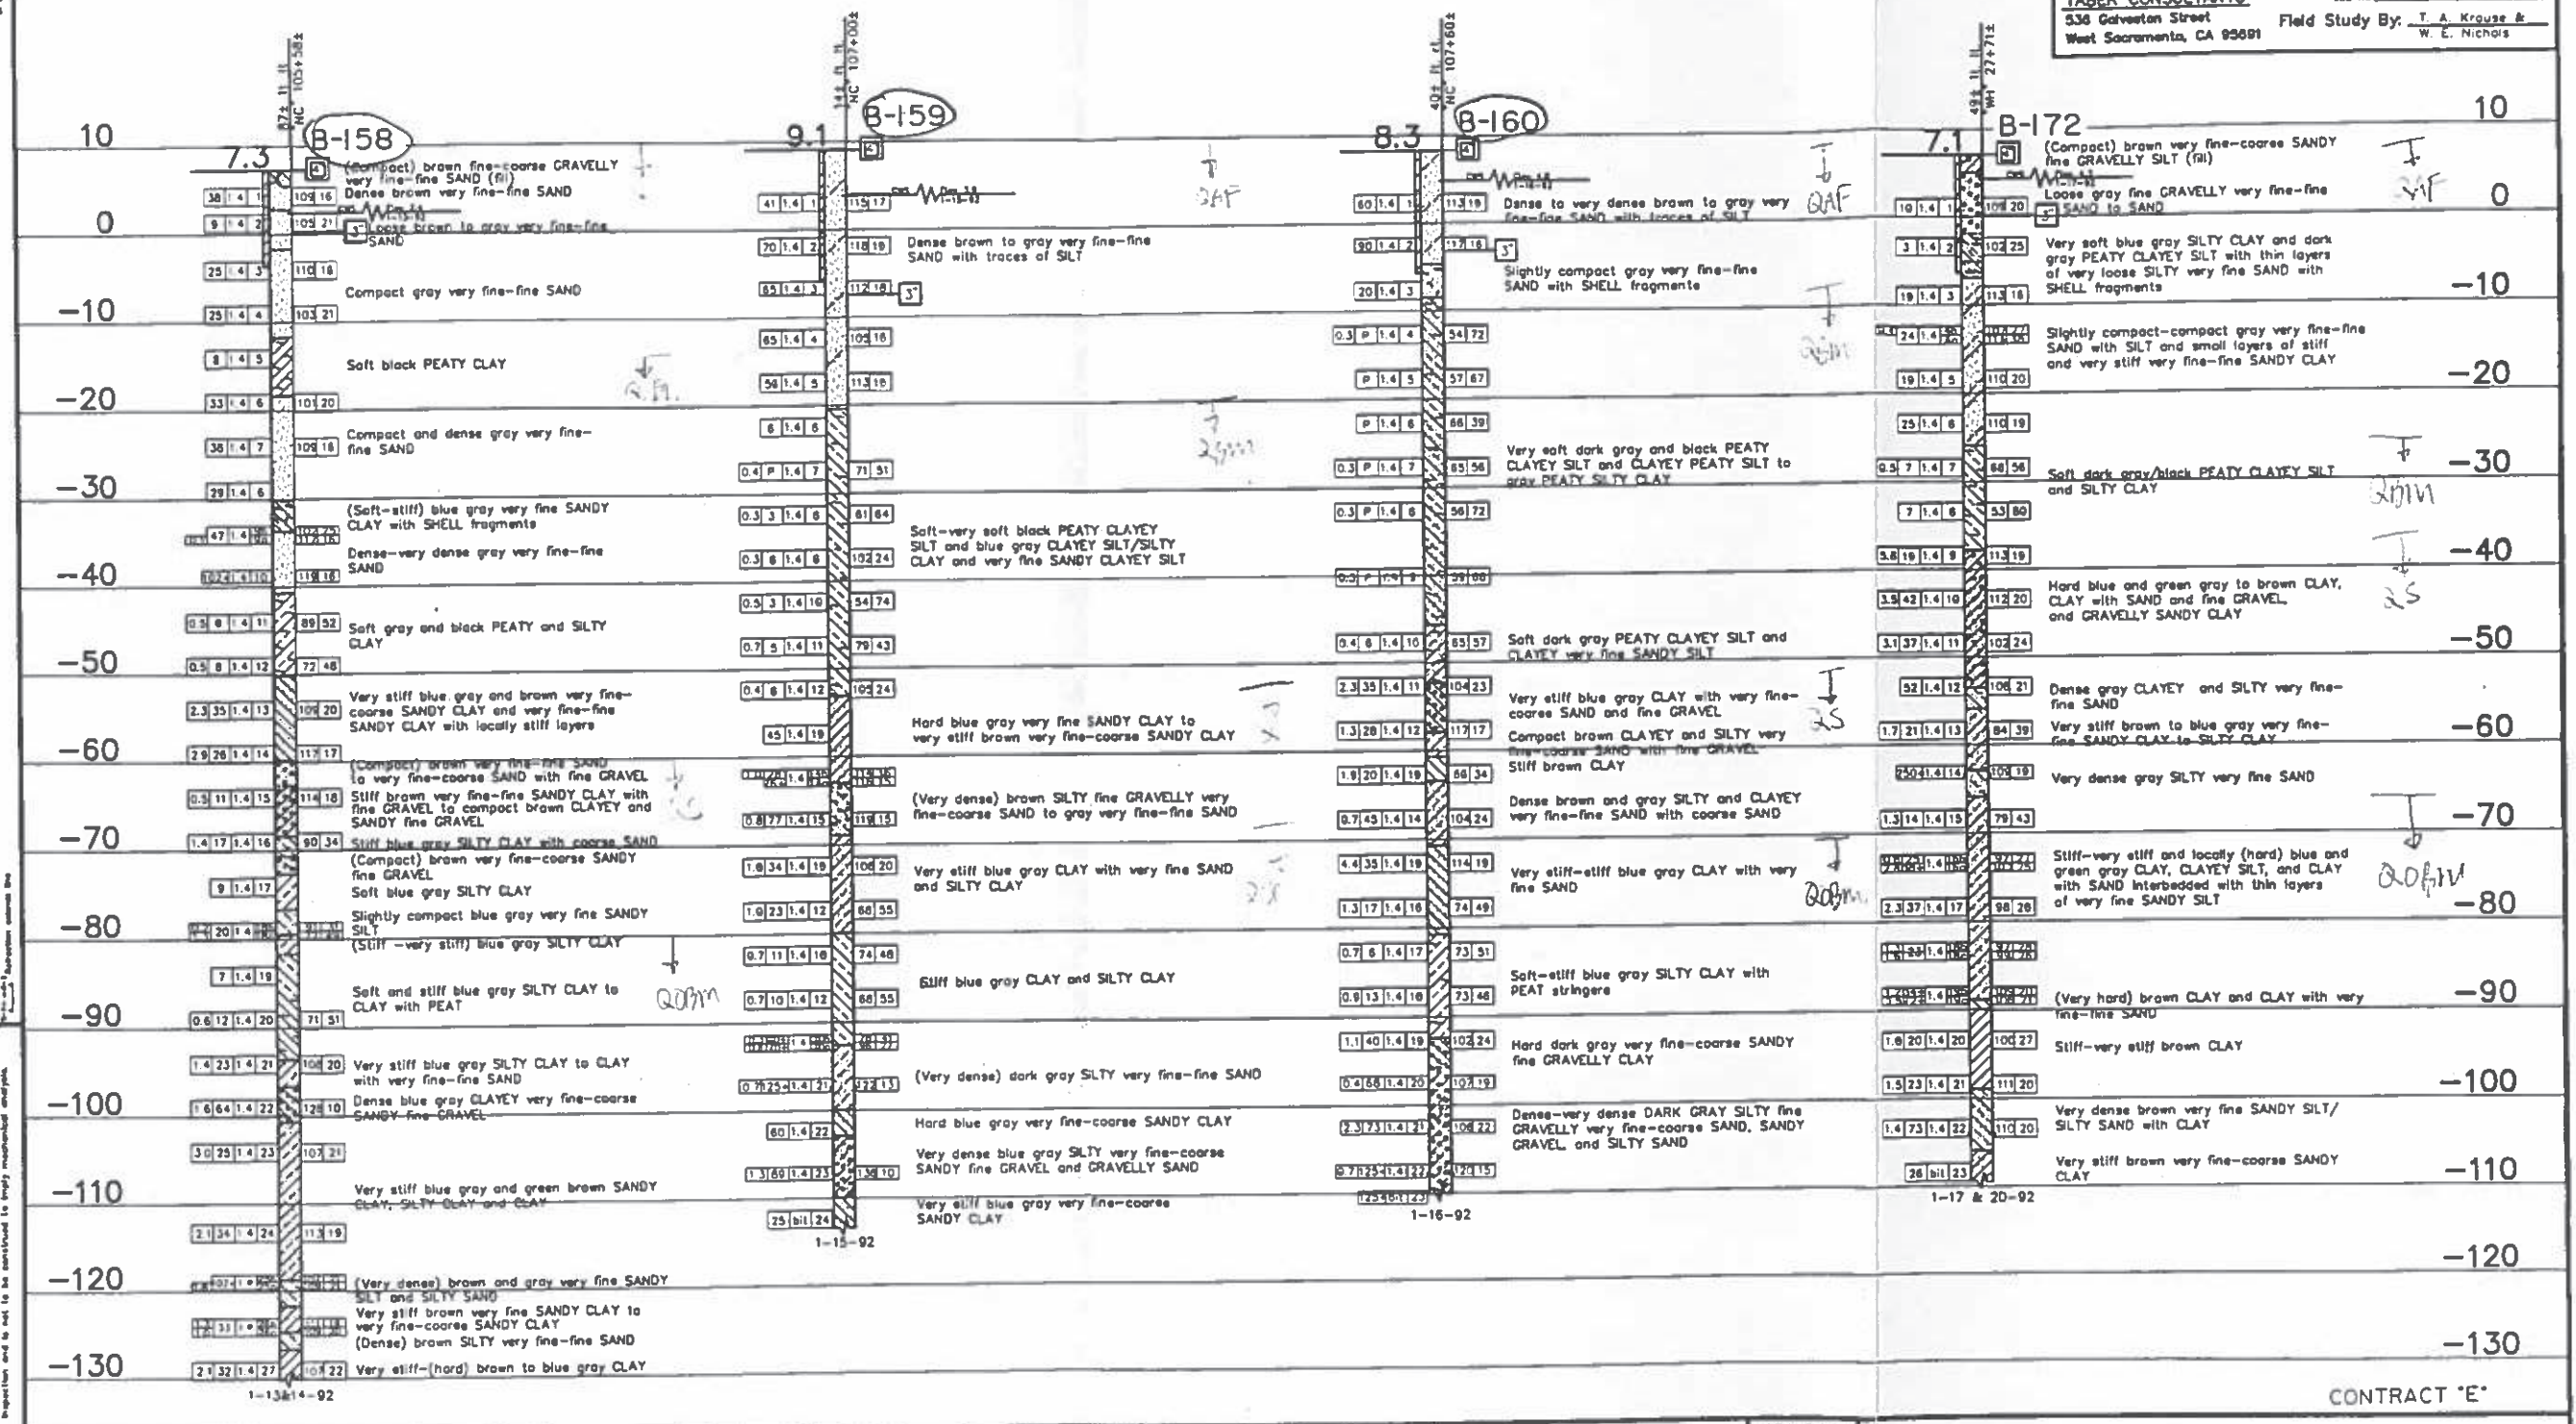

Soil Classification Legend

Symbol	Soil Type
[Symbol]	CLAYEY SILT
[Symbol]	SILT
[Symbol]	SANDY SILT
[Symbol]	SAND
[Symbol]	GRAVEL
[Symbol]	CLAY
[Symbol]	SANDY CLAY
[Symbol]	CLAYEY SAND
[Symbol]	SANDY CLAY
[Symbol]	SANDY SILT
[Symbol]	SILT
[Symbol]	SAND
[Symbol]	GRAVEL

Soil Characteristics: Very soft, Soft, Medium stiff, Very stiff, Very hard.

ENGINEERING GEOLOGY BRANCH - TRANSPORTATION LABORATORY

Prepared for the State of CALIFORNIA DEPARTMENT OF TRANSPORTATION

DIVISION OF STRUCTURES STRUCTURE DESIGN

BRIDGE NO. 33-612 E

PORT OF OAKLAND CONN. VIADUCT

LOG OF TEST BORINGS 14 OF 20

CONTRACT 'E'

Drawn by: M.D.R. 1/92
 Checked by: T.A.K. & W.E.N. 2/92

PROJECT ENGINEER

ORIGINAL SCALE IN INCHES FOR REDUCED PLANS

DISCARD PRINTS BEARING EARLIER REVISION DATES

DIST.	COUNTY	ROUTE	POST MILES TOTAL PROJECT	SHEET NO.	TOTAL SHEETS
04	Ala	880	34.3/35.0	902	940

H.R. Taber
GEOTECHNICAL PROFESSIONAL

No. 817
 EXP. 12-31-92
REGISTERED PROFESSIONAL ENGINEER
STATE OF CALIFORNIA

3-13-95
 PLANS APPROVAL DATE






TABER CONSULTANTS JOB No. 1P1/388/72.019
 536 Galveston Street Field Study By: T. A. Krause & W. E. Nichols
 West Sacramento, CA 95691

The State of California or its officers or agents shall not be responsible for the accuracy or completeness of electronic copies of this plan sheet.

AS BUILT

CORRECTIONS BY S. WHIPPLE
 CONTRACT NO. 04-192244
 DATE 01-28-98
 NO AS-BUILT CHANGES M.F. 4-4-98

FOR PLAN VIEW, SEE SHEET I OF 20

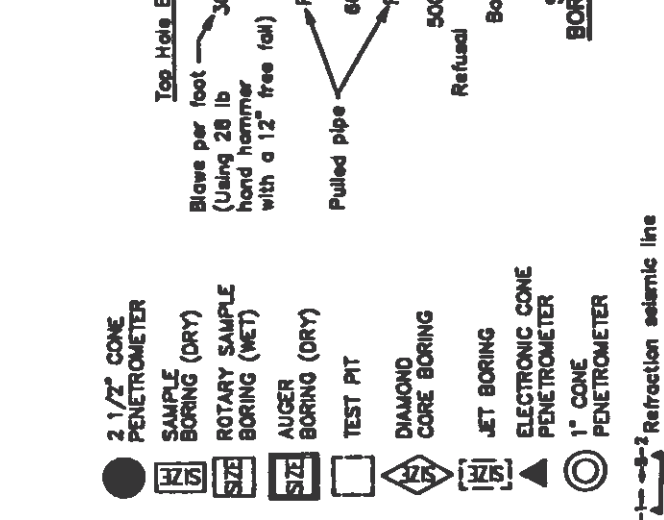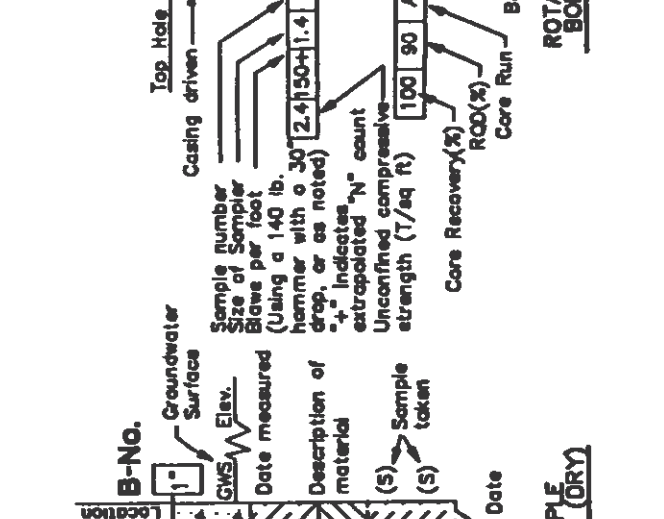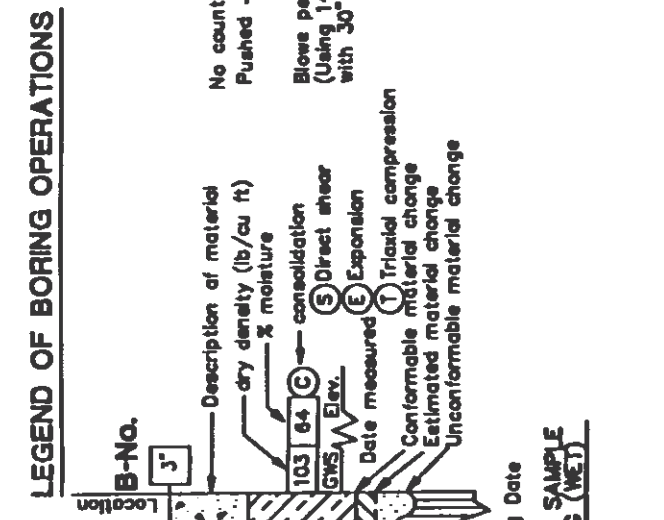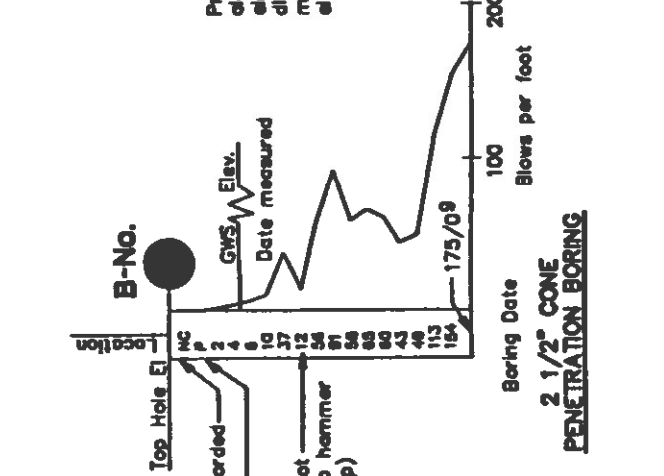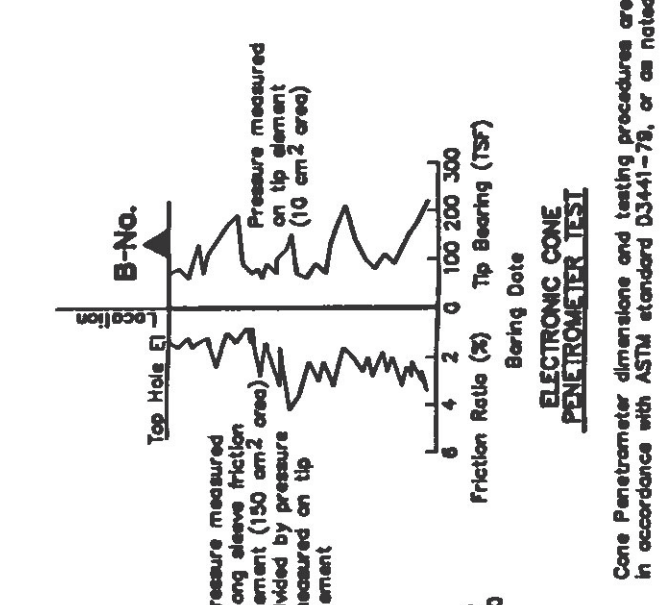


LEGEND OF EARTH MATERIALS

GRAVEL	CLAYEY SILT
SAND	PEAT and/or ORGANIC MATERIAL
SILT	NUCLEOUS ROCK
CLAY	SEDIMENTARY ROCK
SANDY CLAY or CLAYEY SAND	IGNEOUS METAMORPHIC ROCK
SILT SAND or SILTY SAND	CLAYEY SAND or SANDY CLAY
SILTY CLAY	

CONSISTENCY CLASSIFICATION FOR SOILS

Penetration Index (Blows / FT)	Cohesive	
	Granular	
0-4	Very loose	Very soft
5-9	Slightly loose	Soft
10-14	Loose	Medium stiff
15-19	Medium loose	Stiff
20-24	Medium dense	Very stiff
25-29	Dense	Very hard
30-34	Very dense	
35-39		
>70		

NOTE: Classification of earth material as shown on this sheet is based upon field inspection and is not to be construed to imply mechanical analysis.

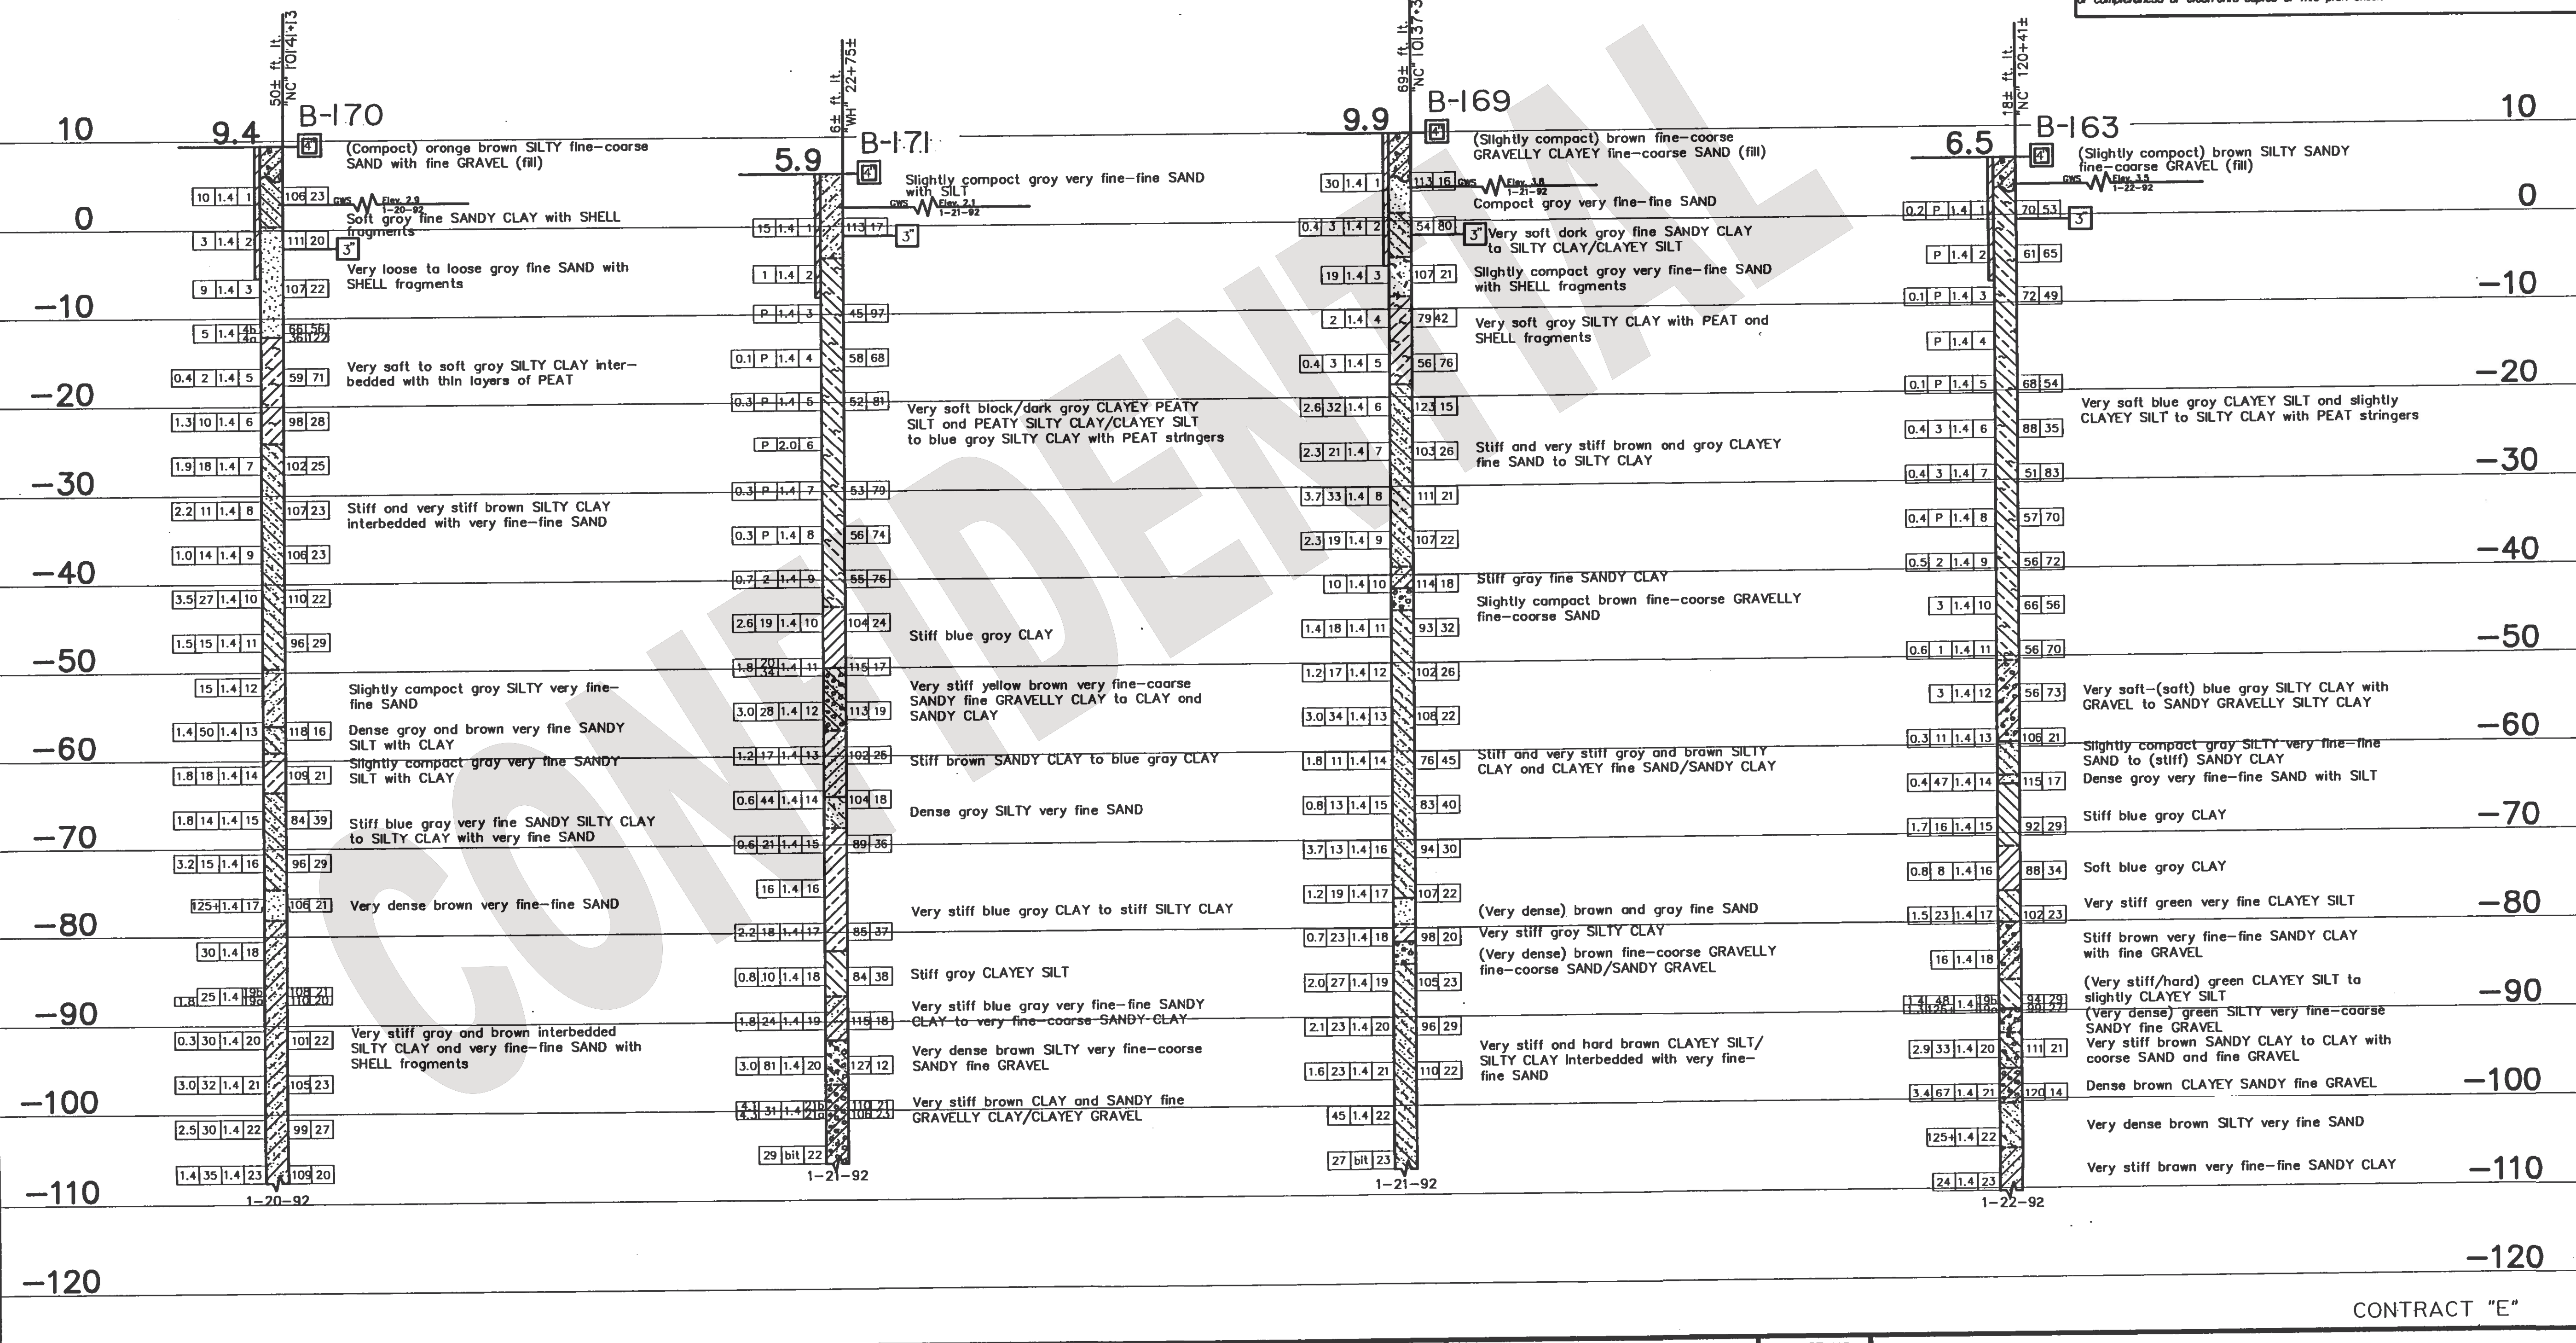

ENGINEERING GEOLOGY BRANCH - TRANSPORTATION LABORATORY

DRAWN BY: M.D.R. 1/92
 CHECKED BY: T.A.K. & W.E.N. 2/92

Prepared for the
State of CALIFORNIA
 DEPARTMENT OF TRANSPORTATION

DIVISION OF STRUCTURES
 STRUCTURE DESIGN

BRIDGE NO. 33-612 E
 POST MILE

PORT OF OAKLAND CONN. VIADUCT

LOG OF TEST BORINGS 15 OF 20

DISREGARD PRINTS BEARING EARLIER REVISION DATES

REVISION DATES (PRELIMINARY STAGE ONLY)

SHEET 82 OF 101



DIST.	COUNTY	ROUTE	POST MILES TOTAL PROJECT	SHEET NO.	TOTAL SHEETS
04	Alc	880	34.3/35.0	903	940

H. R. Taber
GEOTECHNICAL PROFESSIONAL
 No. 817
 EXP. 12-31-92
 GEOTECHNICAL STATE OF CALIFORNIA

3-13-95
 PLANS APPROVAL DATE


TABER CONSULTANTS JOB No. 1P1/388/72.019
 536 Galveston Street Field Study By: T. A. Krause & W. E. Nichols
 West Sacramento, CA 95691

The State of California or its officers or agents shall not be responsible for the accuracy or completeness of electronic copies of this plan sheet.

FOR PLAN VIEW, SEE SHEET 1 OF 20

AS BUILT

CORRECTIONS BY S. WHIPPLE
 CONTRACT NO. 04-192244
 DATE 01-28-98
 NO AS-BUILT CHANGES M.F. 4-16-78

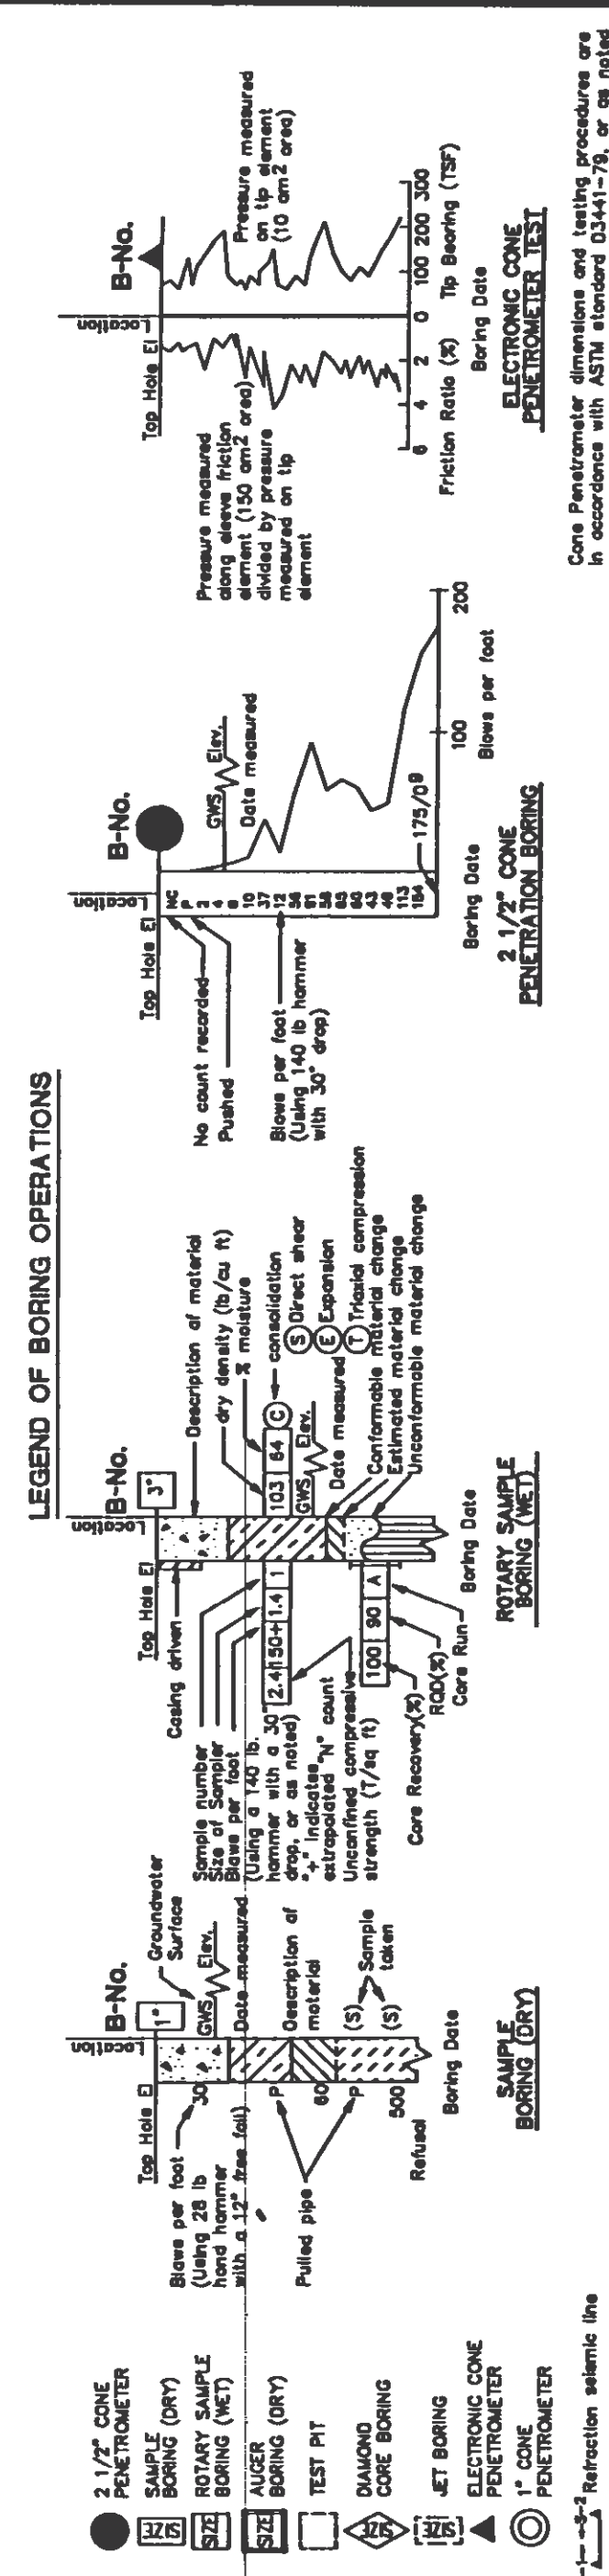


LEGEND OF EARTH MATERIALS

GRAVEL	CLAYEY SILT
SAND	PEAT and/or ORGANIC MATTER
SILT	FILL MATERIAL
CLAY	INCORPORATED ROCK
SANDY CLAY or CLAYEY SAND	SEDIMENTARY ROCK
SANDY SILT or SILTY SAND	METAMORPHIC ROCK
SILTY CLAY	

CONSISTENCY CLASSIFICATION FOR SOILS

According to the Standard Penetration Test	
Penetration (Blows / Ft.)	Consistency
0-5	Very loose
5-10	Loose
10-15	Slightly compact
15-20	Compact
20-30	Very compact
30-50	Very stiff
50-70	Very hard

NOTE: Classification of earth material as shown on this sheet is based upon field inspection and is not to be construed to imply mechanical analysis.

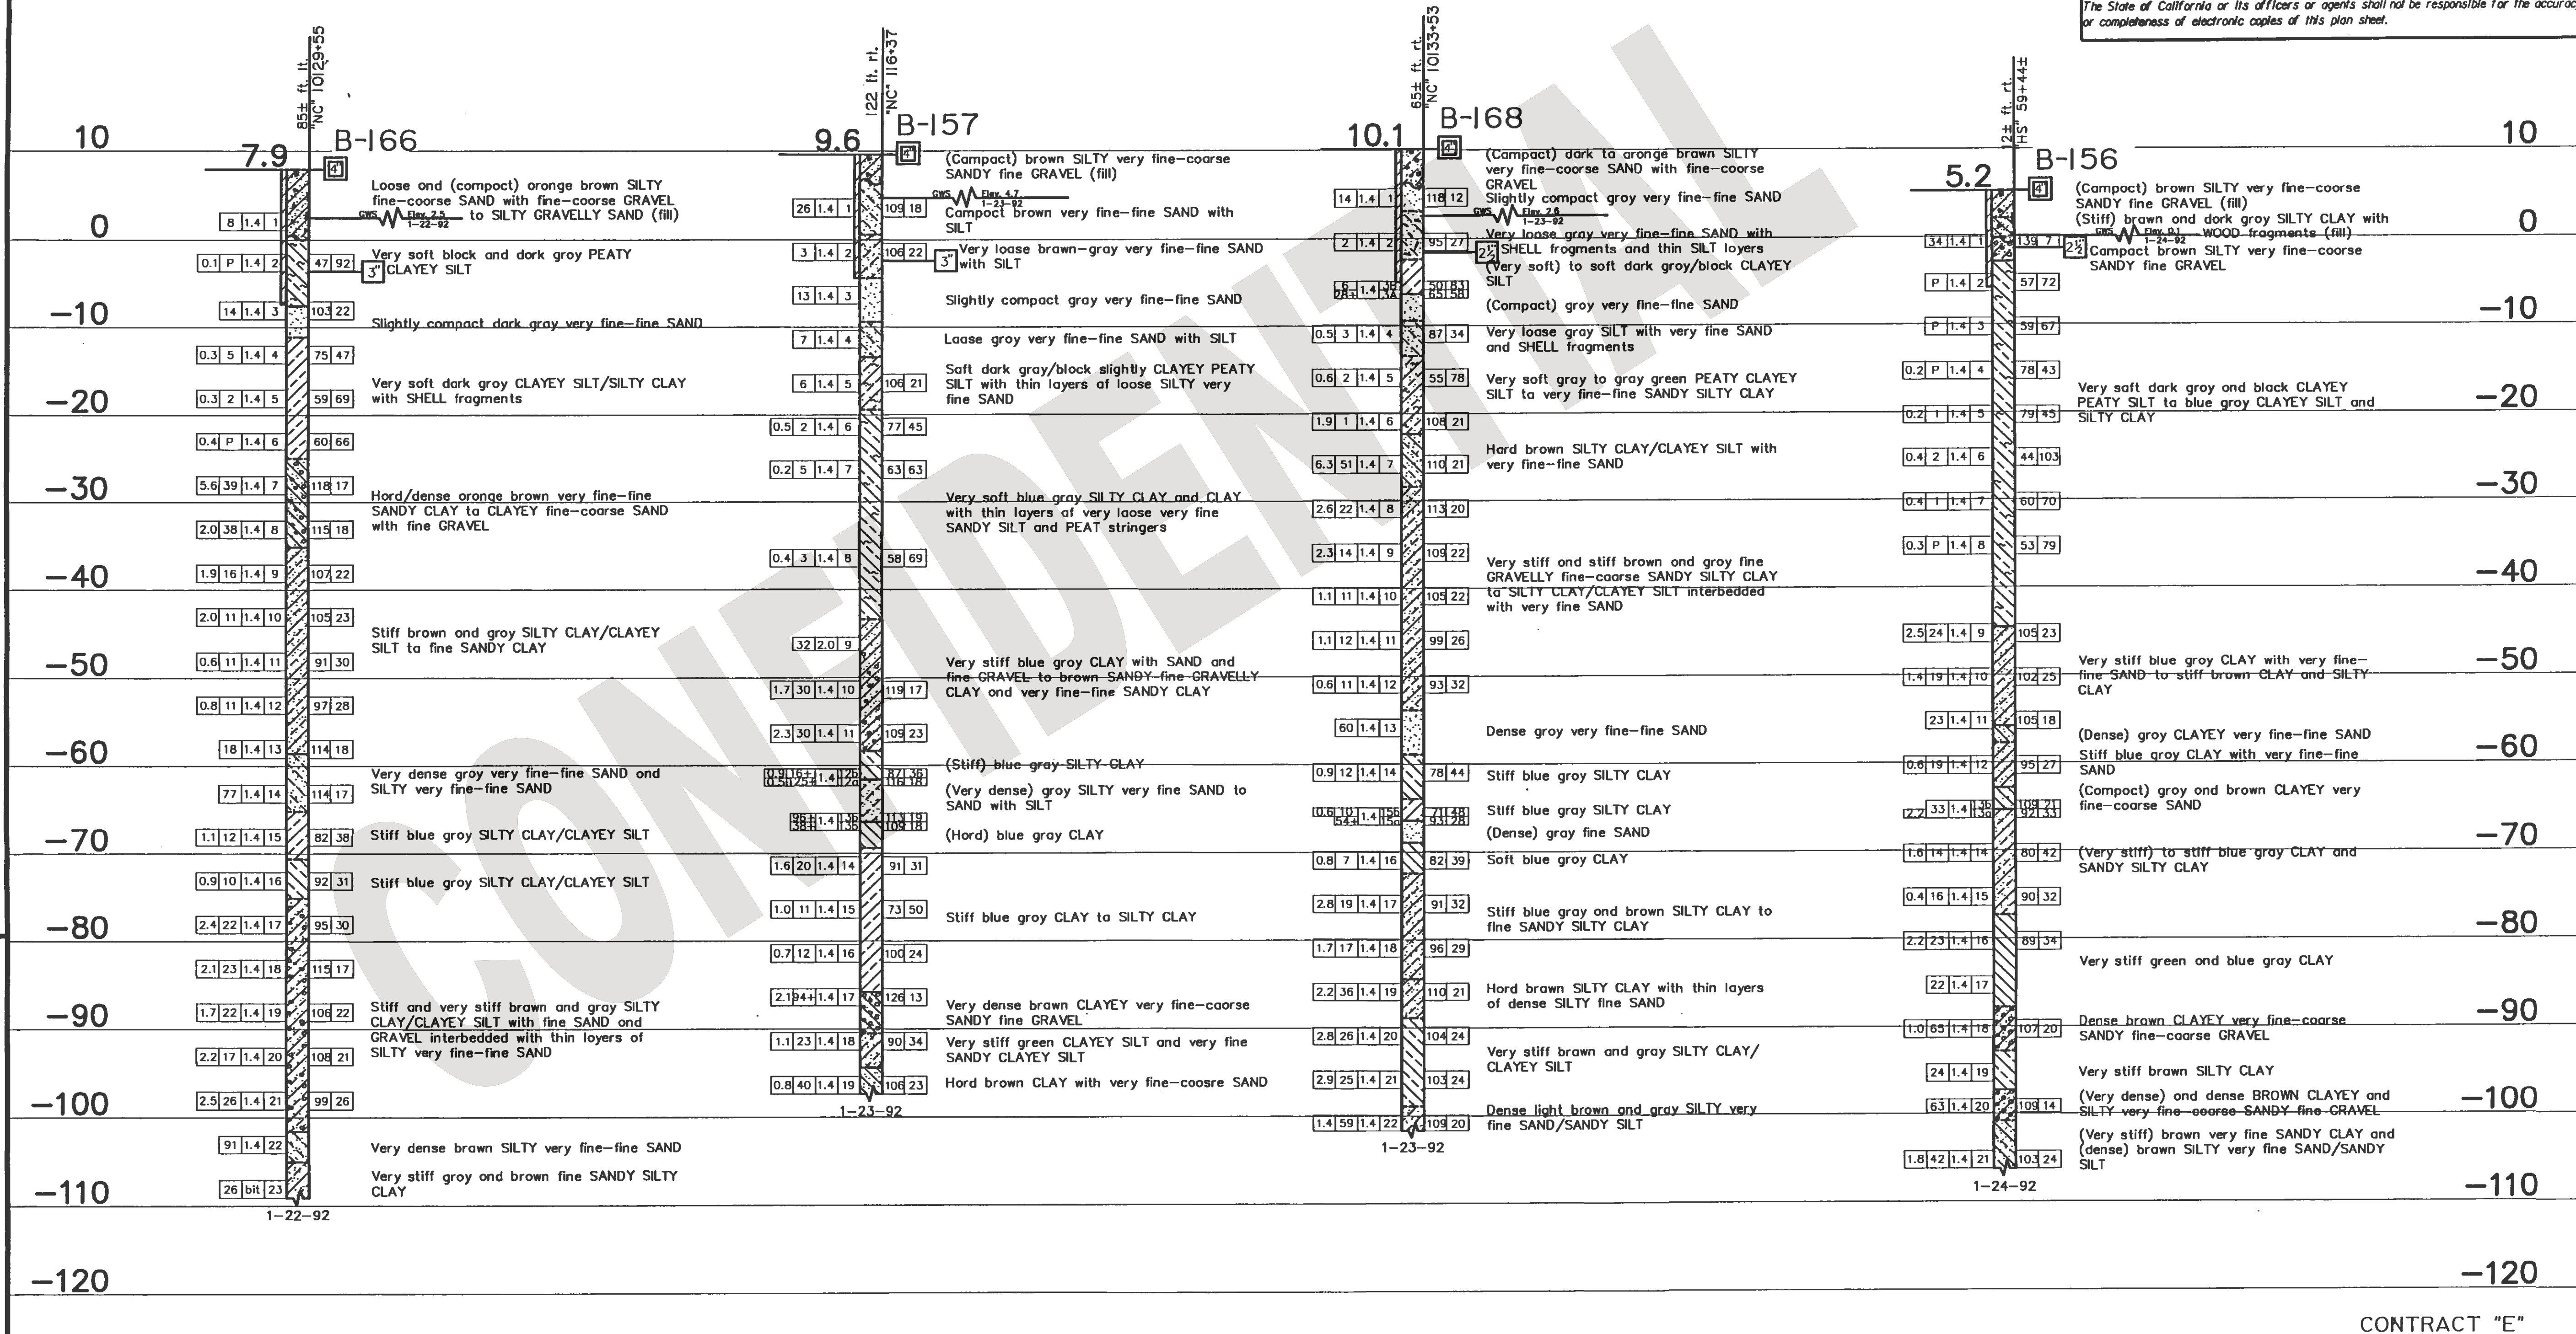

ENGINEERING GEOLOGY BRANCH - TRANSPORTATION LABORATORY		Prepared for the State of CALIFORNIA DEPARTMENT OF TRANSPORTATION		DIVISION OF STRUCTURES STRUCTURE DESIGN		BRIDGE NO. 33-612 E		PORT OF OAKLAND CONN. VIADUCT	
DRAWN BY	M.D.R. 1/92	PROJECT ENGINEER				POST MILE		LOG OF TEST BORINGS 16 OF 20	
CHECKED BY	T.A.K. & W.E.N. 2/92								

The State of California or its officers or agents shall not be responsible for the accuracy or completeness of electronic copies of this plan sheet.

DIST.	COUNTY	ROUTE	POST MILES TOTAL PROJECT	SHEET NO.	TOTAL SHEETS
04	Ala	880	34.3/35.0	904	940

FOR PLAN VIEW, SEE SHEET 1 OF 20

AS BUILT



CORRECTIONS BY S. WHIPPLE
 CONTRACT NO. 04192244
 DATE 01-28-98
 NO AS-BUILT CHANGES. M.F. 4-16-98

H. R. Taber
 GEOTECHNICAL PROFESSIONAL
 No. 817
 EXP. 12-31-92
 PLANS APPROVAL DATE

TABER CONSULTANTS
 536 Galveston Street
 West Sacramento, CA 95691

Field Study By: T. A. Krause & W. E. Nichols

Job No. 1P1/388/72.019

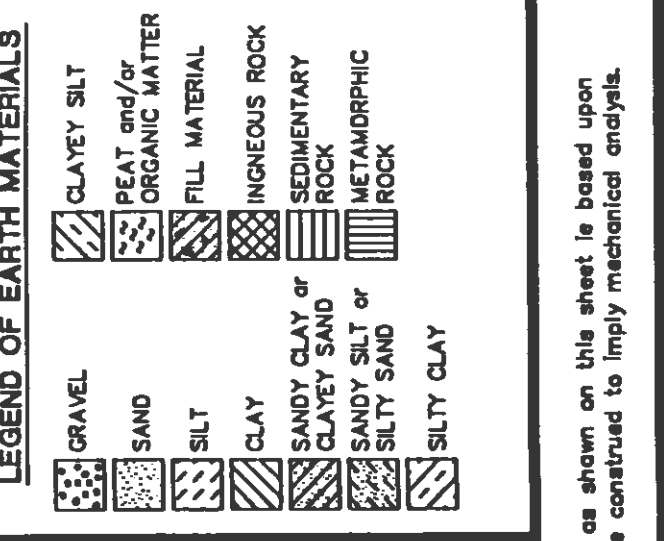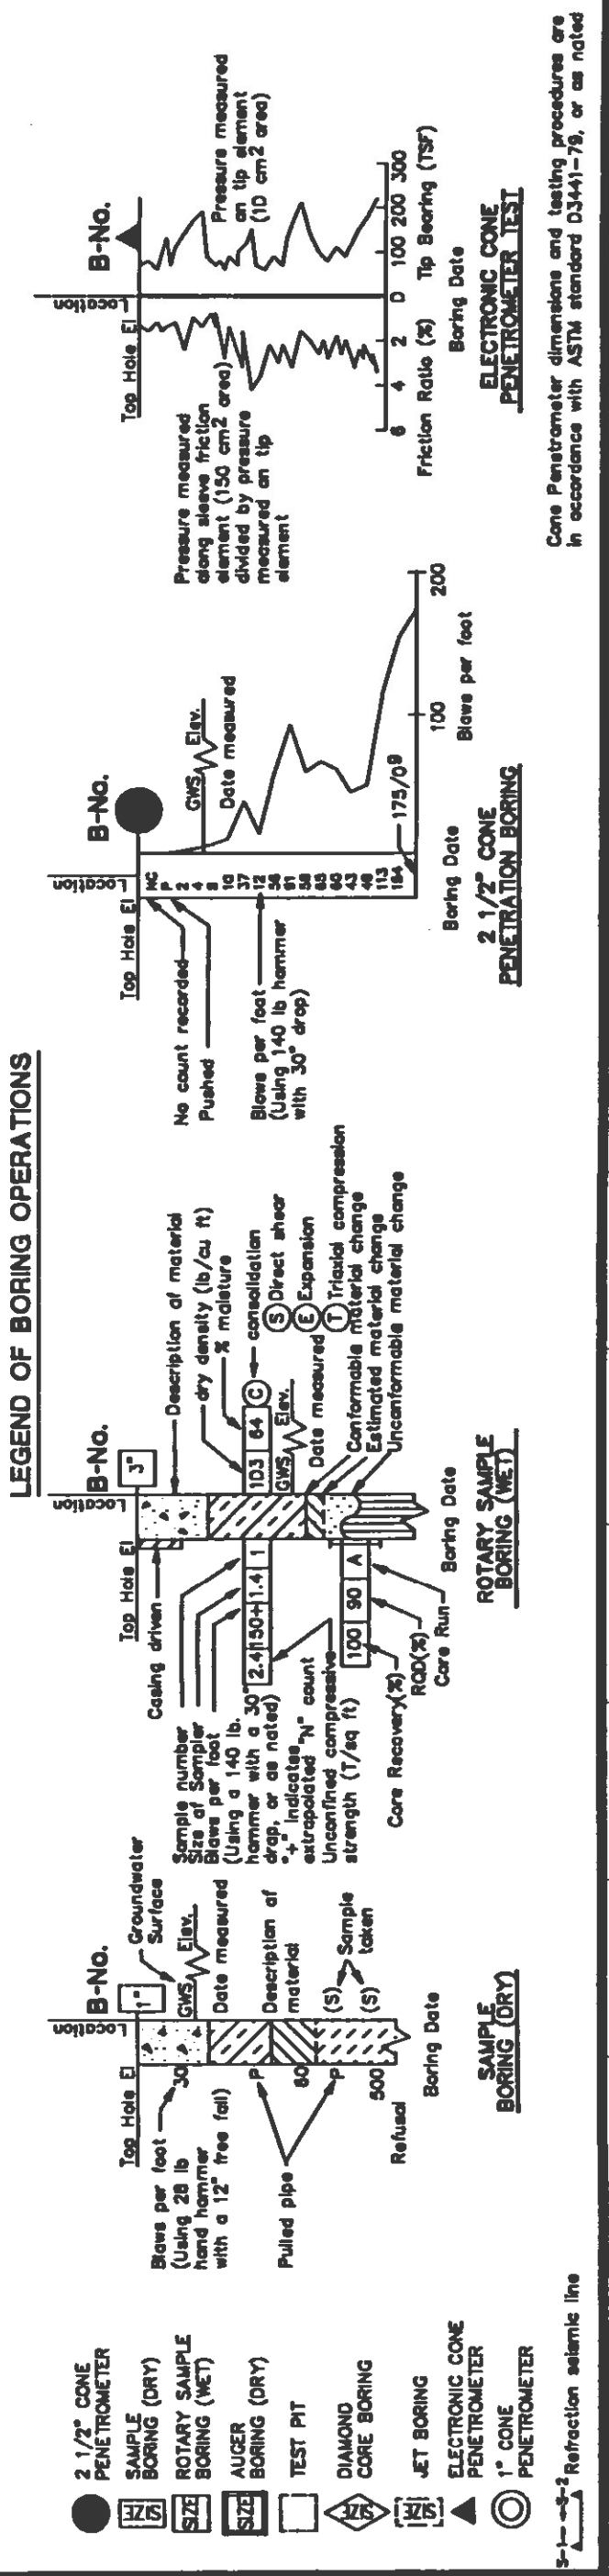

CONSISTENCY CLASSIFICATION FOR SOILS

According to the Standard Penetration Test

Penetration (Blows / Ft)	Consistency
0-4	Very loose
5-9	Loose
10-19	Slightly compact
20-29	Compact
30-59	Dense
>60	Very dense

NOTE: Classification of earth material as shown on this sheet is based upon field inspection and is not to be construed to imply mechanical analysis.

Depth (ft)	B-167	B-153	B-165	B-151
0	(Compact) orange brown SILTY very fine-coarse SAND with fine-coarse GRAVEL (fill) Slightly compact brown to gray SILTY very fine-fine SAND	AC to 0.5 ft. then (compact-dense) brown SILTY SANDY fine-coarse GRAVEL (fill)	(Compact) orange brown SILTY fine-coarse GRAVELLY SAND (fill)	AC to 0.5 ft then (compact-dense) brown SILTY SANDY fine-coarse GRAVEL (fill)
1-10	Very loose gray brown interbedded SILT and very fine-fine SAND layers	Loose slightly compact gray CLAYEY SILTY SANDY fine GRAVEL	Very soft dark gray/black SILTY CLAY/CLAYEY SILT with SHELL fragments to PEATY CLAYEY SILT interbedded with thin layers of SILT and fine SAND	Semicompact gray SILTY very fine-fine SAND with SHELL fragments
10-20	Soft dark gray CLAYEY SILT (Slightly compact) dark gray SILTY fine SAND			
20-30	Very soft gray CLAYEY SILT and PEATY CLAYEY SILT with SHELL fragments to very fine-fine SANDY CLAYEY SILT/SILTY CLAY	Very soft blue gray CLAYEY SILT	Loose gray SILT with SHELL fragments	Very soft blue gray CLAYEY SILT and slightly CLAYEY SILT with PEAT stringers to SILTY CLAY
30-40	Stiff and very stiff brown fine SANDY CLAY to SILTY CLAY with fine SAND interbedded with thin layers of slightly compact/compact CLAYEY very fine-coarse SAND with fine GRAVEL	Loose dark gray SILTY very fine SAND	Very soft blue gray and brown PEATY CLAY to fine SANDY CLAY	
40-50	Soft brown SILTY CLAY/CLAYEY SILT (Slightly compact) brown SILTY very fine-fine SAND	Very soft blue gray SILTY CLAY with PEAT stringers Slightly compact (dark gray SILTY very fine-fine SAND)		
50-60	Stiff and very stiff brown and gray CLAYEY SILT/SILTY CLAY	Very soft blue gray SILTY CLAY with PEAT	Stiff and very stiff yellow brown and blue gray fine SANDY CLAY to SILTY CLAY/CLAYEY SILT	
60-70	Compact blue gray green SILTY fine SAND (Hard) blue gray CLAY		(Dense) gray fine SAND (Stiff) blue-gray SILTY CLAY/CLAYEY SILT	Dense blue-gray CLAYEY very fine-fine SAND and CLAYEY SANDY fine GRAVEL
70-80	Very dense gray very fine-fine SAND	Stiff dark gray CLAY to blue gray very fine-fine SANDY CLAY	Hard blue-gray CLAYEY SILT with fine SAND	Very dense blue gray SILTY very fine-fine SAND with thin layers of SANDY SILT
80-90	Stiff blue gray CLAY with very fine SAND	(Compact) blue gray CLAYEY very fine-fine SAND with coarse SAND Stiff blue gray CLAY		
90-100	Hard/dense brown fine SANDY CLAY to CLAYEY fine-coarse SAND with fine-coarse GRAVEL	Soft gray CLAY to very fine-fine SANDY CLAY with coarse SAND	Very stiff-locally stiff blue-gray and brown CLAY and SILTY CLAY/CLAYEY SILT interbedded with very fine-fine SAND	Stiff and soft blue gray CLAYEY SILT to SILTY CLAY and CLAY
100-110	Stiff brown and gray fine-coarse SANDY CLAY to CLAYEY SILT	Dense yellow brown CLAYEY very fine-coarse SANDY fine GRAVEL		
110-120	Very dense gray SILTY very fine-fine SAND	Very stiff yellow brown CLAYEY SILT and slightly CLAYEY SILT	Dense blue gray very fine-fine SANDY SILT/SILTY SAND	Very stiff and stiff blue gray very fine-fine SANDY CLAY and SANDY CLAYEY SILT
120-130	Stiff and very stiff brown and gray CLAY with fine SAND to fine SANDY CLAY	(Dense) to very dense gray and brown CLAYEY very fine-coarse SANDY fine GRAVEL	Stiff brown CLAYEY SILT/SILTY CLAY	Very dense blue gray CLAYEY very fine-coarse SANDY fine GRAVEL and fine-coarse GRAVEL
130-140		Hard light brown very fine-fine SANDY CLAYEY SILT		Very stiff blue gray very fine-coarse SANDY SILTY CLAY
140-150		Dense brown CLAYEY very fine-coarse SANDY fine GRAVEL (Very stiff) brown SILTY CLAY		
150-160		Very dense brown CLAYEY fine GRAVELLY very fine-coarse SAND with thin layers of hard SILTY CLAY		
160-170		Very stiff brown SILTY CLAY		

ENGINEERING GEOLOGY BRANCH - TRANSPORTATION LABORATORY

DRAWN BY M.D.R. 1/92
 CHECKED BY T.A.K. & W.E.N. 2/92

Prepared for the
State of CALIFORNIA
 DEPARTMENT OF TRANSPORTATION

DIVISION OF STRUCTURES
STRUCTURE DESIGN

BRIDGE NO.
 POST MILE

PROJECT ENGINEER

LOG OF TEST BORINGS 17 OF 20

CONTRACT "E"

DISREGARD PRINTS BEARING EARLIER REVISION DATES

REVISION DATES (PRELIMINARY STAGE ONLY)

SHEET 84 OF 101

ORIGINAL SCALE IN INCHES FOR REDUCED PLANS



CU 04 EA 192231

The State of California or its officers or agents shall not be responsible for the accuracy or completeness of electronic copies of this plan sheet.

DIST.	COUNTY	ROUTE	POST MILES TOTAL PROJECT	SHEET NO.	TOTAL SHEETS
04	Alc	880	34.3/35.0	905	940

H. R. Taber
GEOTECHNICAL PROFESSIONAL
 No. 817
 EXP. 12-31-92
 3-13-95
 PLANS APPROVAL DATE

TABER CONSULTANTS
 536 Galveston Street
 West Sacramento, CA 95691








JOB No. 1P1/388/72.019
 Field Study By: *T. A. Krause & W. E. Nichols*



FOR PLAN VIEW, SEE SHEET 1 OF 20

AS BUILT

CORRECTIONS BY S. WHIPPLE
 CONTRACT NO. 04192244
 DATE 01-28-98
 NO AS-BUILT CHANGES M.F. 4-16-78

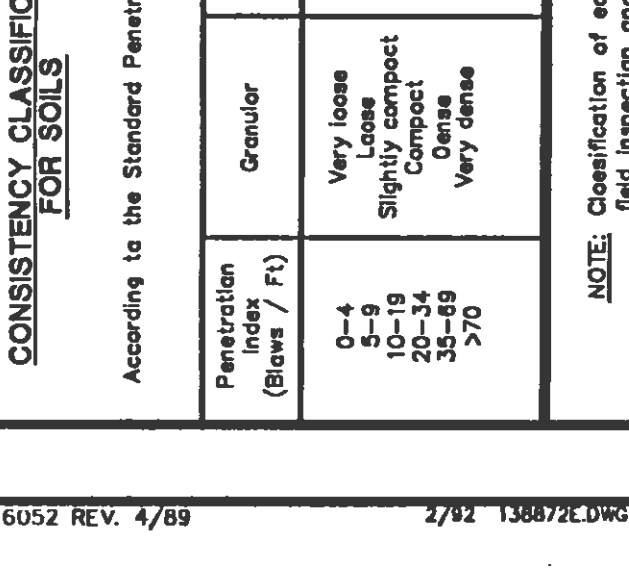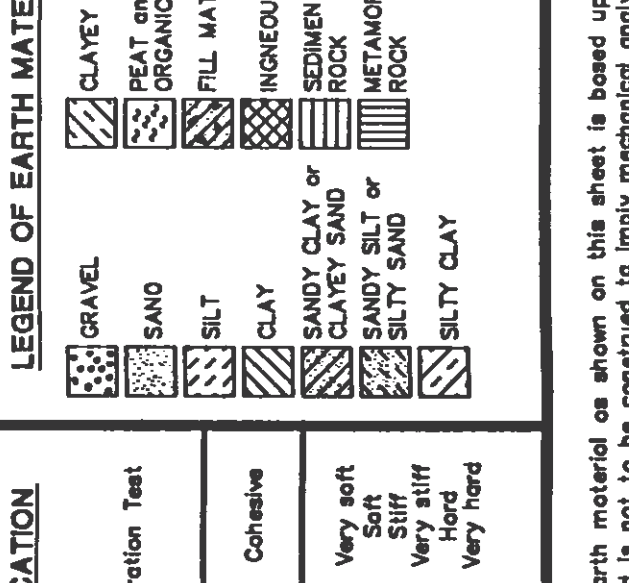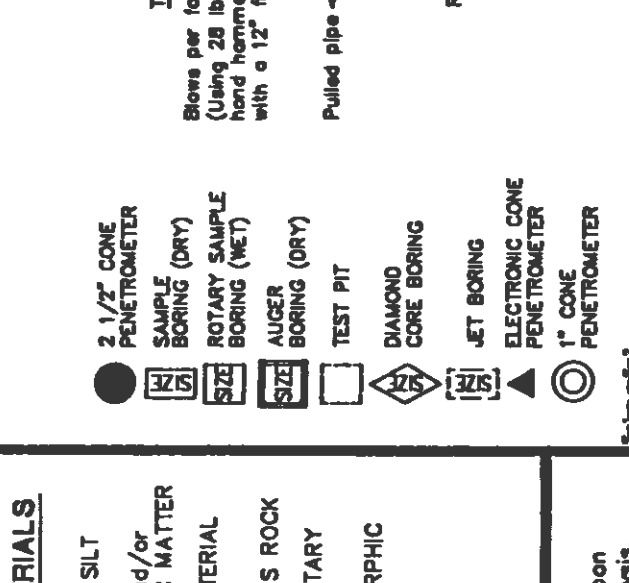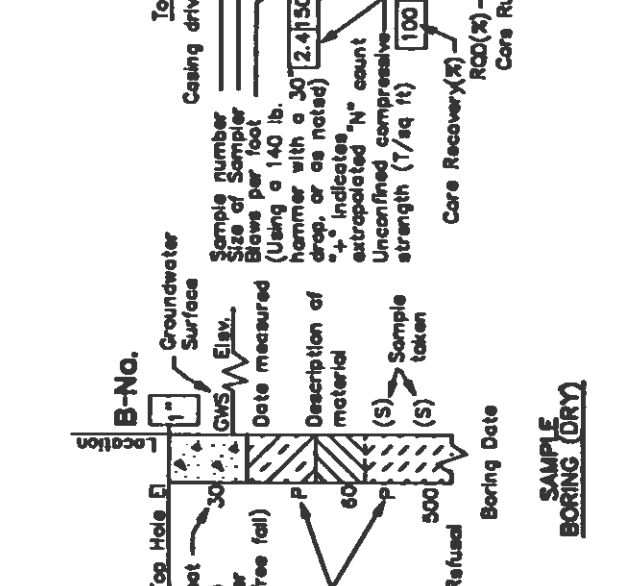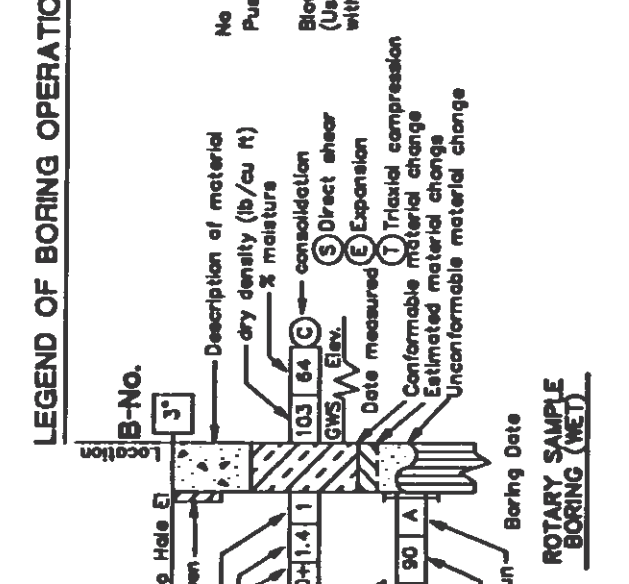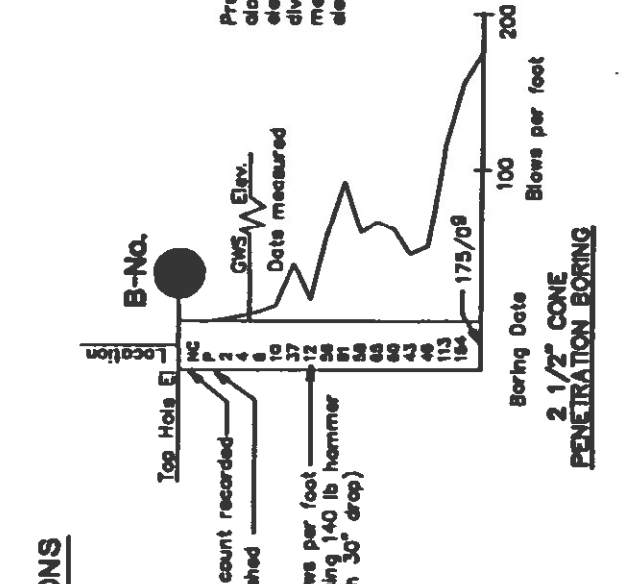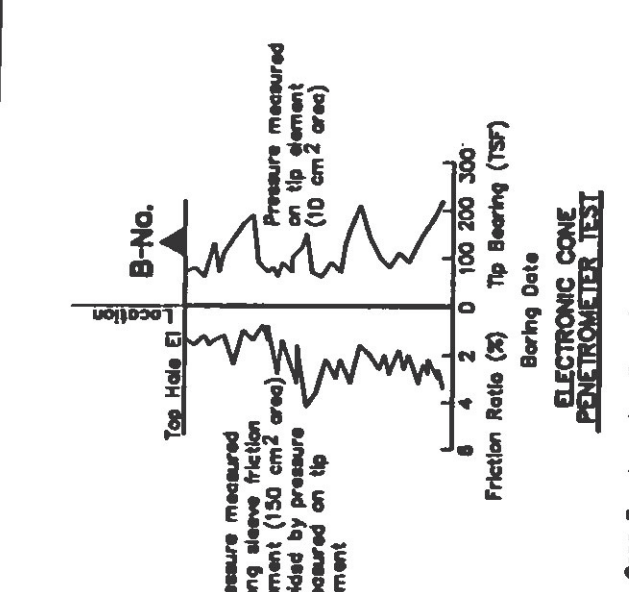

Depth (ft)	Bore B-162	Bore B-152	Bore B-161	Bore B-154
0	5.3 (Loose) brown very fine-fine SAND	8.6 (Compact)-semicompact light and dark brown SILTY very fine-coarse SANDY GRAVEL (fill)	5.2 Loose gray very fine-medium SAND	8.1 Compact light and dark brown SILTY and CLAYEY very fine-coarse SANDY GRAVEL and CONCRETE blocks (fill)
10	Dense gray very fine-medium SAND	Dense gray very fine-medium SAND	Slightly compact gray very fine-medium SAND	Dense gray fine-medium SAND with shell fragments
20	Very soft and soft black to blue gray PEATY SILTY CLAY to SILTY CLAY	Very soft blue gray CLAYEY SILT and SILTY CLAY with PEAT stringers and very fine SANDY CLAYEY SILT	Dense gray fine-medium SAND with shell fragments	Dense gray fine-medium SAND with shell fragments
30	Very stiff blue gray to yellow brown fine SANDY CLAY to SILTY CLAY/CLAYEY SILT with shell fragments	Very loose dark gray SILTY very fine-fine SAND	Very soft to soft blue gray SILTY CLAY with shell fragments to CLAY with PEAT	Very soft dark gray and black CLAYEY SILT with PEAT stringers to SILTY CLAY
40	Very hard/very dense yellow brown fine-coarse GRAVELLY SANDY CLAY/CLAYEY GRAVELLY SAND	Very soft blue gray SILTY CLAY with scattered PEAT stringers	Very soft to soft blue gray SILTY CLAY with shell fragments to CLAY with PEAT	Very soft dark gray and black CLAYEY SILT with PEAT stringers to SILTY CLAY
50	Very stiff blue gray to yellow brown fine SANDY CLAY to SILTY CLAY/CLAYEY SILT with shell fragments	Hard and very stiff blue gray very fine-fine SANDY CLAY and CLAY with SAND	Stiff blue gray SILTY CLAY	Stiff blue gray and brown very fine-fine SANDY CLAY and CLAY
60	Very dense blue gray SILTY fine-coarse SAND/SANDY SILT with fine GRAVEL and CLAY stringers	Very dense blue gray very fine-fine SAND with SILT	Stiff blue gray SILTY CLAY	Stiff blue gray and brown very fine-fine SANDY CLAY and CLAY
70	Dense blue gray very fine-fine SANDY SILTY SAND	Very dense yellow brown CLAYEY and SILTY very fine SAND with small layers of SILTY SANDY GRAVEL	(Slightly compact) gray fine SAND	Stiff blue gray and brown very fine-fine SANDY CLAY and CLAY
80	Slightly compact blue gray fine SANDY SILT	Hard and very stiff brown very fine-coarse SANDY CLAY to very fine-fine SANDY CLAY	Stiff blue gray and green SILTY CLAY, with SAND and CLAY	Stiff blue gray and brown very fine-fine SANDY CLAY and CLAY
90	Very dense blue gray SILTY fine-coarse SAND/SANDY SILT with fine GRAVEL and CLAY stringers	Very stiff blue gray very fine-coarse SANDY CLAY and CLAY	Stiff blue gray and green SILTY CLAY, with SAND and CLAY	Stiff blue gray and brown very fine-fine SANDY CLAY and CLAY
100	Very dense blue gray SILTY fine-coarse SAND/SANDY SILT with fine GRAVEL and CLAY stringers	Very dense yellow brown CLAYEY and SILTY very fine SAND with small layers of SILTY SANDY GRAVEL	Stiff blue gray and green SILTY CLAY, with SAND and CLAY	Stiff blue gray and brown very fine-fine SANDY CLAY and CLAY
110	Very dense blue gray SILTY fine-coarse SAND/SANDY SILT with fine GRAVEL and CLAY stringers	Hard and very stiff brown very fine-coarse SANDY CLAY to very fine-fine SANDY CLAY	Stiff blue gray and green SILTY CLAY, with SAND and CLAY	Stiff blue gray and brown very fine-fine SANDY CLAY and CLAY
120	Very dense blue gray SILTY fine-coarse SAND/SANDY SILT with fine GRAVEL and CLAY stringers	Hard and very stiff brown very fine-coarse SANDY CLAY to very fine-fine SANDY CLAY	Stiff blue gray and green SILTY CLAY, with SAND and CLAY	Stiff blue gray and brown very fine-fine SANDY CLAY and CLAY
130	Very dense blue gray SILTY fine-coarse SAND/SANDY SILT with fine GRAVEL and CLAY stringers	Hard and very stiff brown very fine-coarse SANDY CLAY to very fine-fine SANDY CLAY	Stiff blue gray and green SILTY CLAY, with SAND and CLAY	Stiff blue gray and brown very fine-fine SANDY CLAY and CLAY

LEGEND OF BORING OPERATIONS

2 1/2" CONE PENETROMETER
 SAMPLE BORING (DRY)
 SAMPLE BORING (WET)
 AUGER BORING (DRY)
 TEST PIT
 DIAMOND CORE BORING
 LET BORING
 ELECTRONIC CONE PENETROMETER
 1" CONE PENETROMETER

LEGEND OF EARTH MATERIALS

GRAVEL
 SAND
 SILT
 CLAY
 SANDY CLAY or CLAYEY SAND
 SANDY SILT or SILTY SAND
 SILTY CLAY

CONSISTENCY CLASSIFICATION FOR SOILS

According to the Standard Penetration Test:

Cohesive: Very soft, Soft, Stiff, Very stiff, Very hard

Granular: Very loose, Loose, Slightly compact, Compact, Dense, Very dense

NOTE: Classification of earth material as shown on this sheet is based upon field inspection and is not to be construed to imply mechanical analysis.

ENGINEERING GEOLOGY BRANCH - TRANSPORTATION LABORATORY

DRAWN BY: M.D.R. 1/92
 CHECKED BY: T.A.K. & W.E.N. 2/92

PROJECT ENGINEER

Prepared for the
State of CALIFORNIA
 DEPARTMENT OF TRANSPORTATION

DIVISION OF STRUCTURES
 STRUCTURE DESIGN

BRIDGE NO. 33-612 E
 POST MILE

PORT OF OAKLAND CONN. VIADUCT

LOG OF TEST BORINGS 18 OF 20

CONTRACT "E"

ORIGINAL SCALE IN INCHES FOR REDUCED PLANS: 0 1 2 3

CU 04 EA 192231

DISREGARD PRINTS BEARING EARLIER REVISION DATES

REVISION DATES (PRELIMINARY STAGE ONLY)

SHEET 85 OF 101

The State of California or its officers or agents shall not be responsible for the accuracy or completeness of electronic copies of this plan sheet.


DIST.	COUNTY	ROUTE	POST MILES TOTAL PROJECT	SHEET NO.	TOTAL SHEETS
04	Alameda	880	34.3/35.0	906	940

AS BUILT
 CORRECTIONS BY S. WHIPPLE
 CONTRACT NO. 04-192244
 DATE 01-28-98
 NO AS-BUILT CHANGES M.F. 4-16-98



TABER CONSULTANTS
 538 Galveston Street
 West Sacramento, CA 95891
 Field Study By: T. A. Krause & W. E. Nichols

FOR PLAN VIEW, SEE SHEET 1 OF 20

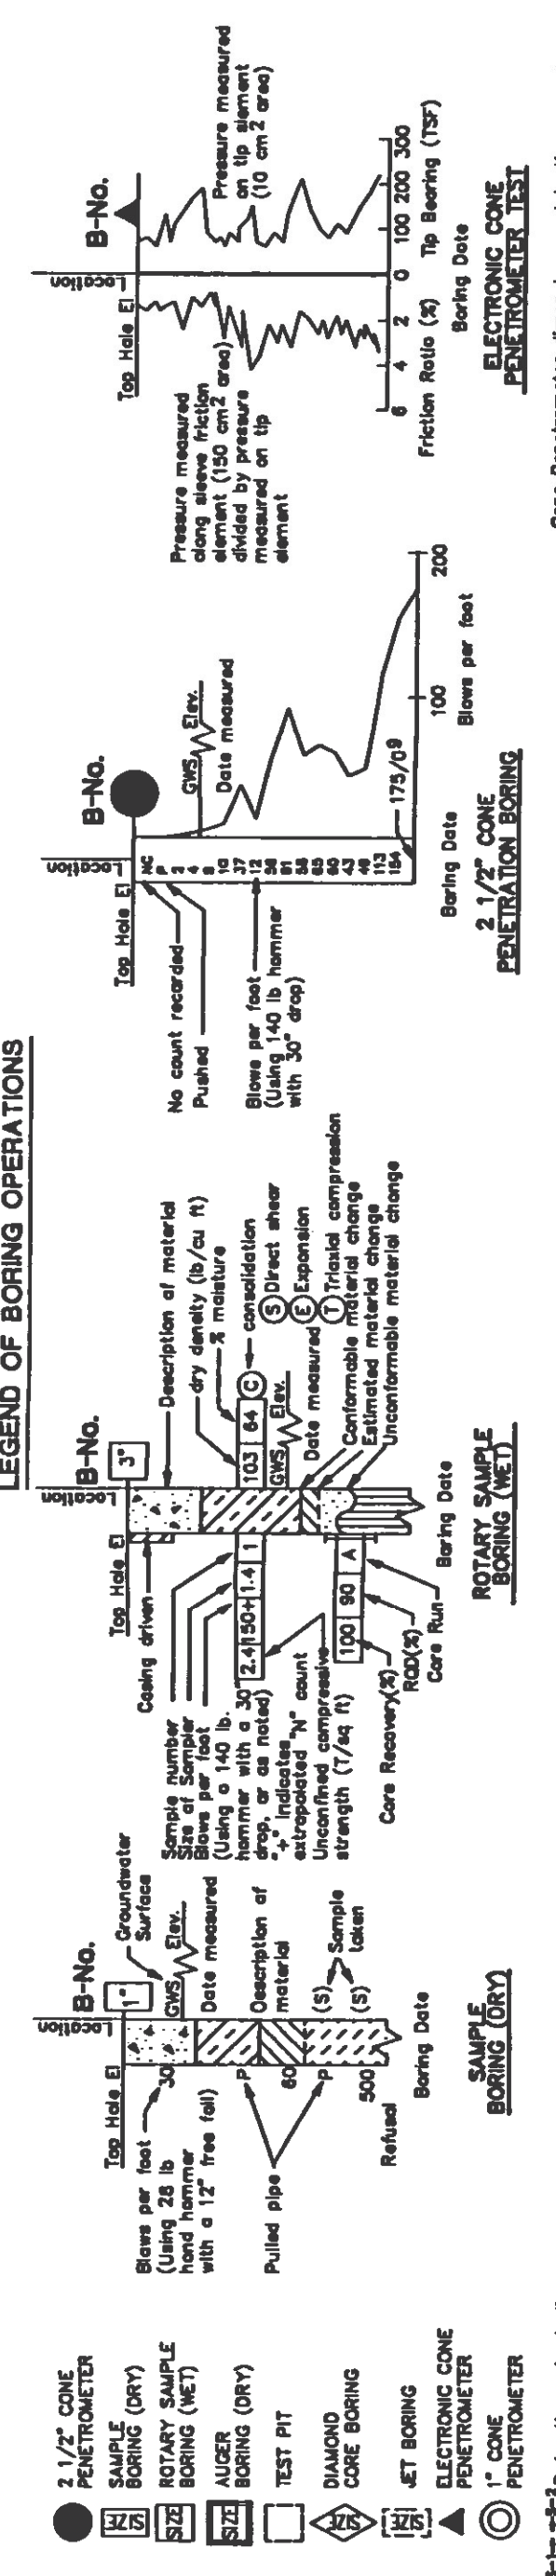


LEGEND OF EARTH MATERIALS

GRAVEL	CLAYEY SILT
SAND	PEAT and/or ORGANIC MATTER
SILT	FILL MATERIAL
CLAY	INCOGENOUS ROCK
SANDY CLAY or CLAYEY SAND	SEDIMENTARY ROCK
SANDY SILT or SILTY SAND	METAMORPHIC ROCK
SILTY CLAY	

CONSISTENCY CLASSIFICATION FOR SOILS

Penetration (Blows / Ft)	Cohesive	
	Granular	Very soft to Very hard
0-4	Very loose	Very soft
5-9	Loose	Soft
10-19	Slightly compact	Stiff
20-29	Compact	Very stiff
30-39	Dense	Very hard
>40	Very dense	



NOTE: Classification of earth material as shown on this sheet is based upon field inspection and is not to be construed to imply mechanical analysis.

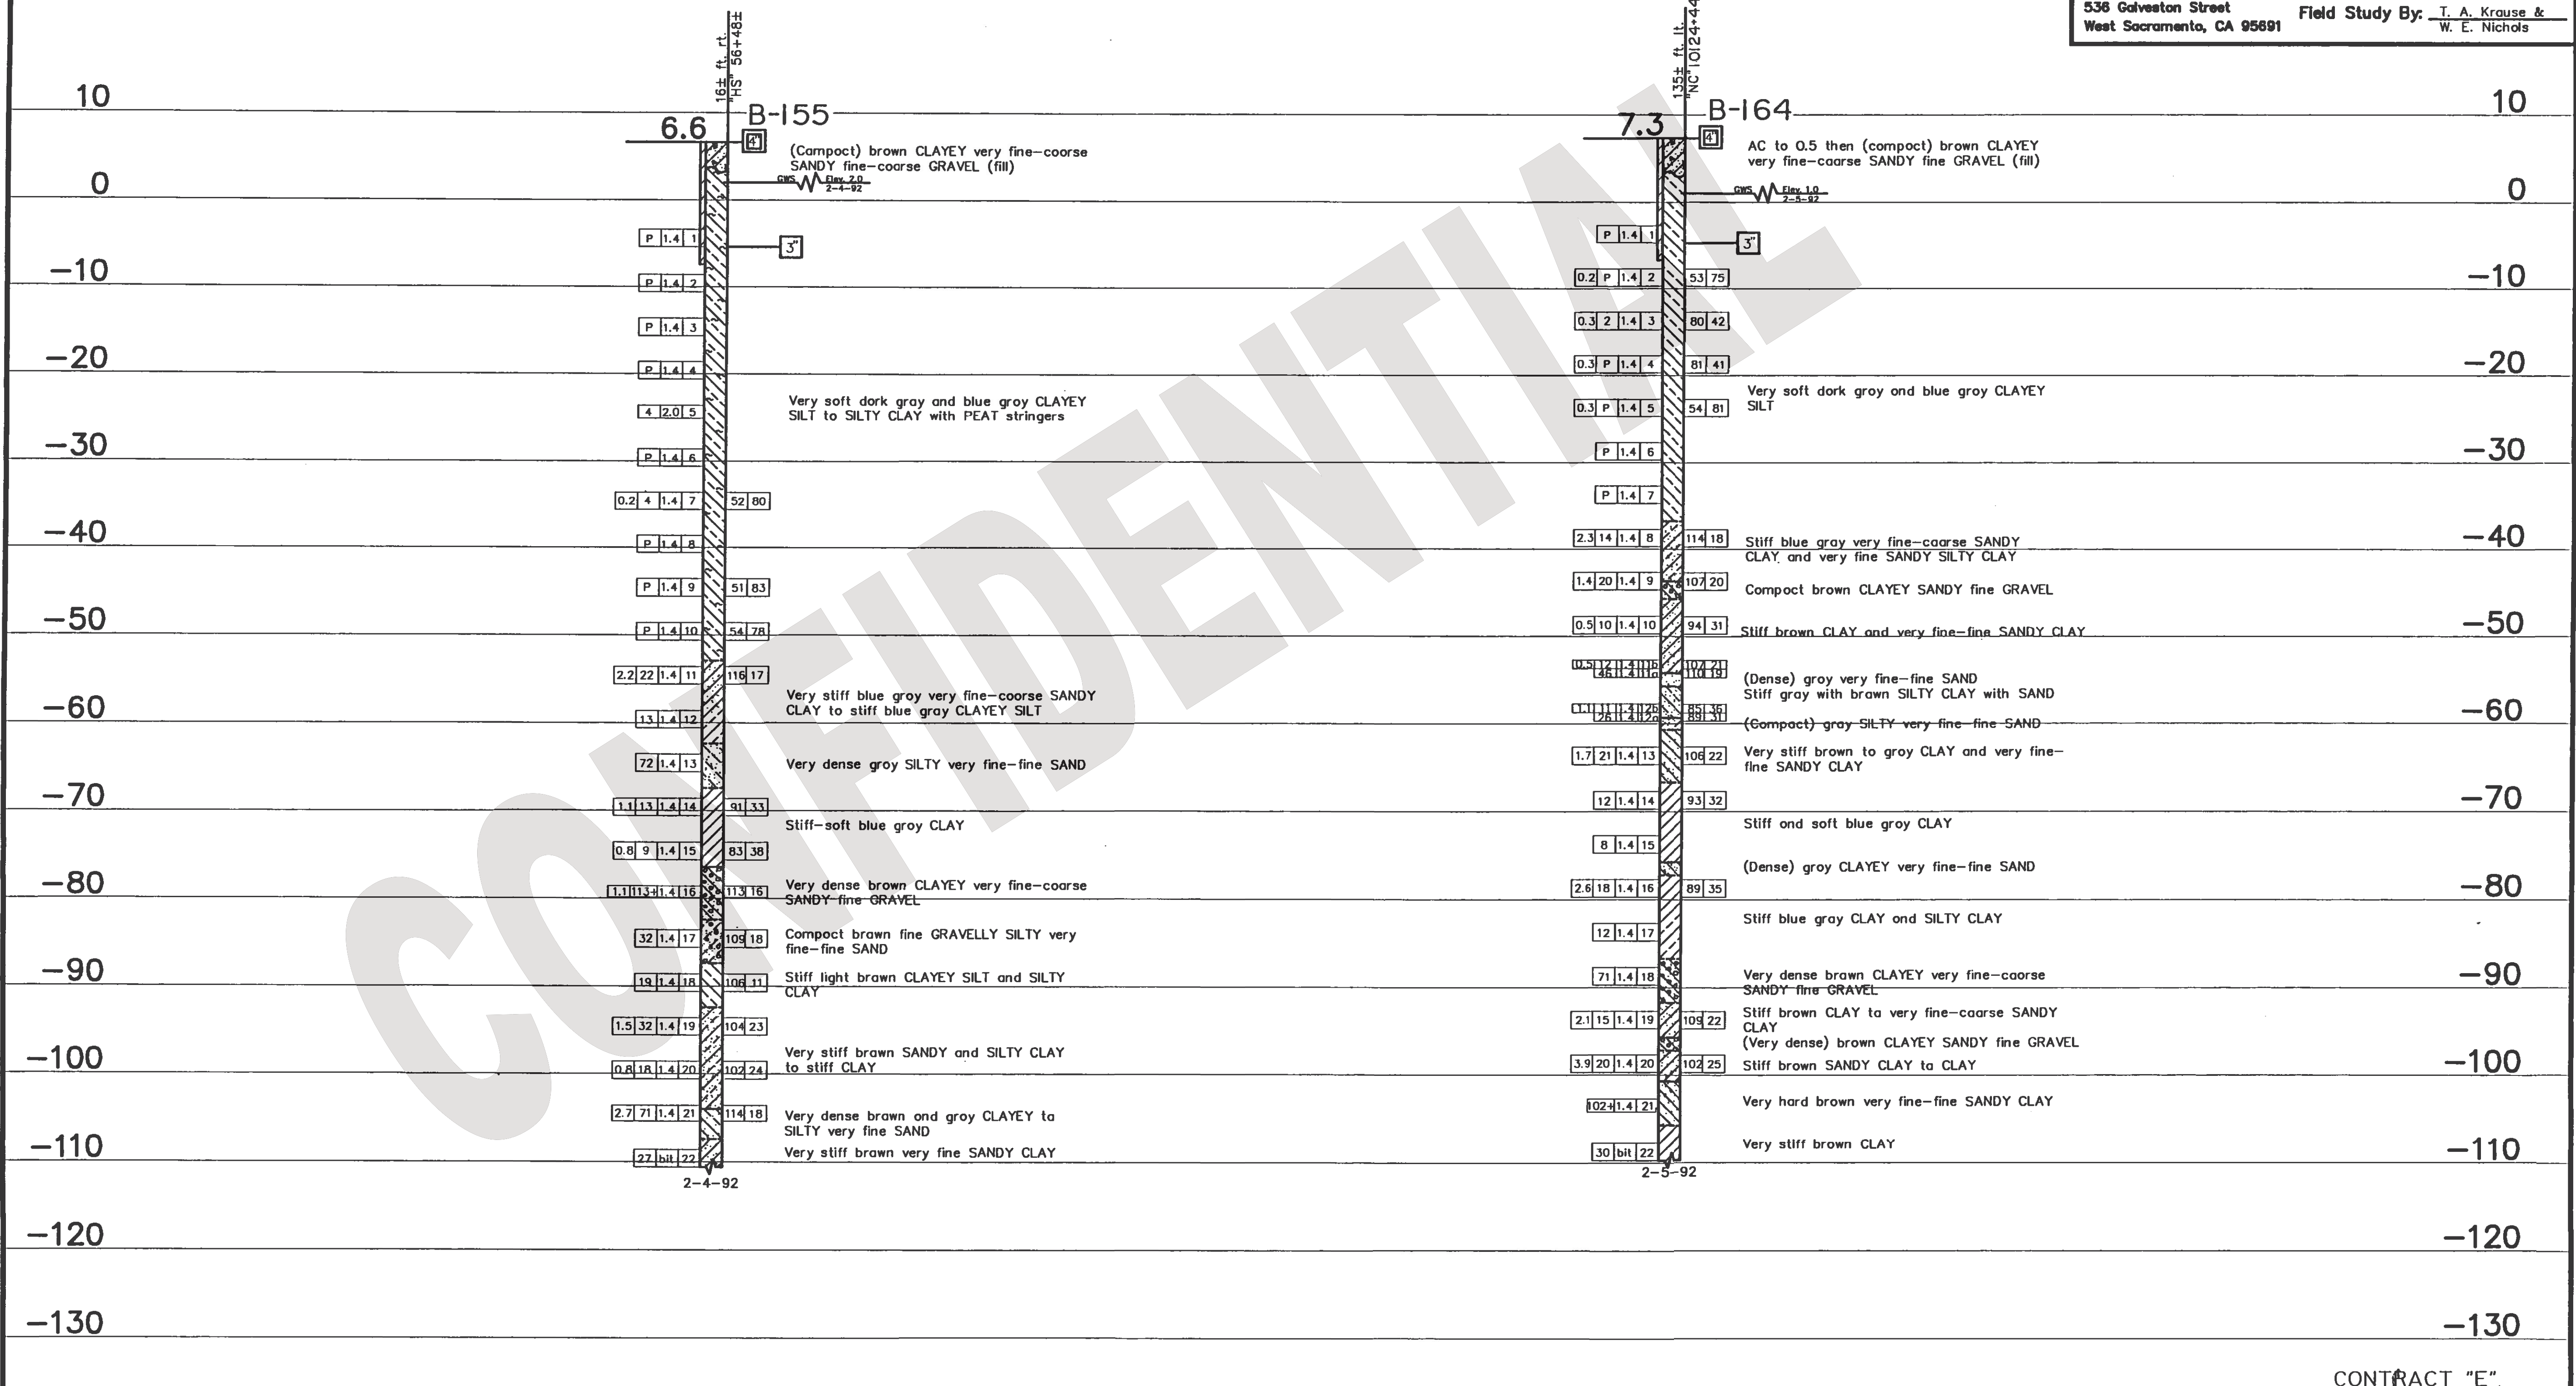

ENGINEERING GEOLOGY BRANCH - TRANSPORTATION LABORATORY		Prepared for the State of CALIFORNIA DEPARTMENT OF TRANSPORTATION		DIVISION OF STRUCTURES STRUCTURE DESIGN		BRIDGE NO. 33-612 E POST MILE		PORT OF OAKLAND CONN. VIADUCT	
DRAWN BY	M.D.R. 1/92	PROJECT ENGINEER						LOG OF TEST BORINGS 19 OF 20	
CHECKED BY	T.A.K. & W.E.N. 2/92								



NOTES:
 THIS ALIGNMENT MAY NOT BE FINAL;
 FOR FINAL ALIGNMENT REFER TO
 FOUNDATION PLANS
 -1.5 INDICATES BOTTOM OF FOOTING
 ELEVATION

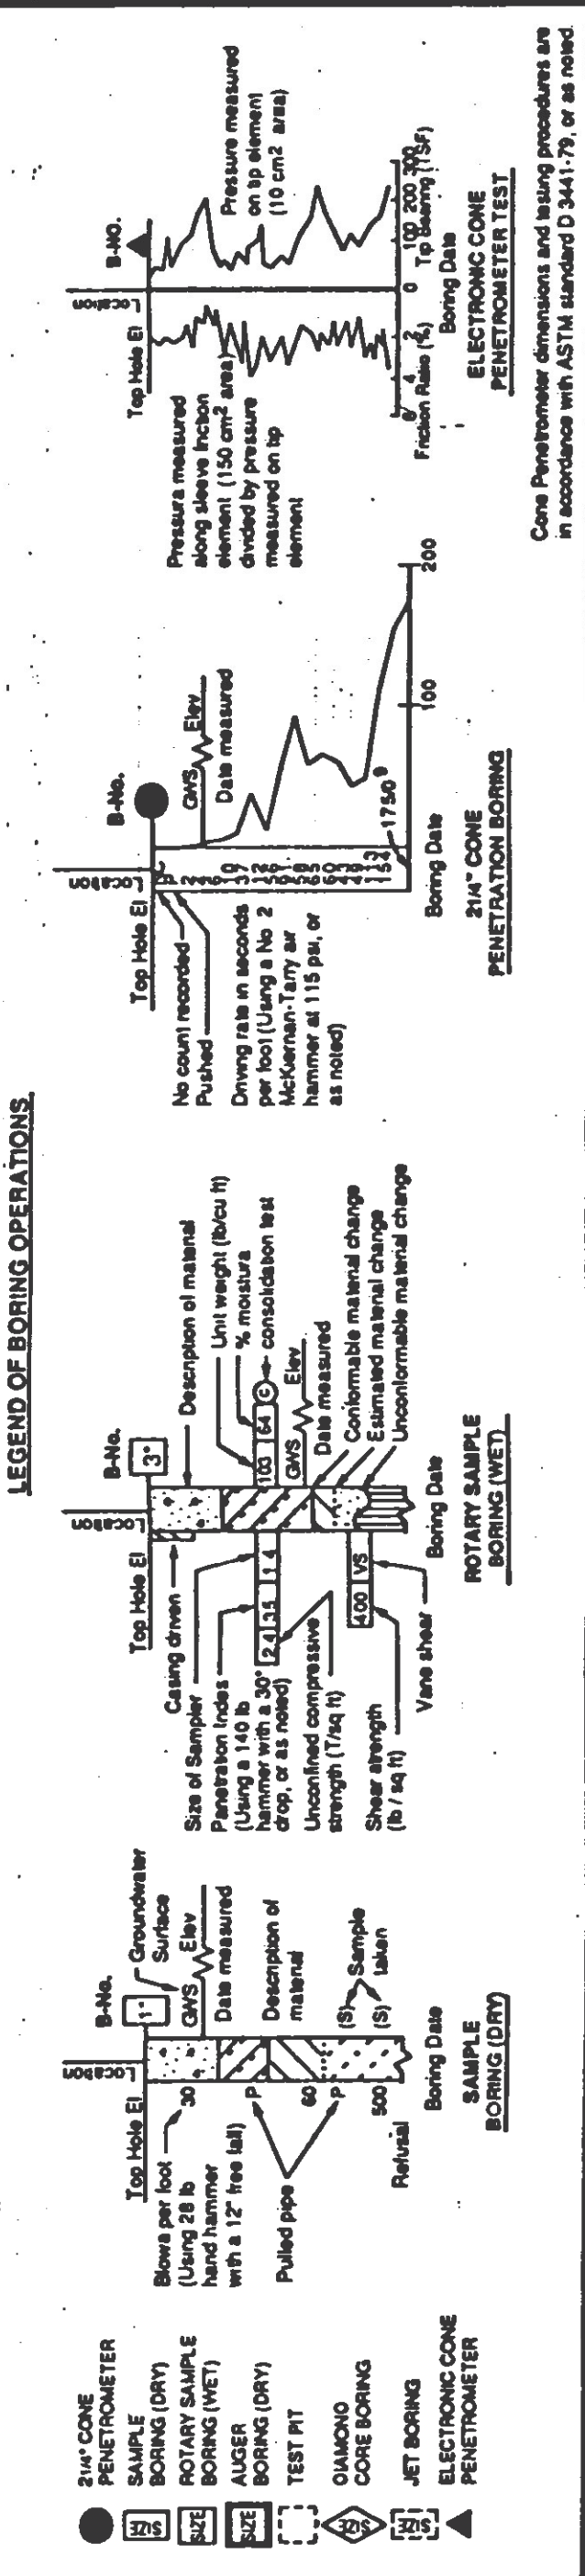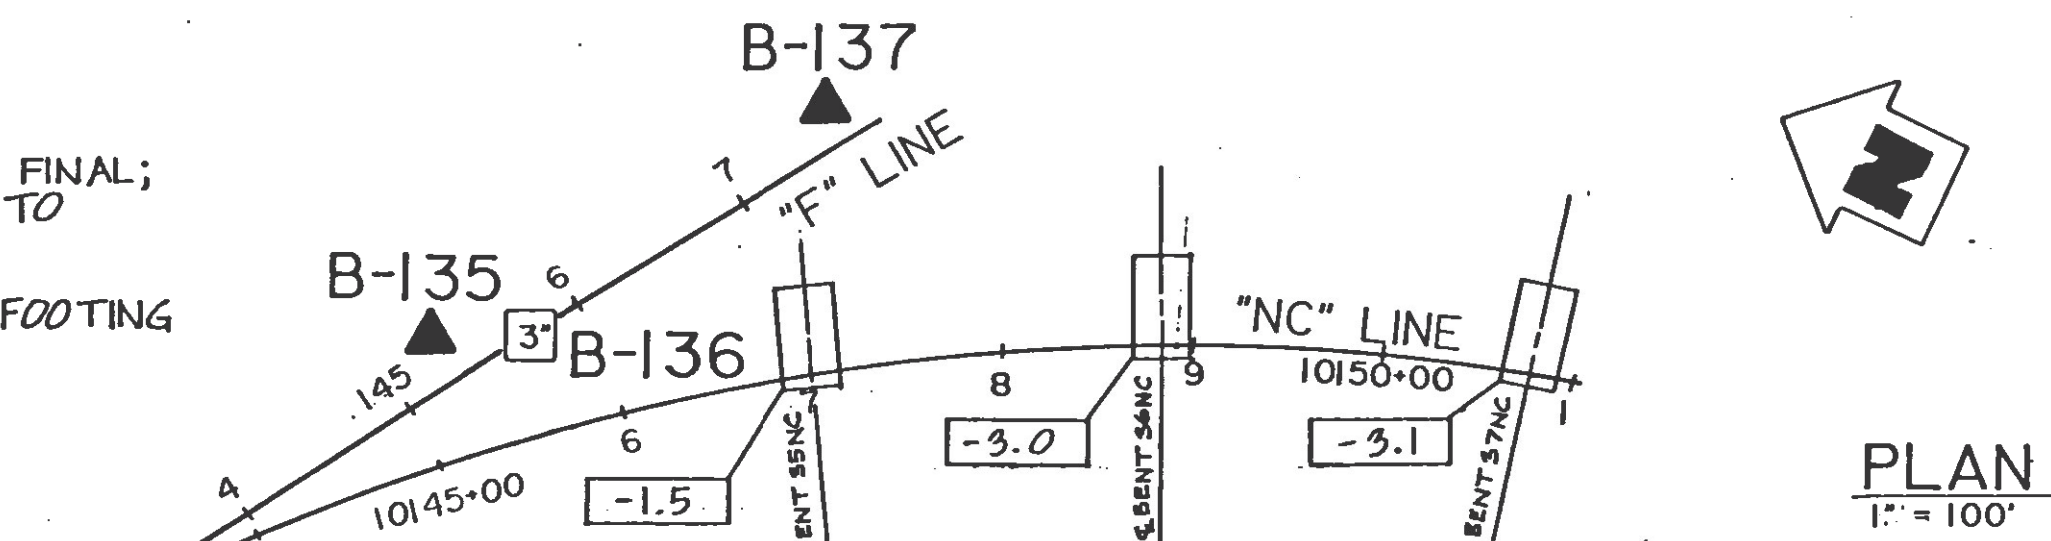

LEGEND OF EARTH MATERIALS


GRAVEL	CLAYEY SILT
SAND	PEAT and/or ORGANIC MATTER
SILT	FILL MATERIAL
CLAY	IGNEOUS ROCK
SANDY CLAY or CLAYEY SAND	SEDIMENTARY ROCK
SANDY SILT or SILTY SAND	METAMORPHIC ROCK
SILTY CLAY	ROCK

CONSISTENCY CLASSIFICATION FOR SOILS
 According to the Standard Penetration Test

Penetration Index (Blows / Ft)	Cohesive
0-4	Very loose
5-9	Loose
10-19	Slightly compact
20-34	Compact
35-59	Dense
>10	Very dense

NOTE: Classification of earth material as shown on this sheet is based upon field inspection and is not to be construed to imply mechanical analysis.

BENCH MARK
 SEE "LOG OF TEST BORING" SHEET 1 OF 14

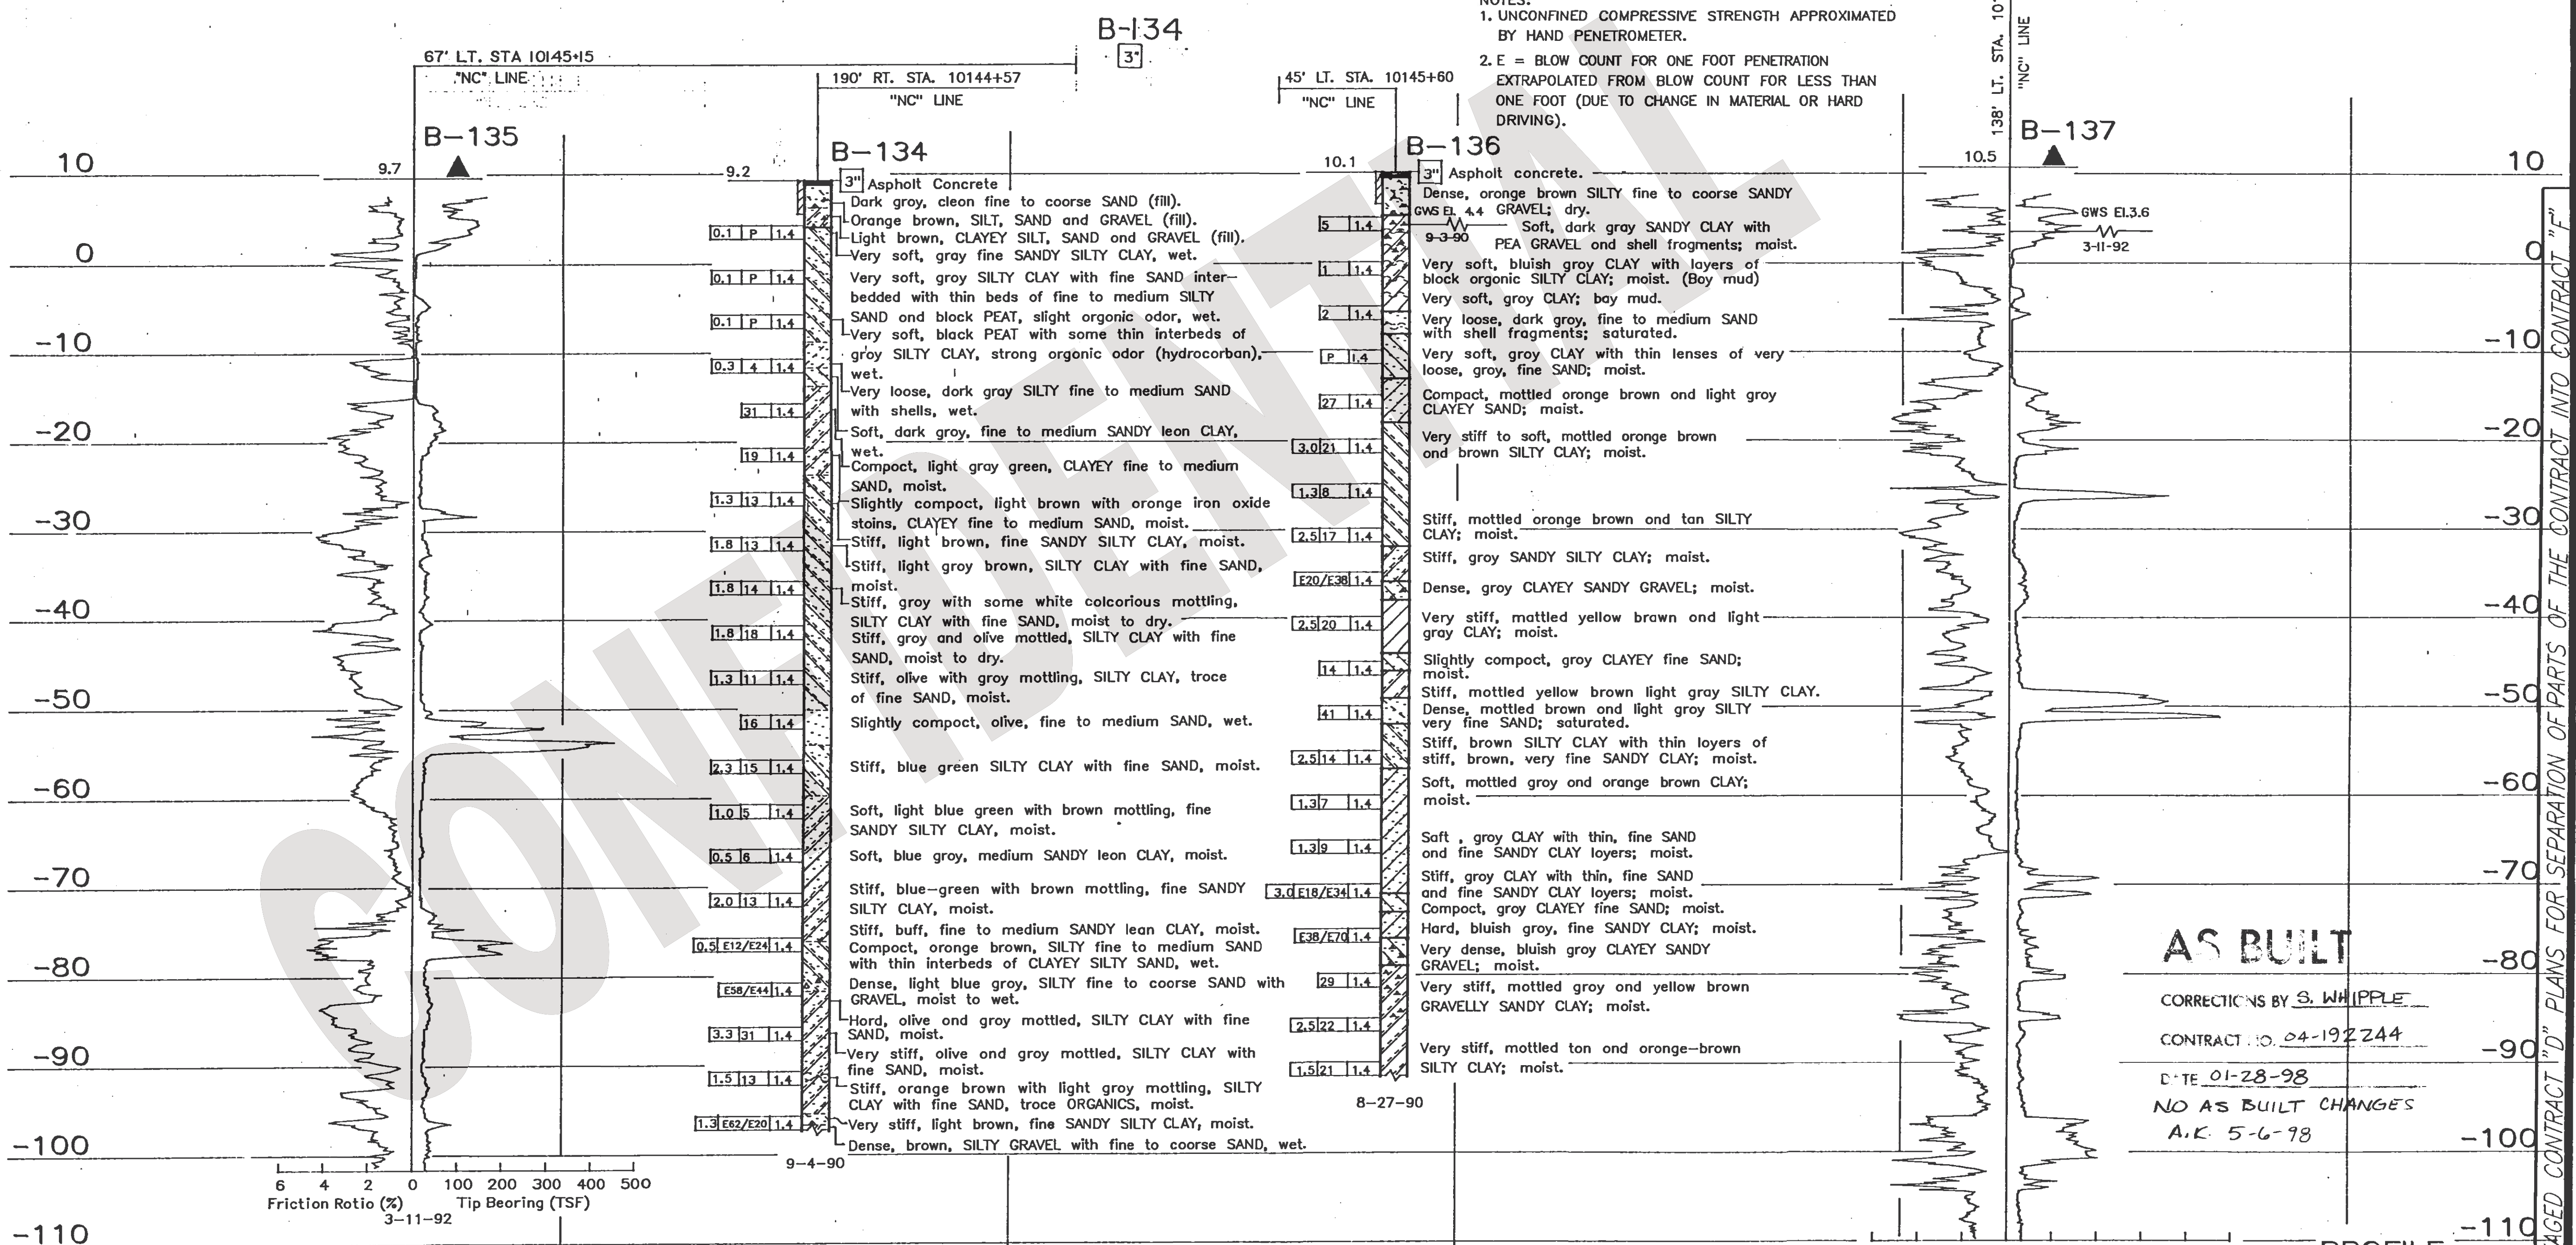

3 ADDED PER ADDENDUM NO. 3 DATED MAY 25, 1995

OFFICE OF TRANSPORTATION MATERIALS & RESEARCH ENGINEERING GEOLOGY BRANCH		FIELD INVESTIGATION BY: M. WILLIAM	State of CALIFORNIA DEPARTMENT OF TRANSPORTATION	DIVISION OF STRUCTURES STRUCTURE DESIGN	BRIDGE NO. 33-612 E POST MILE	PORT OF OAKLAND CONN. VIADUCT LOG OF TEST BORINGS 3 OF 14
DRAWN BY K. WAHL	5-92	ORIGINAL SCALE IN INCHES FOR REDUCED PLANS 0 1 2 3	CU 04 EA 192281	DISREGARD PRINTS BEARING EARLIER REVISION DATES	REVISION DATES (PRELIMINARY STAGE ONLY)	SHEET 44 OF 106 81 106

DIST.	COUNTY	ROUTE	POST MILES TOTAL PROJECT	SHEET NO.	TOTAL SHEETS
04	Ala	880	34.3/35.0	1022	1046

R.C. Williams
CERTIFIED ENGINEERING GEOLOGIST


REGISTERED GEOLOGIST
 R.C. WILHELMS
 No. 560
 Exp. 6-30-94
 CERTIFIED ENGINEERING GEOLOGIST
 STATE OF CALIFORNIA

3-13-95
 PLANS APPROVAL DATE

The State of California or its officers or agents shall not be responsible for the accuracy or completeness of electronic copies of this plan sheet.

NOTES:
 THIS ALIGNMENT MAY NOT BE FINAL;
 FOR FINAL ALIGNMENT REFER TO
 FOUNDATION PLANS

-1.5 INDICATES BOTTOM OF FOOTING
 ELEVATION

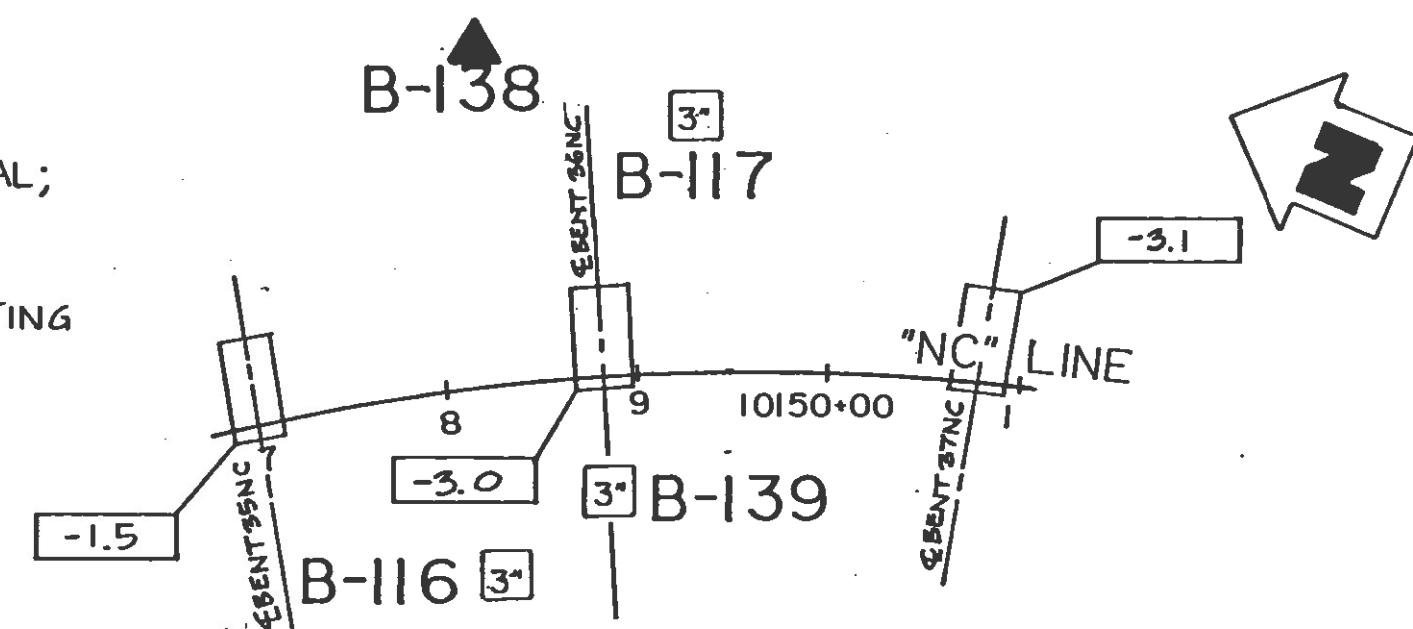


PLAN
 1" = 100'

AS BUILT

CORRECTIONS BY S. WHIPPLE
 CONTRACT NO. 04-192244
 DATE 01-28-98
 NO AS-BUILT CHANGES
 A.K. 5-6-98

NOTE:
 1. UNCONFINED COMPRESSIVE STRENGTH APPROXIMATED BY HAND PENETROMETER.
 2. E = BLOW COUNT FOR ONE FOOT PENETRATION EXTRAPOLATED FROM BLOW COUNT FOR LESS THAN ONE FOOT (DUE TO CHANGE IN MATERIAL OR HARD DRIVING).

BENCH MARK
 SEE "LOG OF TEST BORING" SHEET 1 OF 14

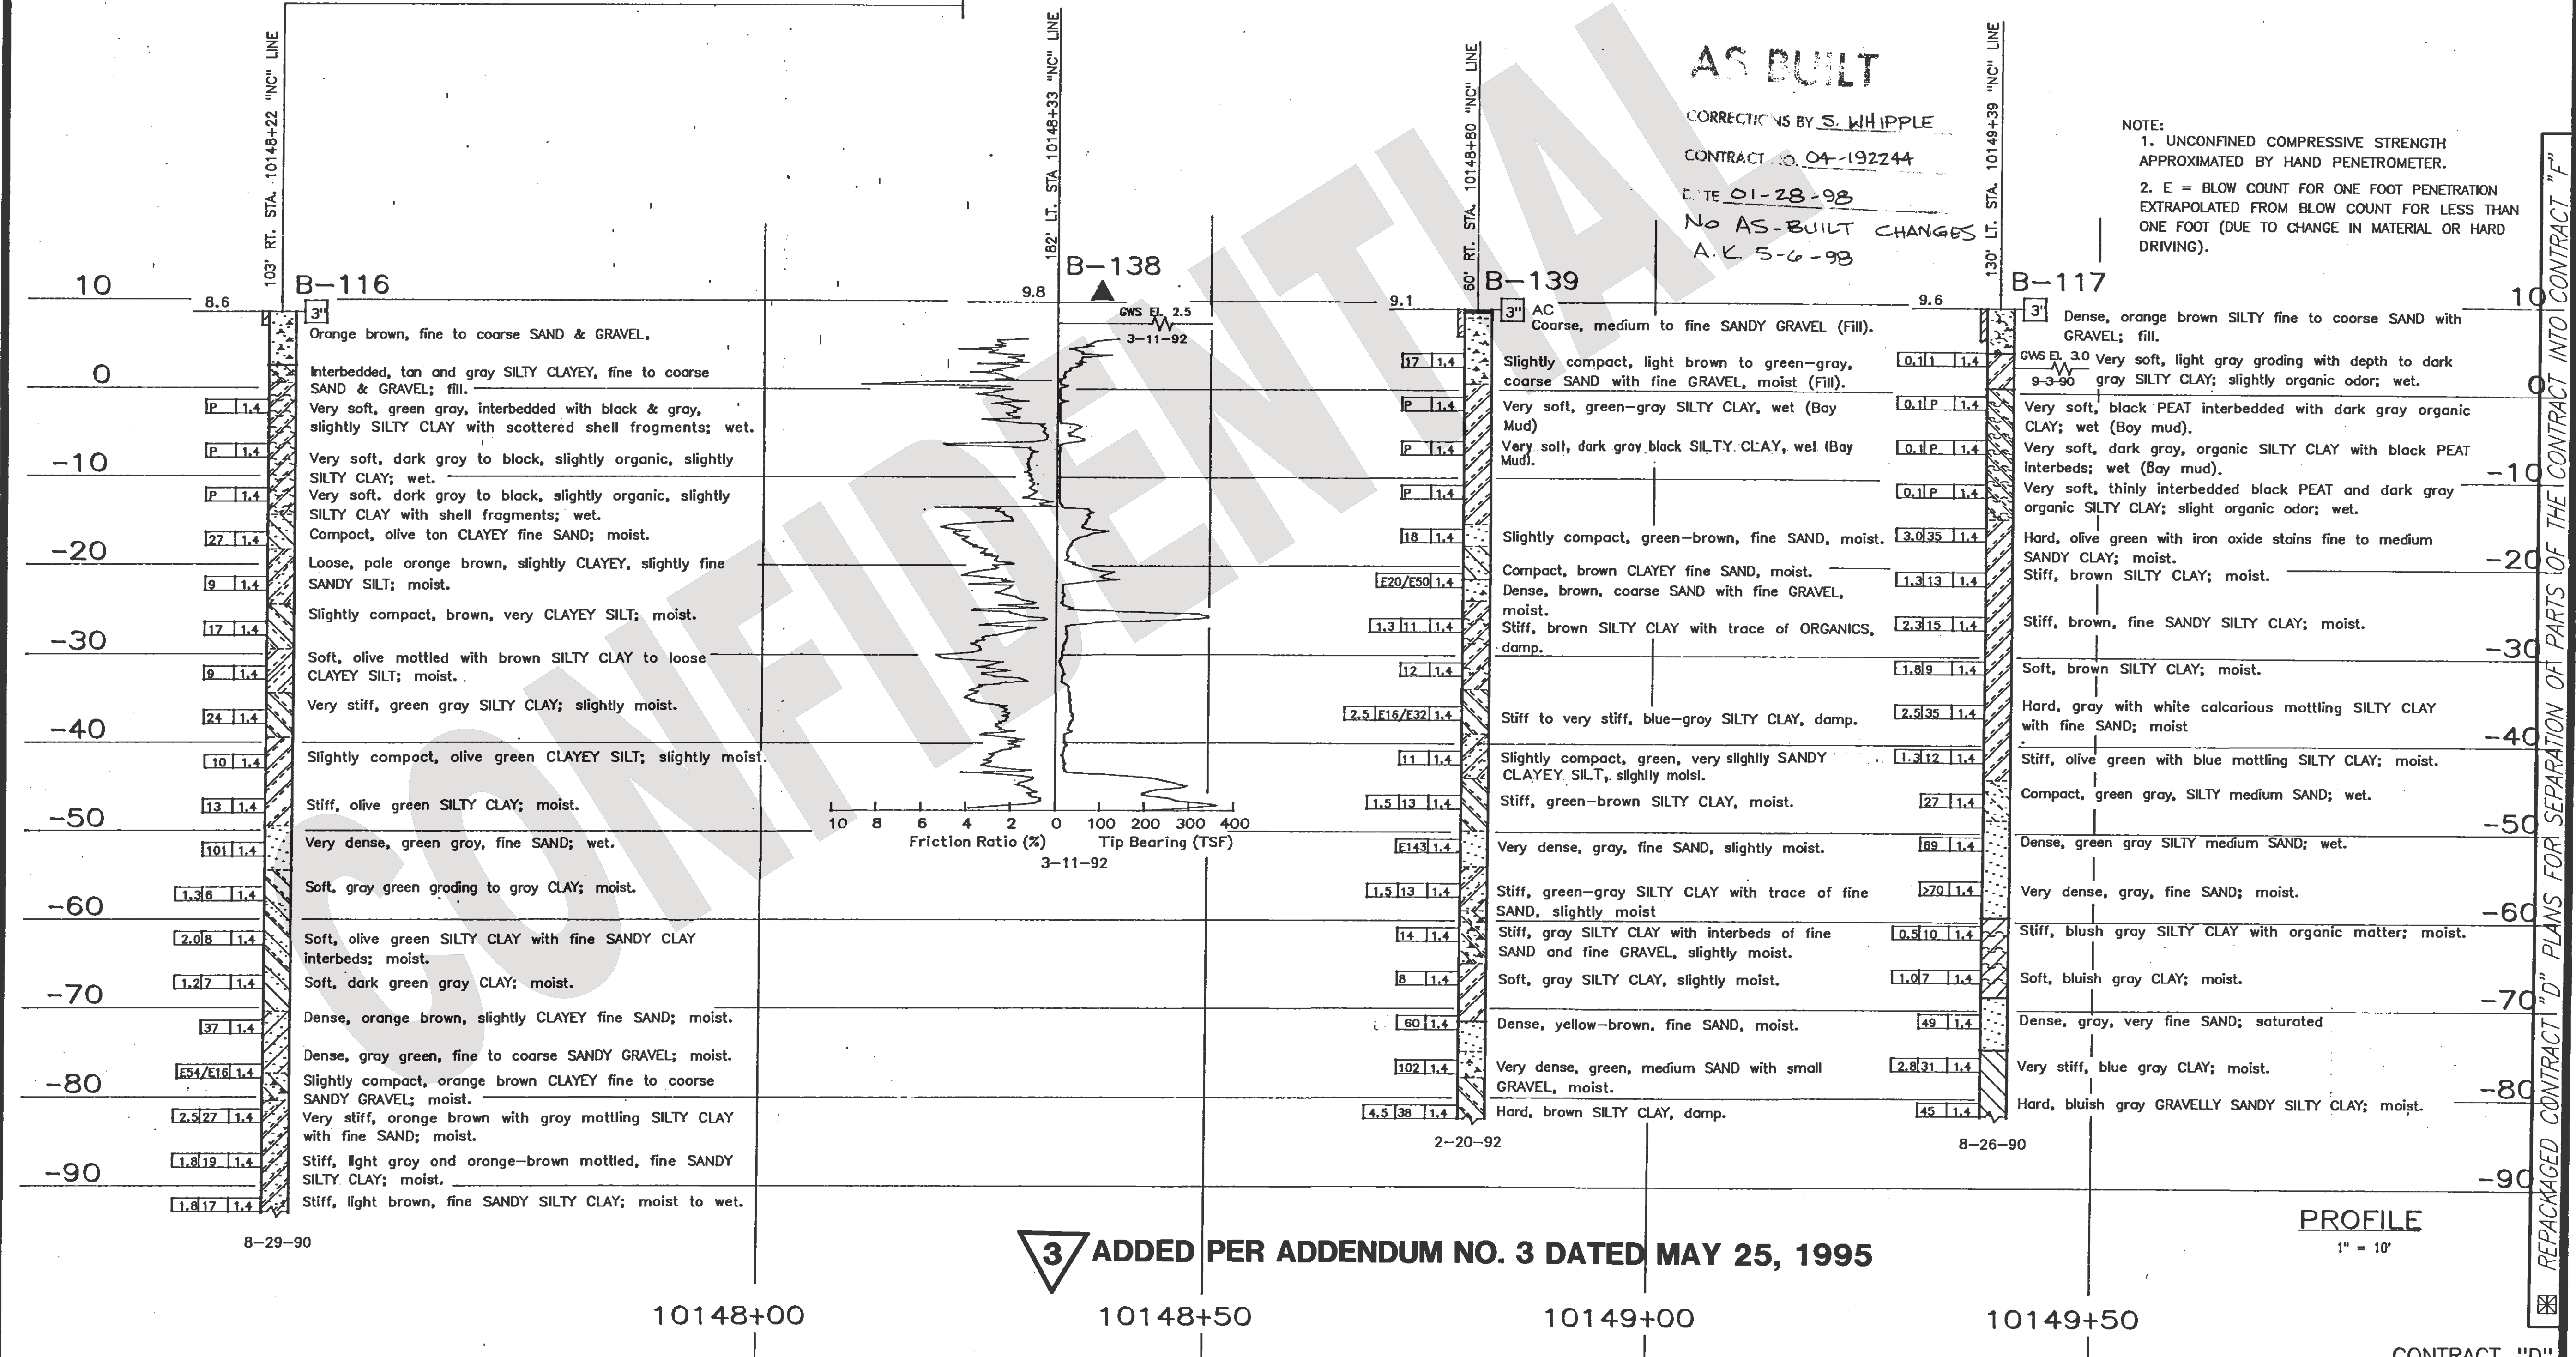

3 ADDED PER ADDENDUM NO. 3 DATED MAY 25, 1995

PROFILE
 1" = 10'

LEGEND OF BORING OPERATIONS.

2 1/4" CONE PENETROMETER TEST
 Pressure measured using a 2 1/4" cone penetrometer. Data measured on 10 cm² area.

2 1/4" CONE PENETROMETER TEST
 No count recorded. Pushed. Driving rate in seconds. Minimum 100 lb. Hammer at 18 in. or as noted.

ROTARY SAMPLE BORING (WET)
 Description of material. Unit weight (lb/cu ft). Moisture (%). Consolidation test. Estimated material change. Unrecoverable material change.

SAMPLE BORING (DRY)
 Blow per foot (Using 28 lb hand hammer with 1/4" line bit). Pushed pipe. Shear strength (lb/cu ft). Refusal.

LEGEND OF EARTH MATERIALS
 CLAYEY SILT, PEAT and/or ORGANIC MATERIAL, FILL MATERIAL, UNCONSOLIDATED SAND, UNCONSOLIDATED SILT, UNCONSOLIDATED CLAY, SANDY CLAY or CLAYEY SAND, SANDY SILT or SILTY SAND, SILTY CLAY, GRAVEL, SAND, SILT, CLAY, SEDIMENTARY ROCK, METAMORPHIC ROCK, IGNEOUS ROCK.

CONSISTENCY CLASSIFICATION FOR SOILS

According to the Standard Penetration Test

Penetration (Blows/Ft)	Granular	Cohesive
0-4	Very loose	Very soft
5-9	Loose	Soft
10-19	Slightly compact	Stiff
20-29	Compact	Very stiff
30-59	Very compact	Hard
>70	Very dense	Very hard

NOTE: Classification of earth material as shown on this sheet is based upon field inspection and is not to be construed to imply mechanical analysis.

OFFICE OF TRANSPORTATION MATERIALS & RESEARCH		ENGINEERING GEOLOGY BRANCH	FIELD INVESTIGATION BY: M. WILLIAM	State of CALIFORNIA DEPARTMENT OF TRANSPORTATION	DIVISION OF STRUCTURES STRUCTURE DESIGN	BRIDGE NO. 33-612 E	PORT OF OAKLAND CONN. VIADUCT
DRAWN BY: K. WAHL	5-92					POST MILE	LOG OF TEST BORINGS 4 OF 14
CHECKED BY:							

ORIGINAL SCALE IN INCHES FOR REDUCED PLANS 0 1 2 3

CU 04 EA 192281

DISREGARD PRINTS BEARING EARLIER REVISION DATES

REVISION DATES (PRELIMINARY STAGE ONLY)


SHEET 82 OF 106

DIST.	COUNTY	ROUTE	POST MILES TOTAL PROJECT	SHEET NO.	TOTAL SHEETS
04	Ala	880	34.3/35.0	1023	1046

R.C. Wilhelms
 REGISTERED GEOLOGIST
 CERTIFIED ENGINEERING GEOLOGIST
 No. 560
 Exp. 6-30-94
 STATE OF CALIFORNIA

3-13-95
 PLANS APPROVAL DATE

The State of California or its officers or agents shall not be responsible for the accuracy or completeness of electronic copies of this plan sheet.

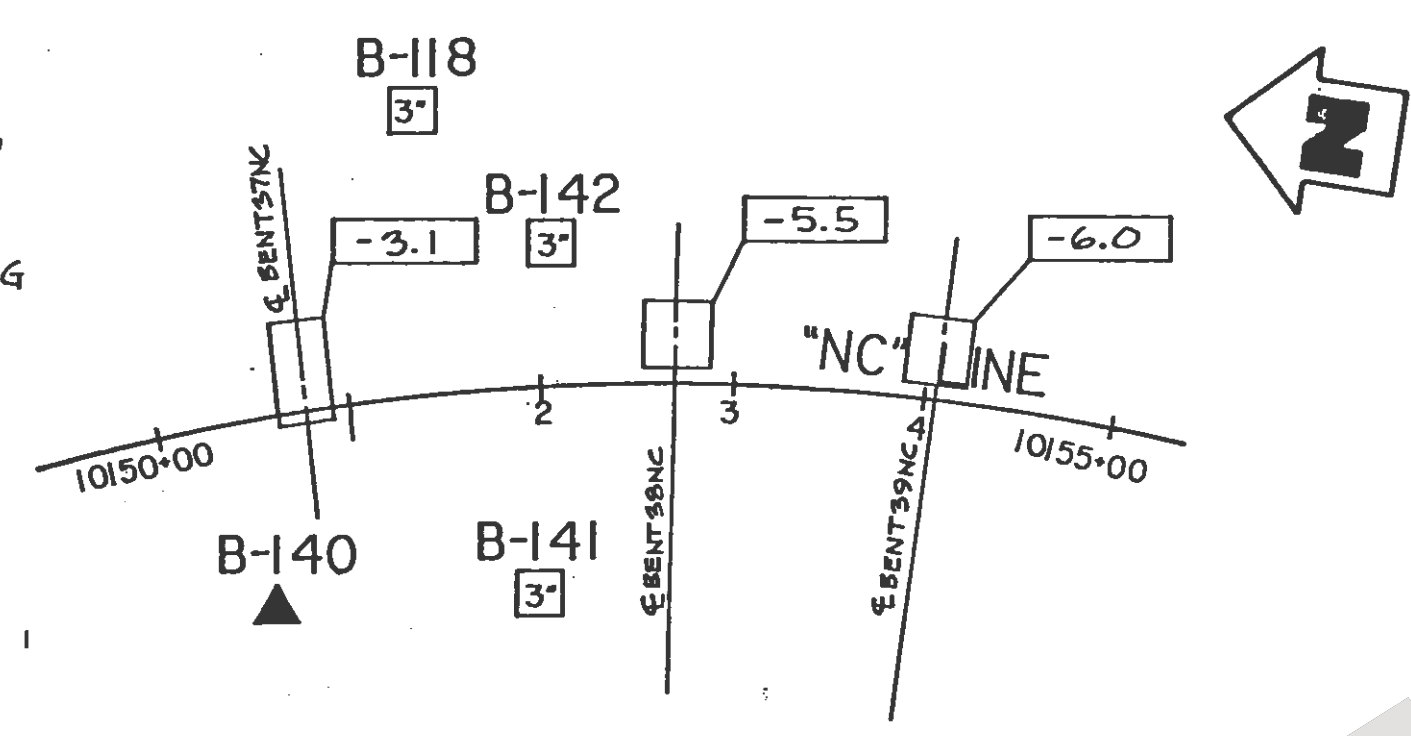

BENCH MARK
SEE "LOG OF TEST BORINGS 1 OF 14"

- NOTES:
- UNCONFINED COMPRESSIVE STRENGTH APPROXIMATED BY HAND PENETROMETER TEST
 - E = BLOW COUNT FOR ONE FOOT PENETRATION EXTRAPOLATED FROM BLOW COUNT FOR LESS THAN ONE FOOT (DUE TO CHANGE IN MATERIAL OR HARD DRIVING)

PLAN
1" = 100'

AS BUILT
 CORRECTIONS BY S. WHIPPLE
 CONTRACT NO. 04-192244
 DATE 01-28-98
 NO AS-BUILT CHANGES
 A.K. 5-6-98

LEGEND OF BORING OPERATIONS


LEGEND OF EARTH MATERIALS

CONSISTENCY CLASSIFICATION FOR SOILS

According to the Standard Penetration Test

Penetration Index (Blows / Ft)	Consistency
0-4	Very soft
5-9	Soft
10-19	Slightly compact
20-34	Compact
35-69	Dense
5-70	Very dense

NOTE: Classification of earth material as shown on this sheet is based upon field inspection and is not to be construed as implying mechanical analysis.

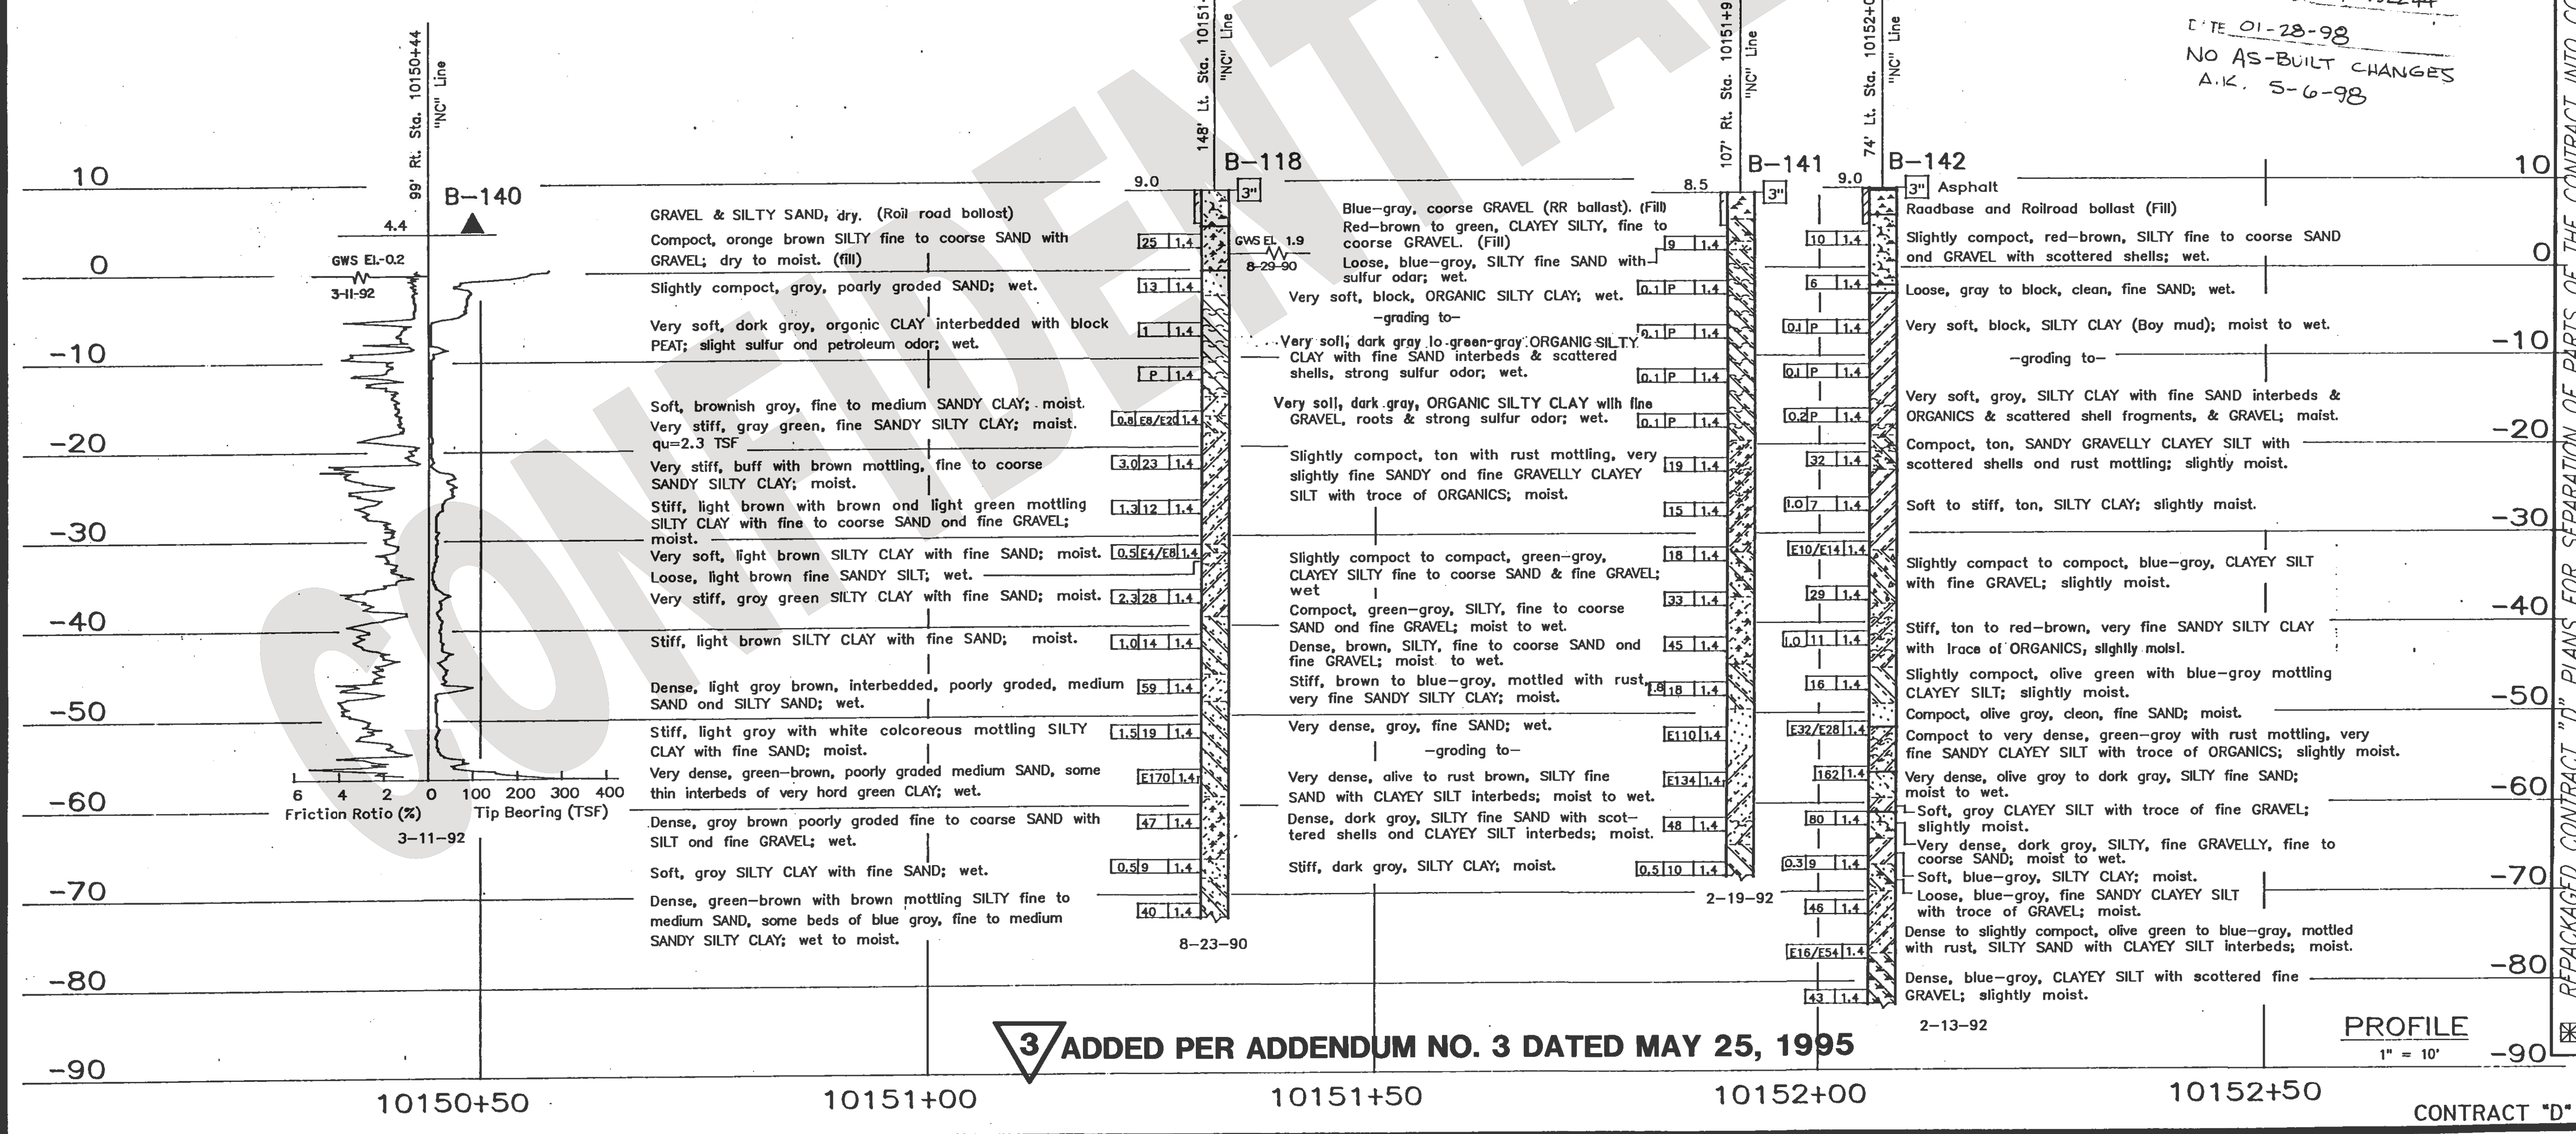

3 ADDED PER ADDENDUM NO. 3 DATED MAY 25, 1995

OFFICE OF TRANSPORTATION MATERIALS & RESEARCH		ENGINEERING GEOLOGY BRANCH	FIELD INVESTIGATION BY:	State of CALIFORNIA DEPARTMENT OF TRANSPORTATION	DIVISION OF STRUCTURES STRUCTURE DESIGN	BRIDGE NO. 33-612 E	PORT OF OAKLAND CONN. VIADUCT
DRAWN BY	IRMA GAMARRA	5/92	M. WILLIAN	DEPARTMENT OF TRANSPORTATION	STRUCTURE DESIGN	POST MILE	LOG OF TEST BORINGS 5 OF 14
CHECKED BY				CU 04 EA 192281		DISREGARD PRINTS BEARING EARLIER REVISION DATES	REVISION DATES (PRELIMINARY STAGE ONLY)
				ORIGINAL SCALE IN INCHES FOR REDUCED PLANS	0 1 2 3		SHEET 143 OF 166

3


DIST.	COUNTY	ROUTE	POST MILES TOTAL PROJECT	SHEET NO.	TOTAL SHEETS
04	Ala	880	34.3/35.0	1024	1046

R.C. Wilhelm
 CERTIFIED ENGINEERING GEOLOGIST
 No. 560
 Exp. 6-30-94
 REGISTERED GEOLOGIST
 STATE OF CALIFORNIA

3-13-95
 PLANS APPROVAL DATE


The State of California or its officers or agents shall not be responsible for the accuracy or completeness of electronic copies of this plan sheet.

NOTES:
 THIS ALIGNMENT MAY NOT BE FINAL;
 FOR FINAL ALIGNMENT REFER TO
 FOUNDATION PLANS
 -3.1 INDICATES BOTTOM OF FOOTING
 ELEVATION

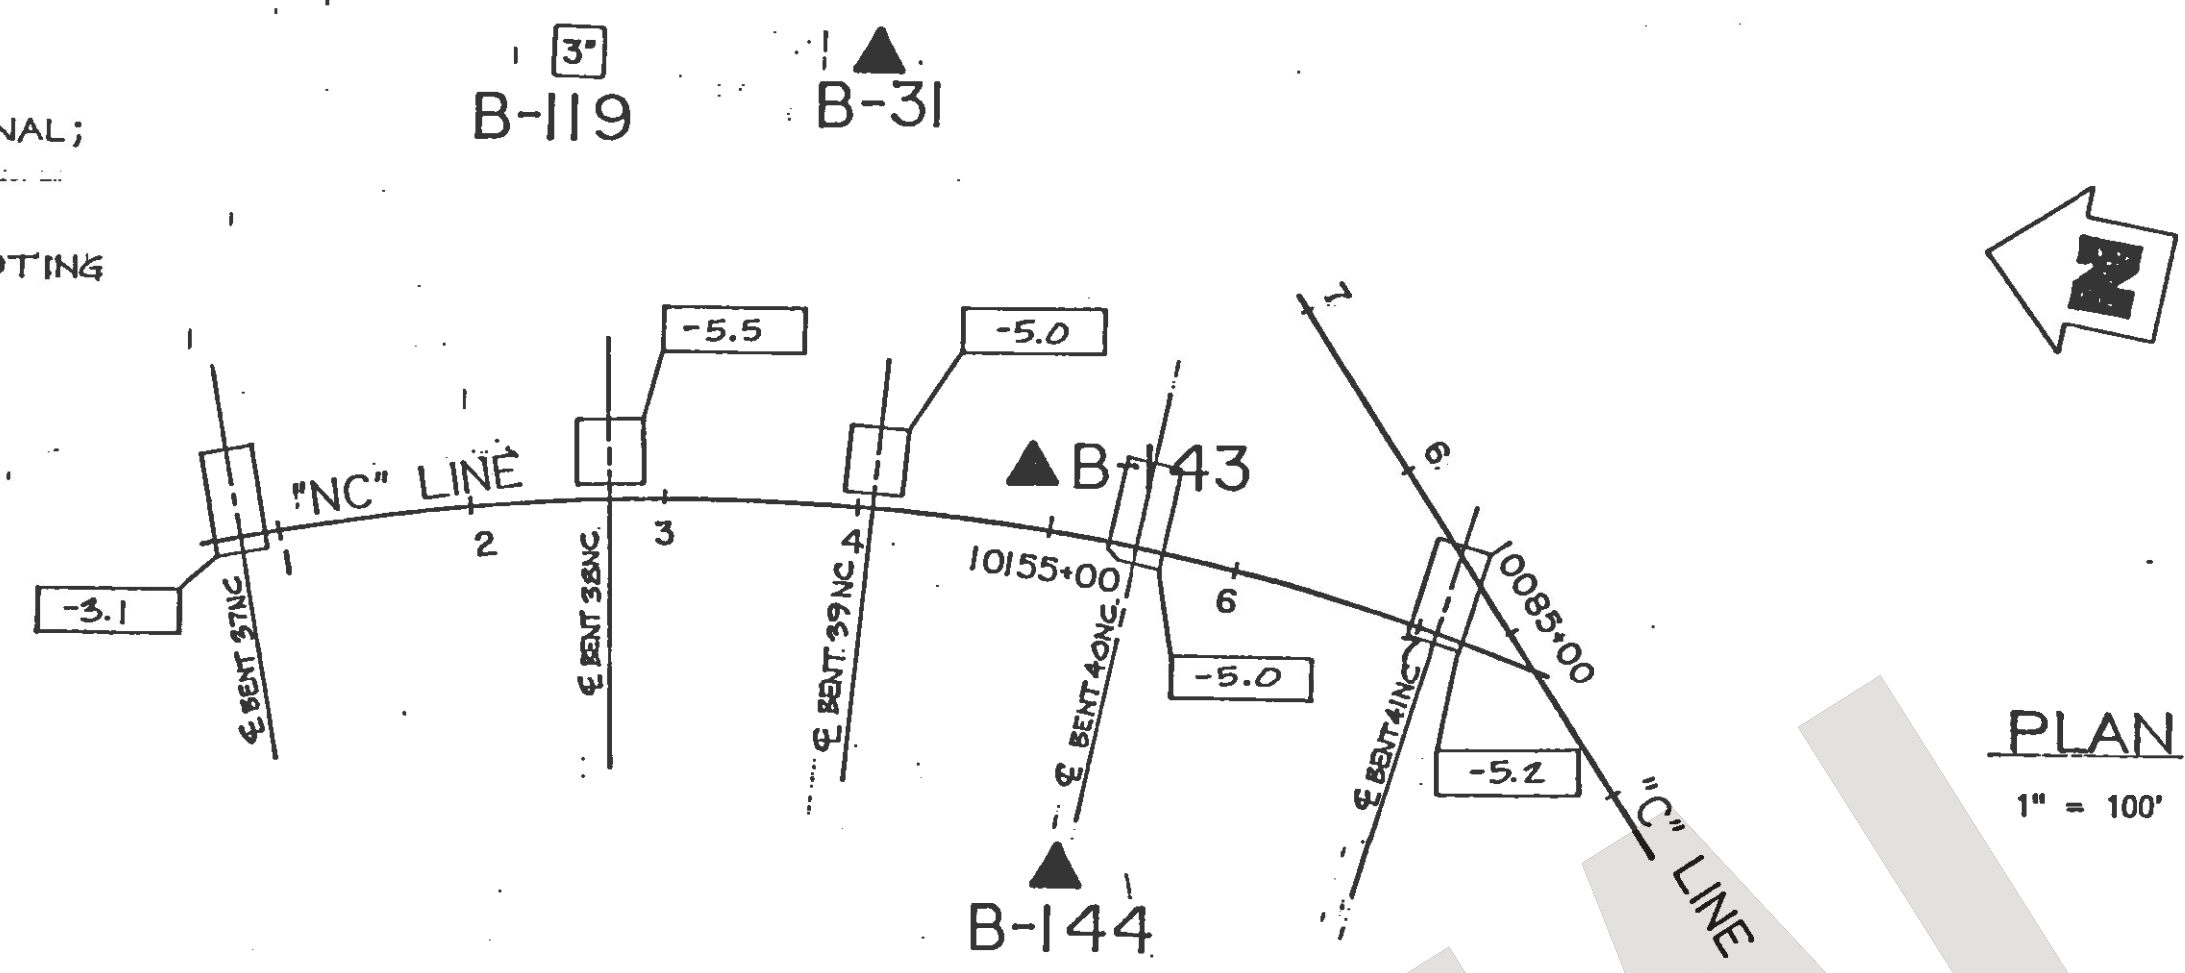

BENCH MARK

SEE "LOG OF TEST BORING" SHEET 1 OF 14

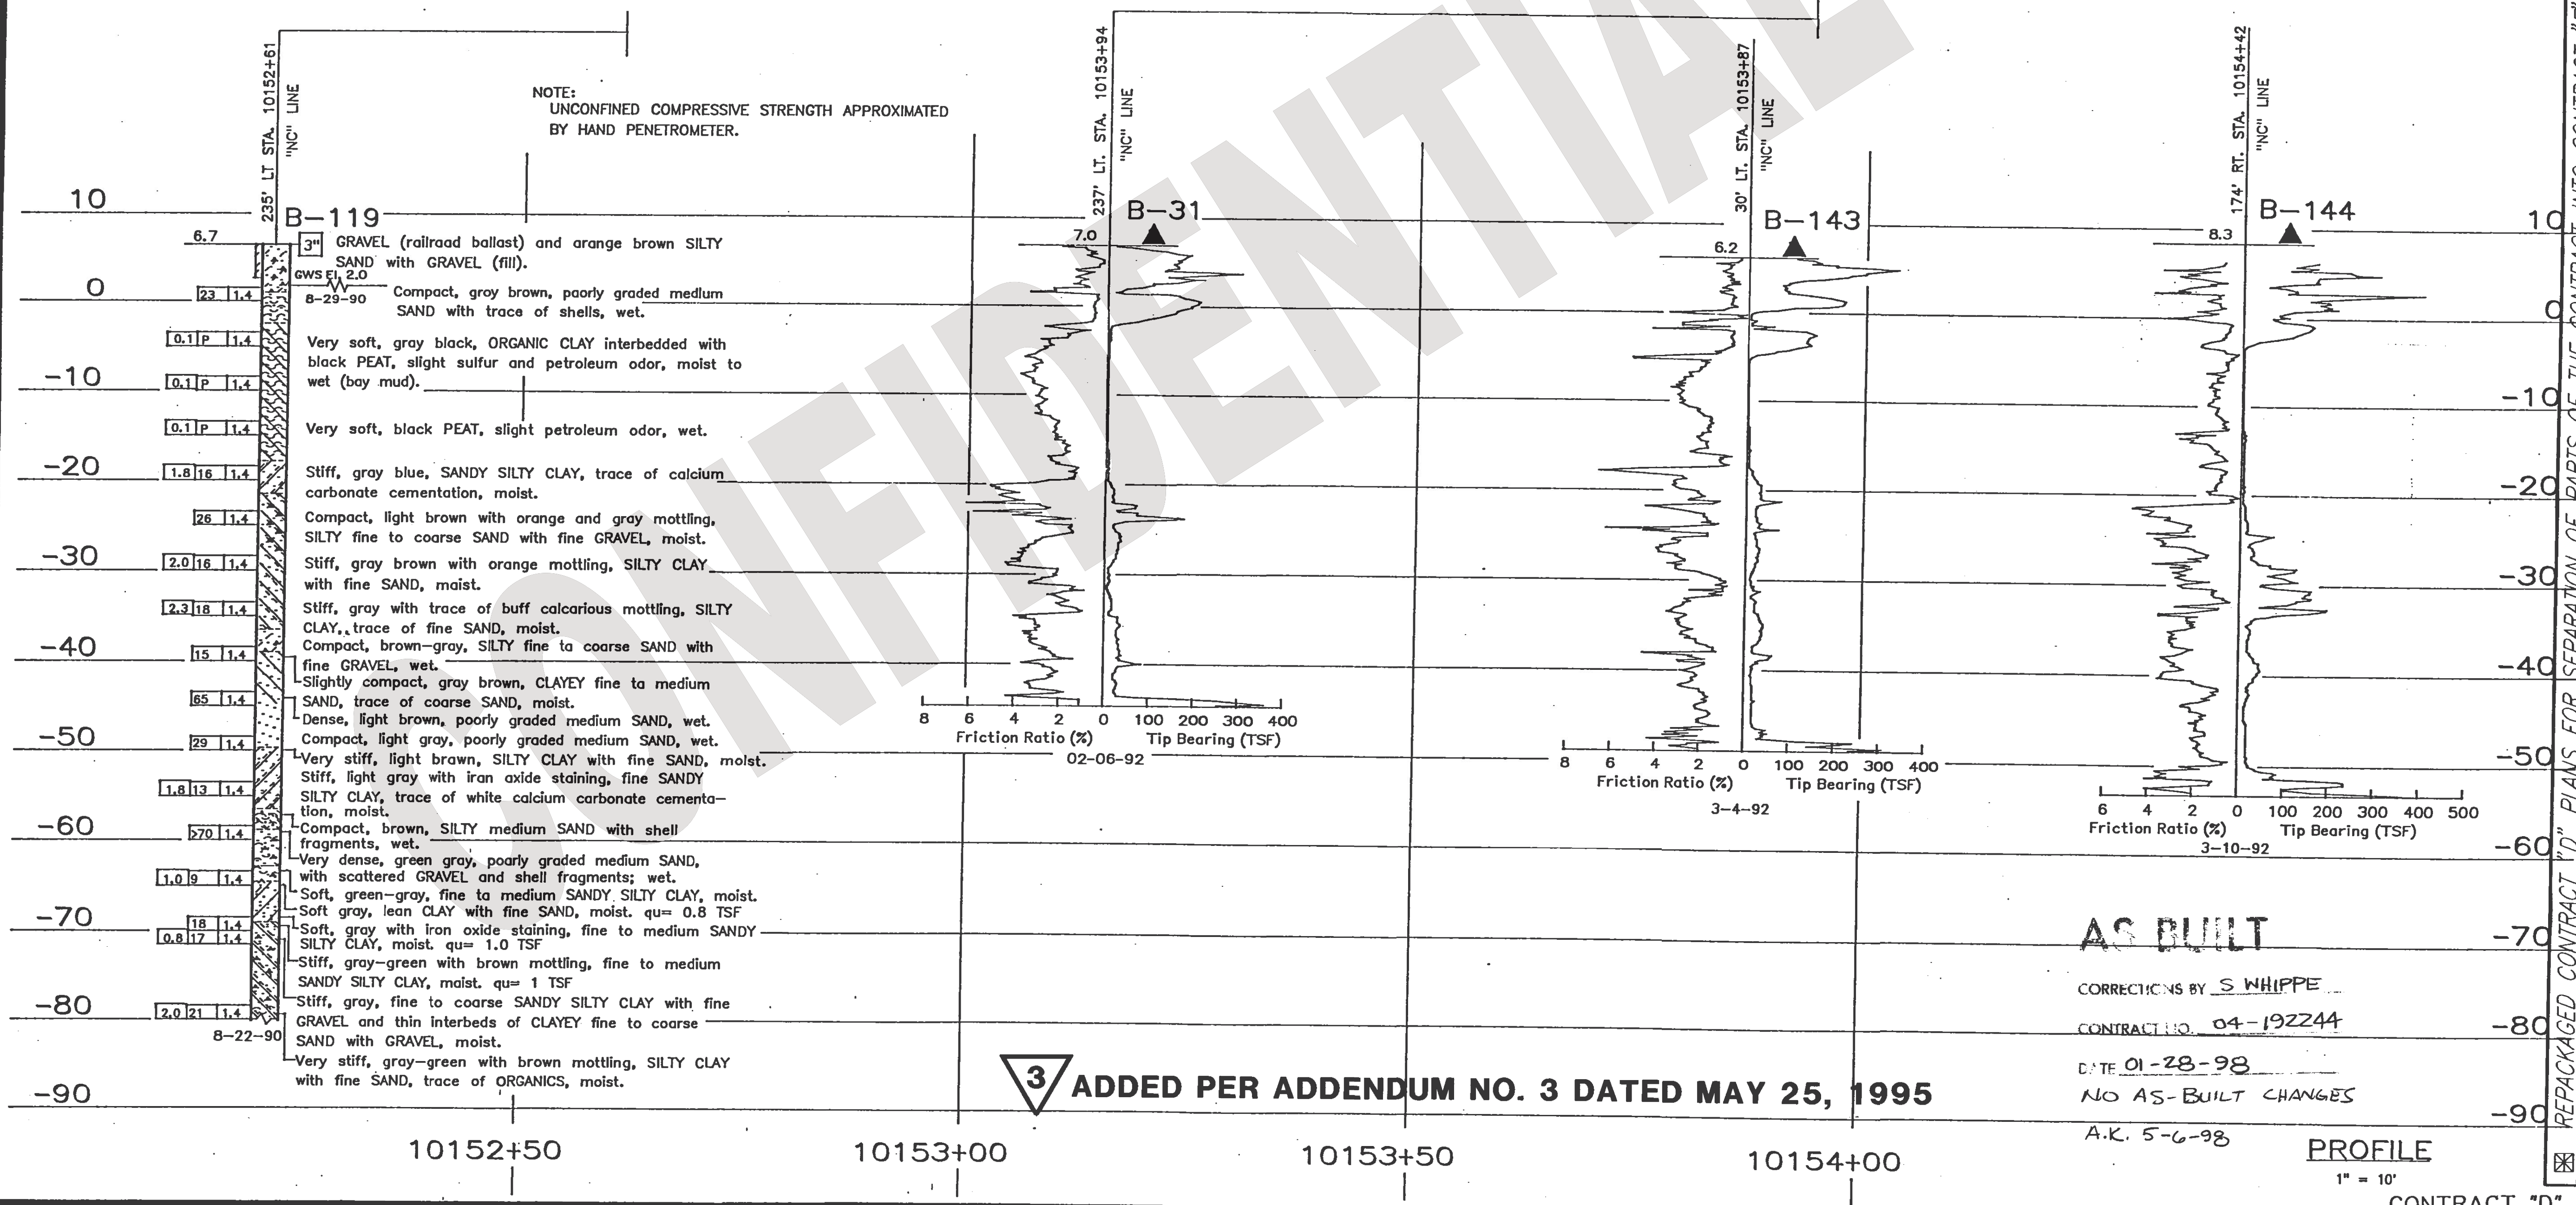

NOTE:
 UNCONFINED COMPRESSIVE STRENGTH APPROXIMATED
 BY HAND PENETROMETER.

3 ADDED PER ADDENDUM NO. 3 DATED MAY 25, 1995

AS BUILT

CORRECTIONS BY S. WHIPPE
 CONTRACT NO. 04-192244
 DATE 01-28-98
 NO AS-BUILT CHANGES
 A.K. 5-6-98

PROFILE

CONTRACT "D".

LEGEND OF BORING OPERATIONS

2 1/4" CONE PENETROMETER
 SAMPLE (DRY)
 ROTARY SAMPLE BORING (WET)
 AUGER BORING (DRY)
 TEST PIT
 DIAMOND CORE BORING
 4" CONE PENETROMETER

LEGEND OF EARTH MATERIALS

GRAVEL
 SAND
 SILT
 CLAY
 SANDY CLAY
 CLAYEY SAND
 SANDY SILT
 SILTY SAND
 SILTY CLAY

CLAYEY SILT
 PEAT and/or ORGANIC MATERIAL
 FILL MATERIAL
 IGNEOUS ROCK
 SEDIMENTARY ROCK
 METAMORPHIC ROCK

CONSISTENCY CLASSIFICATION FOR SOILS

According to the Standard Penetration Test

Penetration Index (Blows / Ft)	Cohesive
0-4	Very soft
5-9	Soft
10-19	Slightly compact
20-34	Compact
35-59	Very stiff
>70	Very hard

NOTE: Classification of earth material as shown on this sheet is based upon field inspection and is not to be construed to imply mechanical analysis.

OFFICE OF TRANSPORTATION MATERIALS & RESEARCH		ENGINEERING GEOLOGY BRANCH	FIELD INVESTIGATION BY: M. WILLIAM	State of CALIFORNIA DEPARTMENT OF TRANSPORTATION	DIVISION OF STRUCTURES STRUCTURE DESIGN	BRIDGE NO. 33-612 E	PORT OF OAKLAND CONN. VIADUCT
DRAWN BY: K. WAHL	5-92					POST MILE	LOG OF TEST BORINGS 6 OF 14
CHECKED BY:							

ORIGINAL SCALE IN INCHES FOR REDUCED PLANS 0 1 2 3

CU 04
 EA 192281

DISREGARD PRINTS BEARING EARLIER REVISION DATES

REVISION DATES (PRELIMINARY STAGE ONLY)

SHEET 84 OF 106

3

DIST.	COUNTY	ROUTE	POST MILES TOTAL PROJECT	SHEET NO.	TOTAL SHEETS
04	Ala	880	34.3/35.0	1025	1046

R.C. Wilhelms
 CERTIFIED ENGINEERING GEOLOGIST


REGISTERED GEOLOGIST
 R.C. WILHELMS
 No. 560
 Exp. 6-30-94
 CERTIFIED ENGINEERING GEOLOGIST
 STATE OF CALIFORNIA

3-13-95
 PLANS APPROVAL DATE

The State of California or its officers or agents shall not be responsible for the accuracy or completeness of electronic copies of this plan sheet.

NOTES:
 THIS ALIGNMENT MAY NOT BE FINAL;
 FOR FINAL ALIGNMENT REFER TO
 FOUNDATION PLANS

-5.0 INDICATES BOTTOM OF FOOTING
 ELEVATION

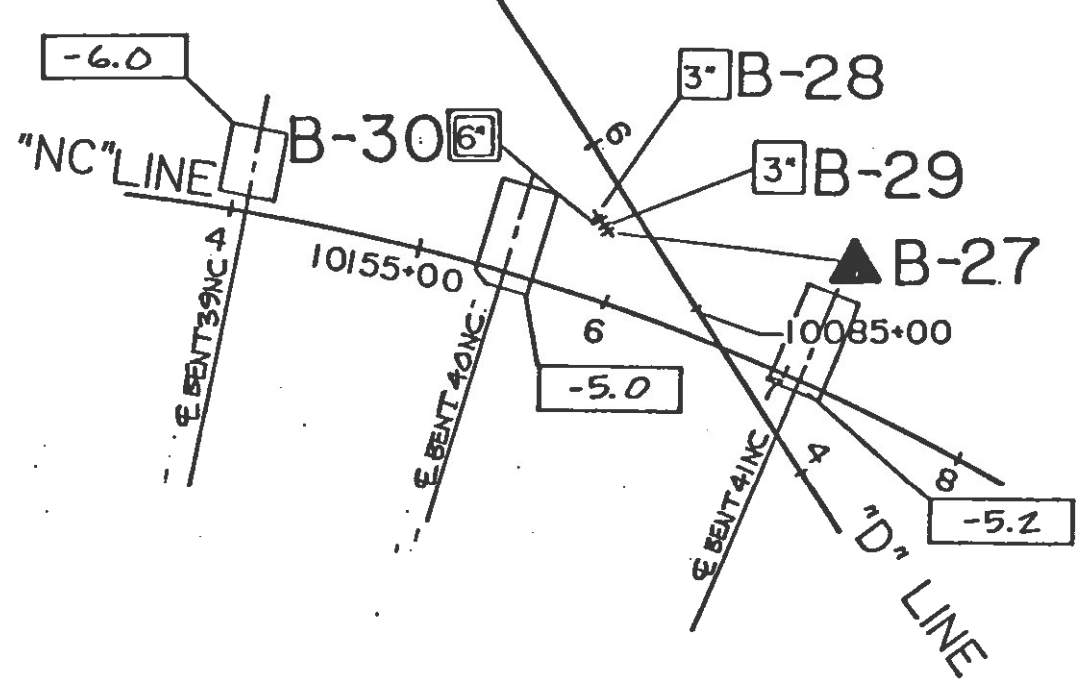

PLAN
 1" = 100'

AS BUILT

CORRECTIONS BY S. WHIPPLE
 CONTRACT NO. 04-192244
 DATE 01-28-98
 NO AS-BUILT CHANGES
 A.K. 5-6-98

- NOTE:
- E = BLOW COUNT FOR ONE FOOT PENETRATION
 EXTRAPOLATED FROM BLOW COUNT FOR LESS THAN
 ONE FOOT (DUE TO CHANGE IN MATERIAL OR HARD
 DRIVING).
 - UNCONFINED COMPRESSIVE STRENGTH APPROXIMATED
 BY HAND PENETROMETER TEST.

LEGEND OF BORING OPERATIONS

2 1/4" CONE PENETRATION BORING
 No count recorded
 Poured
 Driving rate in seconds
 divided by 100
 divided by pressure
 measured on tip
 element
 (10 cm² area)

ROTARY SAMPLE BORING (WET)
 Description of material
 Unit weight (lb/cu ft)
 % moisture
 % fines
 % organic
 Date measured
 GWS A Elev.
 Date measured
 Estimated material change
 Unconfined material change

ROTARY SAMPLE BORING (DRY)
 Description of material
 Unit weight (lb/cu ft)
 % moisture
 % fines
 % organic
 Date measured
 GWS A Elev.
 Date measured
 Estimated material change
 Unconfined material change

1 1/2" CONE PENETROMETER
 Penetration (blows/ft)
 Cohesive
 Very soft
 Soft
 Slightly compact
 Compact
 Very stiff
 Very hard


LEGEND OF EARTH MATERIALS

CLAYEY SILT
 PEAT and/or ORGANIC MATTER
 FILL MATERIAL
 IGNEOUS ROCK
 SEDIMENTARY ROCK
 METAMORPHIC ROCK

GRAVEL
 SAND
 SILT
 CLAY
 SANDY CLAY or CLAYEY SAND
 SANDY SILT or SILTY SAND
 SILTY CLAY

NOTE: Classification of earth material as shown on this sheet is based upon field inspection and is not to be construed to imply mechanical analysis.

BENCH MARK
 SEE "LOG OF TEST BORING" SHEET 1 OF 14

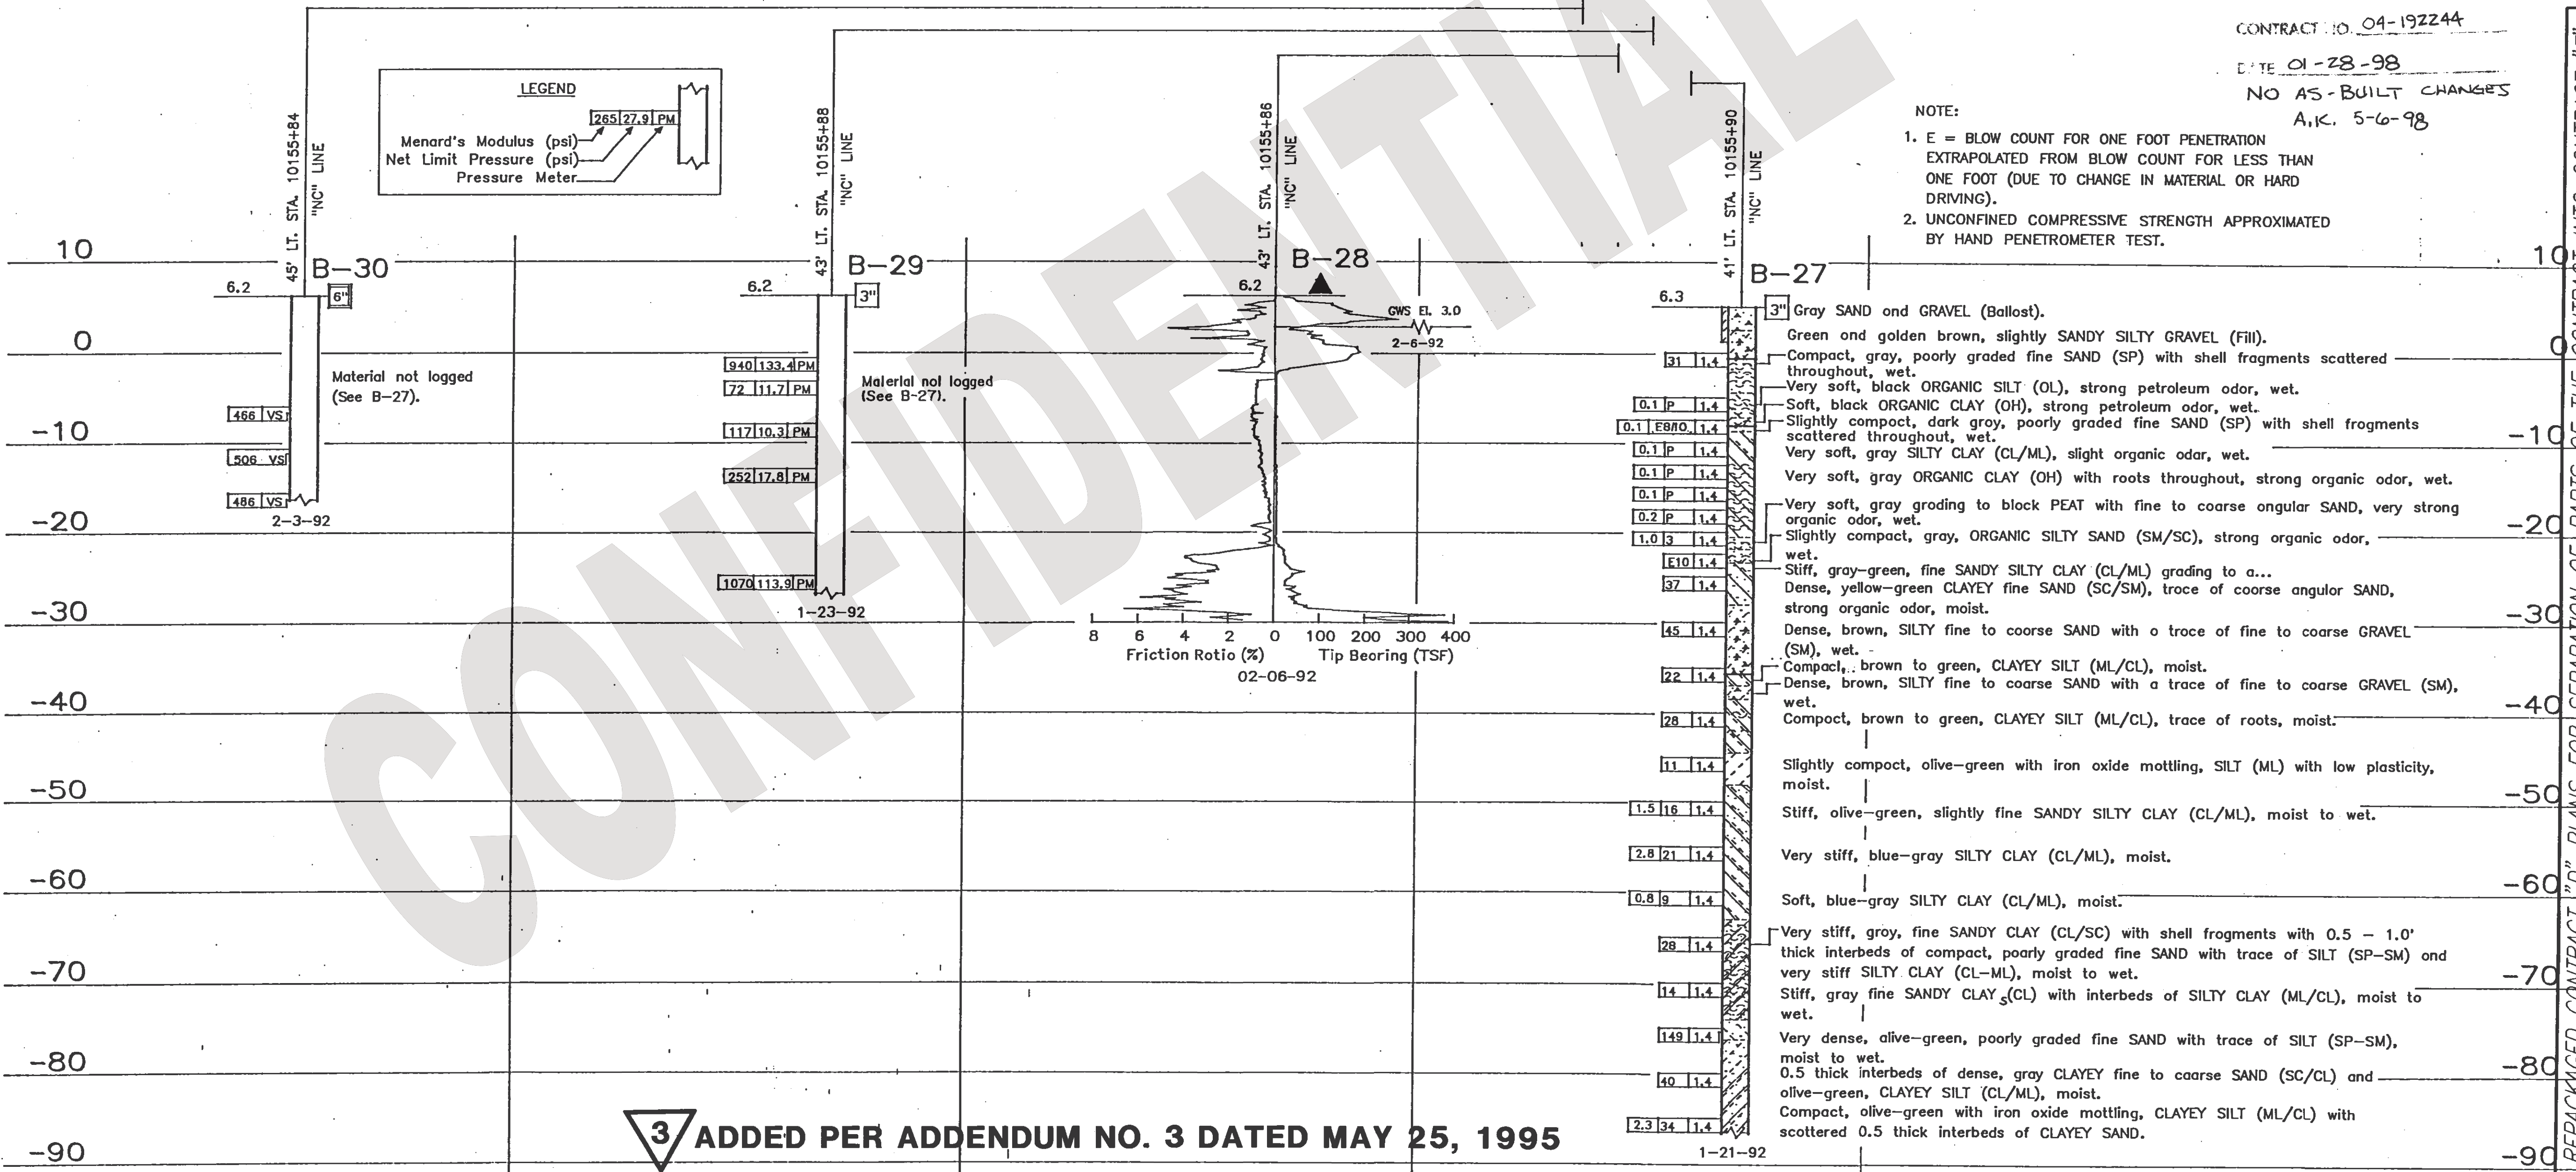

3 ADDED PER ADDENDUM NO. 3 DATED MAY 25, 1995

PROFILE
 HOR. 1" = 5'
 VER. 1" = 10'
 CONTRACT "D"

OFFICE OF TRANSPORTATION MATERIALS & RESEARCH		ENGINEERING GEOLOGY BRANCH		FIELD INVESTIGATION BY: M. WILLIAM		State of CALIFORNIA DEPARTMENT OF TRANSPORTATION		DIVISION OF STRUCTURES STRUCTURE DESIGN		BRIDGE NO. 33-612 E		PORT OF OAKLAND CONN. VIADUCT	
DRAWN BY K. WAHL		5-92								POST MILE		LOG OF TEST BORINGS 7 OF 14	

ORIGINAL SCALE IN INCHES FOR REDUCED PLANS	0	1	2	3	CU 04 EA 192281	DISREGARD PRINTS BEARING EARLIER REVISION DATES	REVISION DATES (PRELIMINARY STAGE ONLY)	SHEET 145 OF 166	85	106
--	---	---	---	---	--------------------	---	---	------------------	----	-----

REPACKAGED CONTRACT "D" PLANS FOR SEPARATION OF PARTS OF THE CONTRACT INTO CONTRACT "F"

APPENDIX C
LIQUEFACTION SETTLEMENT

APPENDIX D
CORROSION TEST RESULTS BY OTHERS

SUMMARY OF CORROSIVITY TEST RESULTS

Sample I.D.	Redox (mV)	pH	Resistivity (100% Saturation) (ohms-cm)	Sulfide (mg/kg)	Chloride (mg/kg)	Sulfate (mg/kg)
H-6 @ 1.5' - 2.0'	480	8.2	1,300 Corrosive	N.D.	91	77
H-9 @ 3.0' - 3.5'	470	8.1	5,900 Moderately Corrosive	N.D.	N.D.	N.D.
H-16 @ 6.0' - 6.5'	460	7.7	1,700 Corrosive	N.D.	58	71
H-17 @ 2.5' - 3.0'	460	8.2	2,500 Moderately Corrosive	N.D.	32	94
H-23 @ 3.5' - 4.0'	460	7.9	240 Severely Corrosive	N.D.	1,500	230
H-28 @ 2.0' - 2.5'	470	7.4	2,300 Moderately Corrosive	N.D.	96	44
H-30 @ 6.0' - 6.5'	460	8.1	1,900 Corrosive	N.D.	25	25
H-37 @ 4.5' - 5.0'	460	7.4	3,000 Moderately Corrosive	N.D.	N.D.	110
H-47 @ 2.5' - 3.0'	450	7.8	5,800 Moderately Corrosive	N.D.	24	43
H-49 @ 1.5' - 2.0'	450	7.5	4,300 Moderately Corrosive	N.D.	N.D.	17
H-55 @ 2.5' - 3.0'	450	7.4	5,000 Moderately Corrosive	N.D.	N.D.	48
H-56 @ 2.5' - 3.0'	440	7.6	7,000 Moderately Corrosive	N.D.	N.D.	23
H-63 @ 5.0' - 5.5'	450	7.9	17,000 Mildly Corrosive	N.D.	N.D.	N.D.
H-69 @ 4.0' - 4.5'	430	8.2	3,000 Moderately Corrosive	N.D.	33	44
T-5 @ 9.0' - 9.5'	270	8.2	220 Severely Corrosive	N.D.	2,800	210
T-11 @ 20.0' - 21.5'	440	8.2	290 Severely Corrosive	N.D.	1,600	230
T-15 @ 20.0 - 20.5'	400	8.4	160 Severely Corrosive	N.D.	2,100	77

N.D. = None Detected

5 October 2011

Job No.1109179
Cust. No.10598

Mr. Steve Tsang
Berlogar Stevens & Associates
5587 Sunol Blvd.
Pleasanton, CA 94566

Subject: Project No.: 3362.200
Project Name: Oakland Army Base
Corrosivity Analysis – ASTM Test Methods with Brief Evaluation

Dear Mr. Tsang:

Pursuant to your request, CERCO Analytical has analyzed the soil samples submitted on September 26, 2011. Based on the analytical results, a brief corrosivity evaluation is enclosed for your consideration.

Based upon the resistivity measurements, Sample No.005 is classified as “severely corrosive”, Samples No.001, No.003 and No.007 are classified as “corrosive” and Samples No.002, No.004 and No.006 are samples are classified as “moderately corrosive”. All buried iron, steel, cast iron, ductile iron, galvanized steel and dielectric coated steel or iron should be properly protected against corrosion depending upon the critical nature of the structure. All buried metallic pressure piping such as ductile iron firewater pipelines should be protected against corrosion.

The chloride ion concentrations range from none detected to 1,500 mg/kg. Because the chloride ion concentrations are greater than 300 mg/kg, they are determined to be sufficient to attack steel embedded in a concrete mortar coating.

The sulfate ion concentrations ranged from none detected to 240 mg/kg and are determined to be sufficient to damage reinforced concrete structures and cement mortar-coated steel at these locations. Therefore, concrete that comes into contact with this soil should use sulfate resistant cement such as Type II, with a maximum water-to-cement ratio of 0.55.

The sulfide ion concentrations reflect none detected with a detected limit of 50 mg/kg.

The pH of the soils ranged from 7.4 to 8.2, which does not present corrosion problems for buried iron, steel, mortar-coated steel and reinforced concrete structures.


Berlogar Stevens & Associates
Job No.1109179
5 October 2011
Page 2 of 2

The redox potentials range from 460 to 480-mV, which are indicative of aerobic soil conditions.

This corrosivity evaluation is based on general corrosion engineering standards and is non-specific in nature. For specific long-term corrosion control design recommendations or consultation, please call *JDH Corrosion Consultants, Inc.* at (925) 927-6630.

We appreciate the opportunity of working with you on this project. If you have any questions, or if you require further information, please do not hesitate to contact us.

Very truly yours,
CERCO ANALYTICAL, INC.

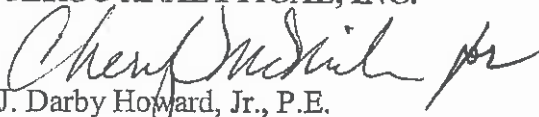
J. Darby Howard, Jr., P.E.
President

JDH/jdl
Enclosure



1100 Willow Pass Court, Suite A
 Concord, CA 94520-1006
 925 462 2771 Fax: 925 462 2775
 www.cercoanalytical.com

Client: Berlogar Stevens & Associates
 Client's Project No.: 3362.200
 Client's Project Name: Oakland Army Base
 Date Sampled: Not Indicated
 Date Received: 26-Sep-11
 Matrix: Soil
 Authorization: Signed Chain of Custody

Date of Report: 5-Oct-2011

Job/Sample No.	Sample I.D.	Redox (mV)	pH	Conductivity (umhos/cm)*	Resistivity (100% Saturation) (ohms-cm)	Sulfide (mg/kg)*	Chloride (mg/kg)*	Sulfate (mg/kg)*
1109179-001	H6 @ 1.5'-2.0'	480	8.2	-	1,300	N.D.	91	77
1109179-002	H9 @ 3.0'-3.5'	470	8.1	-	5,900	N.D.	N.D.	N.D.
1109179-003	H16 @ 6.0'-6.5'	460	7.7	-	1,700	N.D.	58	71
1109179-004	H17 @ 2.5'-3.0'	460	8.2	-	2,500	N.D.	32	94
1109179-005	H23 @ 3.5'-4.0'	460	7.9	-	240	N.D.	1,500	230
1109179-006	H28 @ 2.0'-2.5'	470	7.4	-	2,300	N.D.	96	44
1109179-007	H30 @ 6.0'-6.5'	460	8.1	-	1,900	N.D.	25	25

Method:	ASTM D1498	ASTM D4972	ASTM D1125M	ASTM G57	ASTM D4658M	ASTM D4327	ASTM D4327
Detection Limit:	-	-	10	-	50	15	15
Date Analyzed:	4-Oct-2011	4-Oct-2011	-	29-Sep-2011	30-Sep-2011	3-Oct-2011	3-Oct-2011

Cheryl McMillen
 Laboratory Director

* Results Reported on "As Received" Basis
 N.D. - None Detected

20 October 2011

Job No.1110100
Cust. No.10598

Mr. Steve Tsang
Berlogar Stevens & Associates
5587 Sunol Blvd.
Pleasanton, CA 94566

Subject: Project No.: 3362.200
Project Name: Oakland Army Base
Corrosivity Analysis – ASTM Test Methods with Brief Evaluation

Dear Mr. Tsang:

Pursuant to your request, CERCO Analytical has analyzed the soil samples submitted on October 12, 2011. Based on the analytical results, a brief corrosivity evaluation is enclosed for your consideration.

The following classifications are based upon the resistivity measurement:

	<u>Severely Corrosive</u>	
Sample No.008	Sample No.009	Sample No.010
	<u>Moderately Corrosive</u>	
Sample No.001	Sample No.002	Sample No.003
Sample No.004	Sample No.005	Sample No.007
	<u>Mildly Corrosive</u>	
	Sample No.006	

All buried iron, steel, cast iron, ductile iron, galvanized steel and dielectric coated steel or iron should be properly protected against corrosion depending upon the critical nature of the structure. All buried metallic pressure piping such as ductile iron firewater pipelines should be protected against corrosion.

The chloride ion concentrations range from none detected to 2,800 mg/kg. Because the chloride ion concentrations are more than 300 mg/kg, they are determined to be sufficient to attack steel embedded in a concrete mortar coating.

The sulfate ion concentrations ranged from none detected to 230 mg/kg and are determined to be sufficient to damage reinforced concrete structures and cement mortar-coated steel at these locations. Therefore, concrete that comes into contact with this soil should use sulfate resistant cement such as Type II, with a maximum water-to-cement ratio of 0.55.

Berlogar Stevens
Job No.1110100
20 October 2011
Page 1 of 2

The sulfide ion concentrations reflect none detected with a detection limit of 50 mg/kg.

The pH of the soils ranged from 7.4 to 8.4, which does not present corrosion problems for buried iron, steel, mortar-coated steel and reinforced concrete structures.

The redox potentials ranged from 270 to 460-mV. Sample No.008 is indicative of potentially "slightly corrosive" soils resulting from anaerobic soil conditions, and the remaining samples are indicative of aerobic soil conditions.

This corrosivity evaluation is based on general corrosion engineering standards and is non-specific in nature. For specific long-term corrosion control design recommendations or consultation, please call *JDH Corrosion Consultants, Inc.* at (925) 927-6630.

We appreciate the opportunity of working with you on this project. If you have any questions, or if you require further information, please do not hesitate to contact us.

Very truly yours,
CERCO ANALYTICAL INC.


J. Darby Howard, Jr., P.E.
President

JDH/jdl

Enclosure



1100 Willow Pass Court, Suite A
 Concord, CA 94520-1006
 925 462 2771 Fax. 925 462 2775
 www.cercoanalytical.com

Client: Berlogar Stevens & Associates
 Client's Project No.: 3362.200
 Client's Project Name: Oakland Army Base
 Date Sampled: Not Indicated
 Date Received: 12-Oct-11
 Matrix: Soil
 Authorization: Signed Chain of Custody

Date of Report: 21-Oct-2011

Job/Sample No.	Sample I.D.	Redox (mV)	pH	Conductivity (umhos/cm)*	Resistivity (100% Saturation) (ohms-cm)	Sulfide (mg/kg)*	Chloride (mg/kg)*	Sulfate (mg/kg)*
1110100-001	H-37, 4.5-5.0'	460	7.4	-	3,000	N.D.	N.D.	110
1110100-002	H-47, 2.5-3.0'	450	7.8	-	5,800	N.D.	24	43
1110100-003	H-49, 1.5-2.0'	450	7.5	-	4,300	N.D.	N.D.	17
1110100-004	H-55, 2.5-3.0'	450	7.4	-	5,000	N.D.	N.D.	48
1110100-005	H-56, 2.5-3.0'	440	7.6	-	7,000	N.D.	N.D.	23
1110100-006	H-63, 5.0-5.5'	450	7.9	-	17,000	N.D.	N.D.	N.D.
1110100-007	H-69, 4.0-4.5'	430	8.2	-	3,000	N.D.	33	44
1110100-008	T-5, 9.0-9.5'	270	8.2	-	220	N.D.	2,800	210
1110100-009	T-11, 20.0-21.5'	440	8.2	-	290	N.D.	1,600	230
1110100-010	T-15, 20.0-20.5'	400	8.4	-	160	N.D.	2,100	77

Method:	ASTM D1498	ASTM D4972	ASTM D1125M	ASTM G57	ASTM D4658M	ASTM D4327	ASTM D4327
Detection Limit:	-	-	10	-	50	15	15
Date Analyzed:	18-Oct-2011	17-Oct-2011	-	14-Oct-2011	17-Oct-2011	17-Oct-2011 & 19-Oct-2011	17-Oct-2011

Cheryl McMillen
 Laboratory Director

* Results Reported on "As Received" Basis
 N.D. - None Detected
 (1) Detection limit is elevated to 75 mg/kg due to dilution